

C 1 9867

SEQUENCE NO. (MDE USE ONLY)

STATE OF MARYLAND WELL COMPLETION REPORT

THIS REPORT MUST BE SUBMITTED AFTER WELL IS COMPLETED.

COUNTY NUMBER P 42713

ST/CO USE ONLY DATE Received

DATE WELL COMPLETED

Depth of Well

PERMIT NO. FROM "PERMIT TO DRILL WELL" 170-94-2073

OWNER: Trusted Info Systems, STREET OR RFD: 2960 14 97, TOWN: Glenwood

WELL LOG table with columns: DESCRIPTION, FEET (FROM, TO), check if water bearing. Includes entries like Top Soil, Sandy clay, Silt clay, brown Shale, Sand Stone, Mica, etc.

GROUTING RECORD: WELL HAS BEEN GROUTED (Y), TYPE OF GROUTING MATERIAL (CM, BC), NO. OF BAGS 17, NO. OF POUNDS 700, GALLONS OF WATER 85, DEPTH OF GROUT SEAL 51 ft.

CASING RECORD: MAIN CASING TYPE (ST), Nominal diameter 6, Total depth of main casing 62 ft.

OTHER CASING (if used) table with columns for diameter and depth.

SCREEN RECORD: screen type or open hole (ST, BR, HO), insert appropriate code below.


DEPTH (nearest ft.) table with columns for depth intervals and slot size.

GRAVEL PACK IF WELL DRILLED WAS FLOWING WELL INSERT F IN BOX 68

MDE USE ONLY (NOT TO BE FILLED IN BY DRILLER) (E.R.O.S.) W Q

PUMPING TEST: HOURS PUMPED 3, PUMPING RATE 60 gal. per min., METHOD USED TO MEASURE PUMPING RATE Bucket, WATER LEVEL 5.0 ft. BEFORE PUMPING, 16.0 ft. WHEN PUMPING.

PUMP INSTALLED: DRILLER INSTALLED PUMP YES NO, TYPE OF PUMP INSTALLED (A) air, CAPACITY: GALLONS PER MINUTE 31-35, PUMP HORSE POWER 37-41, PUMP COLUMN LENGTH 43-47.

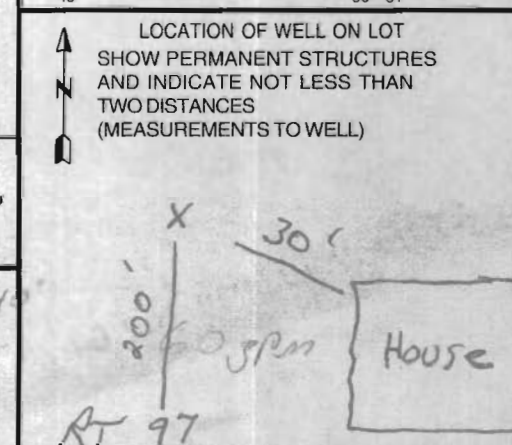

Administrative sections: NUMBER OF UNSUCCESSFUL WELLS, WELL HYDROFRACTURED (Y), CIRCLE APPROPRIATE LETTER (A, E, P), DRILLERS LIC. NO. 1 MWD 040, DRILLERS SIGNATURE, LIC. NO. 1 MWD 501, SITE SUPERVISOR.

B 1 8674

SEQUENCE NO. (MDE USE ONLY)

STATE OF MARYLAND PERMIT TO DRILL WELL

STATE PERMIT NUMBER

HO-94 - 2073

fill in this form completely

Date Received (APA)

8 MM DD YY 13

Glenwood Assoc. 30K 854-6757

OWNER INFORMATION RN 7734 Malcolm Williams

B 3

LOCATION OF WELL

Howard

CC#

8 COUNTY 21

Trusted Info Systems

23 SUBDIVISION 42

SECTION 44 46

LOT 48 50

Glenwood

52 NEAREST TOWN 71

MILES FROM TOWN (enter 0 if in town)

73 76 77 78

DRILLER INFORMATION

George F. Easterday

M VD 040

Driller's Name

76 License No. 81

L. Franklin Easterday, Inc.

Firm Name

9265 Brown Church Rd., MT. Airy, Md. 21771


Address

Signature: George F. Easterday

Date: 1/27/1999

B 4

DIRECTION OF WELL FROM TOWN (CIRCLE BOX)

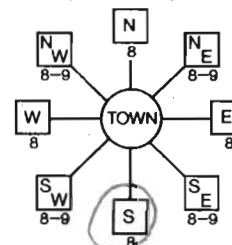

2960 Route 97

11 NEAR WHAT ROAD 30

ON WHICH SIDE OF ROAD (CIRCLE APPROPRIATE BOX)



34 200 37

DISTANCE FROM ROAD

ENTER FT OR MI 38 39

TAX MAP: 14 BLK: 22 PARCEL 171

B 2

WELL INFORMATION

APPROX. PUMPING RATE (GAL. PER MIN.)

5

8 12

AVERAGE DAILY QUANTITY NEEDED (GAL. PER DAY)

500

14 20

USE FOR WATER (CIRCLE APPROPRIATE BOX)

- D DOMESTIC POTABLE SUPPLY & RESIDENTIAL IRRIGATION
F FARMING (LIVESTOCK WATERING & AGRICULTURAL IRRIGATION)
I INDUSTRIAL, COMMERCIAL, DEWATERING
P PUBLIC WATER SUPPLY WELL
T TEST, OBSERVATION, MONITORING
G GEO-THERMAL

NOT TO BE FILLED IN BY DRILLER HEALTH DEPARTMENT APPROVAL

Howard

P 42713

COUNTY NAME

COUNTY NO.

STATE SIGNATURE

INSERT S 41

DATE ISSUED

1-29-99

Kim Maisto

1-29-00

43 MM DD YY 48

CO SIGNATURE

EXP. DATE

NORTH GRID 50 529 000 55

EAST GRID 57 791 000 63

APPROXIMATE DEPTH OF WELL 24 300 28 FEET

APPROXIMATE DIAMETER OF WELL 6 INCH NEAREST

METHOD OF DRILLING (circle one)

BORED (or Augered) JETTED Jetted & DRIVEN

AIR-ROTary AIR-PERcussion ROTARY (Hydraulic Rotary)

CABLE REVerse-ROTary DRive-POINT

other

REPLACEMENT OR DEEPEMED WELLS (CIRCLE APPROPRIATE BOX)

- N THIS WELL WILL NOT REPLACE AN EXISTING WELL
Y THIS WELL WILL REPLACE A WELL THAT WILL BE ABANDONED AND SEALED
S THIS WELL WILL REPLACE A WELL THAT WILL BE USED AS A STANDBY-CONTACT LOCAL APPROVING AUTHORITY FOR POLICY ON STANDBY WELLS
D THIS WELL WILL DEEPEM AN EXISTING WELL

PERMIT NUMBER OF WELL TO BE REPLACED OR DEEPEMED (IF AVAILABLE) 41

Not to be filled in by driller (MDE OR COUNTY USE ONLY)

APPROX. PERMIT NUMBER 54 GAP 63

PERMIT No. HO-94-2073

SPECIAL CONDITIONS

NOTE - APPROVING AUTHORITIES SHOULD USE SEPARATE SHEET IF NEEDED

SHOW MAJOR FEATURES OF BOX & LOCATE WELL WITH AN X

SOURCES OF DRILLING WATER

- 1. wells
2.
3.

WRITE THE BOX NUMBER FROM THE MAP HERE

E 791

N 529

2-17-99
Groot 8:45
NO INSP

DRAW A SKETCH BELOW SHOWING LOCATION OF WELL IN RELATION TO NEARBY TOWNS AND ROADS AND GIVE DISTANCE FROM WELL TO NEAREST ROAD JUNCTION

N



MAP 9 B6
Glenwood

~~1-14-99~~ 1-19-99
1:30 11:00 (meet driller)
OWNER: Trusted Information Systems

DATE REQUESTED: 1-13-99

ADDRESS: 2960 Route 97
Glenwood, MD


DRILLER: Easterday

WELL TAG # _____

COUNTY # Howard (13)

PROPOSAL: Replacement Well Site

LOCATION DIAGRAM

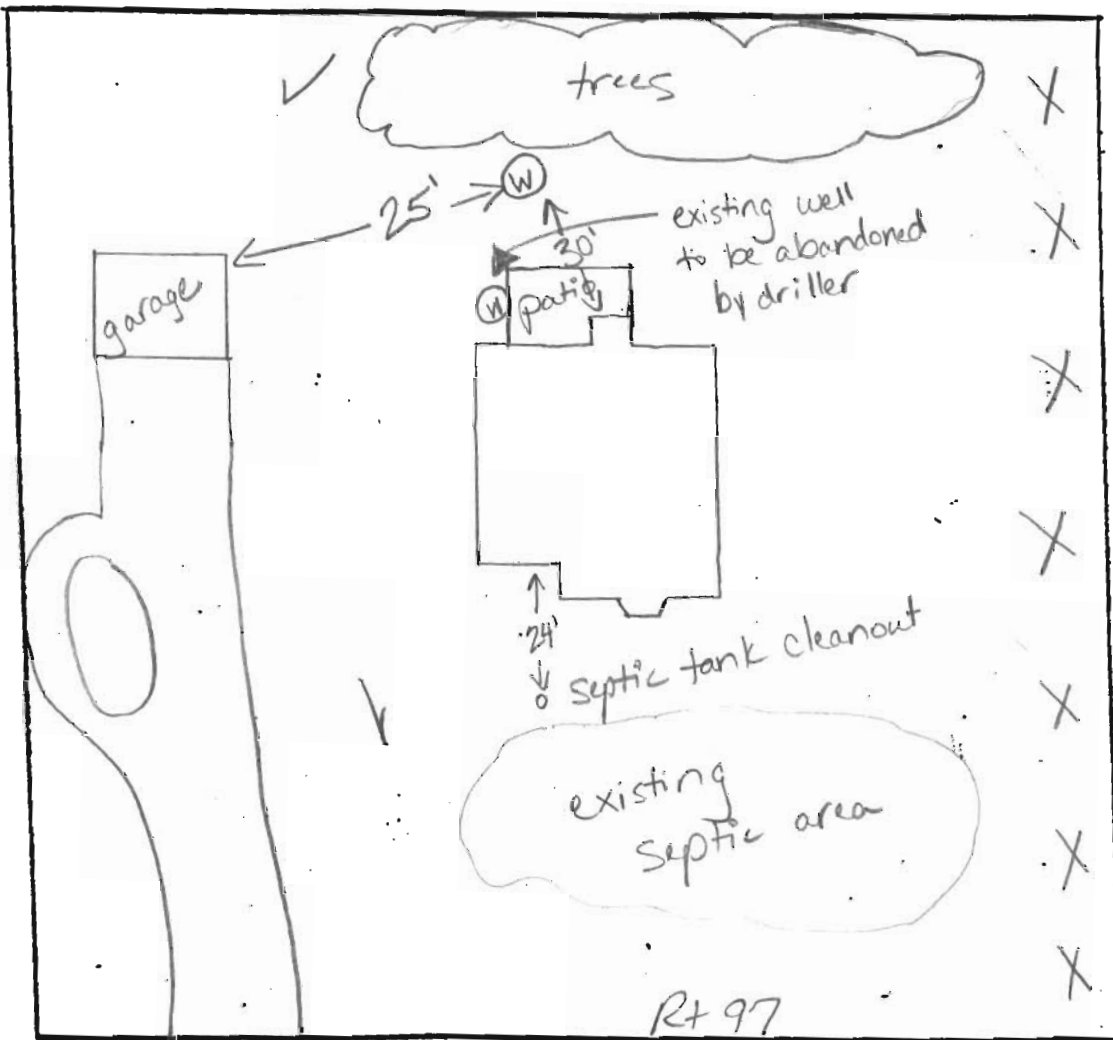

COMMENTS: 1-29-99 Replacement well site ok as staked, existing well to be abandoned by driller.

DATE: 1-29-99

INSPECTOR: Kim Maiste

Address

Telephone

T/c msg. left

@ Glenwood

Assoc. for
Malcolm Williams

I COP sampling
requested

MR 3/27/99