

\*\*\*\*\*  
WATER WELL ABANDONMENT-SEALING REPORT FORM  
\*\*\*\*\*

**SUBMIT COPIES OF COMPLETED FORM TO:**

- \* COUNTY ENVIRONMENTAL AGENCY (contact MDE, WMA if address needed)
- \* WELL OWNER
- \* MDE, WATER MANAGEMENT ADMINISTRATION, WELL PROGRAM

APPROVED  
10/16/2009  
(Signature)

DATE WELL ABANDONED: 4/2/16 (month/day/year)

\* PERMIT NUMBER OF ABANDONED WELL (if any) No Tag


\* PERMIT NUMBER OF REPLACEMENT WELL: \_\_\_\_\_

\* PERSON ABANDONING WELL: C John Hess WELL DRILLER'S LICENSE NUMBER: 553

\* OWNER'S NAME: Jim Capell CIRCLE: MWD / MSD / MGD

\* WELL LOCATION:  
COUNTY: Howard  
NEAREST TOWN: Flick Ridge, MD  
TAX MAP \_\_\_\_\_ BLOCK \_\_\_\_\_ PARCEL \_\_\_\_\_  
SUBDIVISION: \_\_\_\_\_  
SECTION: \_\_\_\_\_ LOT: \_\_\_\_\_  
STREET ADDRESS: 7521 Montverde Rd

SITE LOCATION MAP

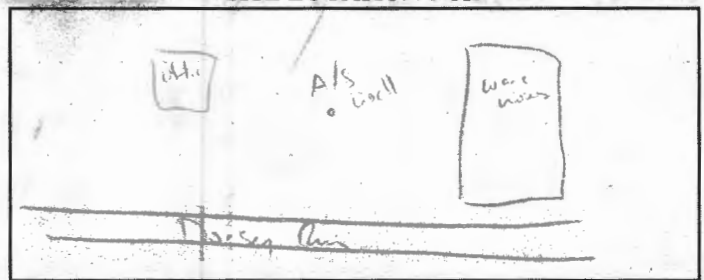

LATITUDE 3 9.165239

LONGITUDE 7 6.768259

LOG OF SEALING MATERIAL

MATERIAL	FEET	
	FROM	TO
Bentonite	112	7
Gravel	7	3
Drill	3	0
VOLUME OF MATERIAL USED		
Bentonite (30 Bags), Portland (1 Bag)		

\* TYPE OF WELL BEING ABANDONED:  
 DRILLED \_\_\_\_\_ JETTED \_\_\_\_\_  
 BORED \_\_\_\_\_ HAND DUG \_\_\_\_\_  
 OTHER (specify) \_\_\_\_\_

\* USE CODE:  
 DOMESTIC \_\_\_\_\_ MUNICIPAL/PUBLIC \_\_\_\_\_  
 IRRIGATION \_\_\_\_\_ INDUSTRIAL \_\_\_\_\_  
 TEST/OBSERVATION \_\_\_\_\_ GEOTHERMAL \_\_\_\_\_

\* TYPE OF CASING:  
 STEEL \_\_\_\_\_ PLASTIC \_\_\_\_\_  
 CONCRETE \_\_\_\_\_ OTHER (specify) \_\_\_\_\_

SIZE OF CASING: 6 INCHES IN DIAMETER

DEPTH OF WELL: 112 FEET DEEP

WAS ANY CASING REMOVED?  YES \_\_\_\_\_ NO  
If yes, length removed, in feet: 2

WAS CASING RIPPED OR PERFORATED? \_\_\_\_\_ YES  NO

SIGNATURE: John Hess MASTER WELL DRILLER OR SUPERVISING SANITARIAN LICENSE#

553

MWD / MSD / MGS  
CIRCLE ONE

4/2/16  
DATE

COUNTY

Pursuant to § 10-624 of the State Govt. Article of the Maryland Code, personal info requested on this form is used in processing this form pursuant to COMAR 26.04.04. Failure to provide the info may result in this form not being processed. You have the right to inspect, amend, or correct this form. The Maryland Department of the Environment is subject to the Maryland Public Information Act. This form may be made available on the Internet via MDE's website and is subject to inspection or copying, in whole or in part, by the public and other governmental agencies, if not protected by federal or State Law.

## Real Property Data Search

## Search Result for HOWARD COUNTY

<a href="#">View Map</a>	<a href="#">View GroundRent Redemption</a>	<a href="#">View GroundRent Registration</a>
<b>Special Tax Recapture:</b> None		
<b>Account Identifier:</b> District - 01 Account Number - 181238		
Owner Information		
<b>Owner Name:</b>	CROSSROADS ROCK LLC	<b>Use:</b> COMMERCIAL
		<b>Principal Residence:</b> NO
<b>Mailing Address:</b>	6800 DEERPATH RD STE 100 ELKRIDGE MD 21075-6253	<b>Deed Reference:</b> /10952/ 00590
Location & Structure Information		
<b>Premises Address:</b>	7525 MONTEVIDEO RD JESSUP 20794-0000	<b>Legal Description:</b> 1.8694 A. 7525 MONTEVIDEO RD JESSUP
<b>Map:</b>	<b>Grid:</b>	<b>Parcel:</b>
0043	0016	0586
<b>Neighborhood:</b>	<b>Subdivision:</b>	<b>Section:</b>
30000.14	0000	
<b>Block:</b>	<b>Lot:</b>	<b>Assessment Year:</b>
		2018
<b>Plat No:</b>	<b>Plat Ref:</b>	
<b>Town:</b> None		
<b>Primary Structure Built</b>	<b>Above Grade Living Area</b>	<b>Finished Basement Area</b>
		<b>Property Land Area</b>
		1.8694 AC
<b>County Use</b>		
<b>Stories</b>	<b>Basement</b>	<b>Type</b>
		<b>Exterior</b>
		<b>Quality</b>
		<b>Full/Half Bath</b>
		<b>Garage</b>
		<b>Last Notice of Major Improvements</b>
		/
Value Information		
	<b>Base Value</b>	<b>Value</b>
		<b>Phase-in Assessments</b>
		As of
		As of
		As of
<b>Land:</b>	295,200	295,200
<b>Improvements</b>	0	0
<b>Total:</b>	295,200	295,200
<b>Preferential Land:</b>	0	0
		295,200
		295,200
Transfer Information		
<b>Seller:</b> RCH ASSOCIATES LLC	<b>Date:</b> 11/01/2007	<b>Price:</b> \$925,000
<b>Type:</b> ARMS LENGTH VACANT	<b>Deed1:</b> /10952/ 00590	<b>Deed2:</b>
<b>Seller:</b> HOCK JOSEPH J INC	<b>Date:</b> 12/22/2000	<b>Price:</b> \$150,000
<b>Type:</b> ARMS LENGTH VACANT	<b>Deed1:</b> /05295/ 00164	<b>Deed2:</b>
<b>Seller:</b> COLONIAL DUMP SER INC	<b>Date:</b> 04/22/1982	<b>Price:</b> \$76,735
<b>Type:</b> ARMS LENGTH IMPROVED	<b>Deed1:</b> /01098/ 00418	<b>Deed2:</b>
Exemption Information		
<b>Partial Exempt Assessments:</b>	<b>Class</b>	
<b>County:</b>	000	07/01/2019
<b>State:</b>	000	0.00
<b>Municipal:</b>	000	0.00
		0.00 0.00
		0.00 0.00
<b>Special Tax Recapture:</b> None		
Homestead Application Information		
<b>Homestead Application Status:</b> No Application		
Homeowners' Tax Credit Application Information		
<b>Homeowners' Tax Credit Application Status:</b> No Application		
<b>Date:</b>		