

\*\*\*\*\*  
 WATER WELL ABANDONMENT-SEALING REPORT FORM  
 \*\*\*\*\*

**SUBMIT COPIES OF COMPLETED FORM TO:**

- \* COUNTY ENVIRONMENTAL AGENCY (contact MDE, WMA if address needed)
- \* WELL OWNER
- \* MDE, WATER MANAGEMENT ADMINISTRATION, WELL PROGRAM

APPROVED  
 (Signature) 6/27/2019

DATE WELL ABANDONED: 3-20-18 (month/day/year)

\* PERMIT NUMBER OF ABANDONED WELL (if any) N/A

\* PERMIT NUMBER OF REPLACEMENT WELL: N/A


\* PERSON ABANDONING WELL: BRET SWEENEY WELL DRILLER'S LICENSE NUMBER: 257

CIRCLE: MWD / MSD / MGD

\* OWNER'S NAME: Evergreen Breweries Co. LLC

SITE LOCATION MAP

\* WELL LOCATION:  
 COUNTY: Howard  
 NEAREST TOWN: Ellicott City  
 TAX MAP 30 BLOCK 03 PARCEL 368  
 SUBDIVISION:  
 SECTION: LOT: 16  
 STREET ADDRESS: 9692 Oak Hill Dr

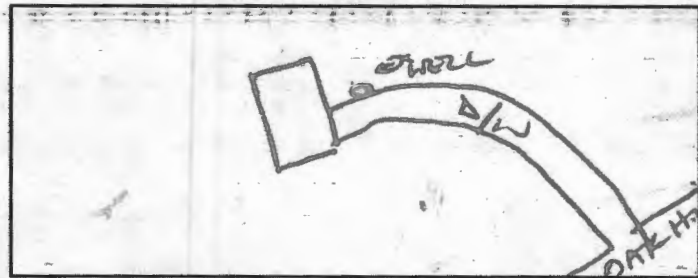

LATITUDE 39.245088

LONGITUDE 76.849336

LOG OF SEALING MATERIAL

MATERIAL	FEET	
	FROM	TO
<u>TOPSOIL</u>	<u>0</u>	<u>2</u>
<u>BENTONITE</u>	<u>2</u>	<u>54</u>
VOLUME OF MATERIAL USED		
<u>22 BAGS HOLE PLUG</u>		

\* TYPE OF WELL BEING ABANDONED:  
 DRILLED  JETTED  
 BORED  HAND DUG  
 OTHER (specify) \_\_\_\_\_

\* USE CODE:  
 DOMESTIC  MUNICIPAL/PUBLIC  
 IRRIGATION  INDUSTRIAL  
 TEST/OBSERVATION  GEOTHERMAL

\* TYPE OF CASING:  
 STEEL  PLASTIC  
 CONCRETE  OTHER (specify) \_\_\_\_\_

SIZE OF CASING: 6 INCHES IN DIAMETER

DEPTH OF WELL: 54 FEET DEEP

WAS ANY CASING REMOVED?  YES  NO  
 If yes, length removed, in feet: 3

WAS CASING RIPPED OR PERFORATED?  YES  NO

SIGNATURE-MASTER WELL DRILLER OR SUPERVISING SANITARIAN LICENSE# 237

MWD / MSD / MGS  
 CIRCLE ONE

3/25/19 (Signature) (Date)

COUNTY

Pursuant to § 10-624 of the State Govt. Article of the Maryland Code, personal info requested on this form is used in processing this form pursuant to COMAR 26.04.04. Failure to provide the info may result in this form not being processed. You have the right to inspect, amend, or correct this form. The Maryland Department of the Environment is subject to the Maryland Public Information Act. This form may be made available on the Internet via MDE's website and is subject to inspection or copying, in whole or in part, by the public and other governmental agencies, if not protected by federal or State Law.