

WATER WELL ABANDONMENT-SEALING REPORT FORM

SUBMIT COPIES OF COMPLETED FORM TO:

- * COUNTY ENVIRONMENTAL AGENCY (contact MDE, WMA if address needed)
- * WELL OWNER
- * MDE, WATER MANAGEMENT ADMINISTRATION, WELL PROGRAM

APPROVED
 10/16/2019
(Signature)

DATE WELL ABANDONED: 12-17-18 (month/day/year)


* PERMIT NUMBER OF ABANDONED WELL (if any) _____

* PERMIT NUMBER OF REPLACEMENT WELL: _____

* PERSON ABANDONING WELL: Lester Summers Sr WELL DRILLER'S LICENSE NUMBER: 307
 CIRCLE: MWD / MSD / MGD

* OWNER'S NAME: Heidi Most

SITE LOCATION MAP

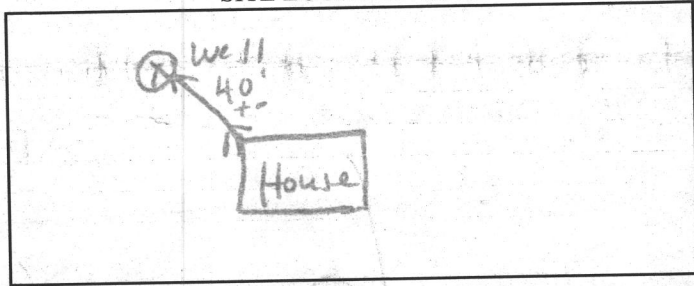

* WELL LOCATION:
 COUNTY: Howard
 NEAREST TOWN: ELLICOTT CITY
 TAX MAP _____ BLOCK _____ PARCEL _____
 SUBDIVISION: _____
 SECTION: _____ LOT: _____
 STREET ADDRESS: 3121 EVERGREEN Way

LATITUDE 3 9.285023
 LONGITUDE 7 6.926090

LOG OF SEALING MATERIAL

MATERIAL	FEET	
	FROM	TO
Bentonite Back fill	500	2
	2	0
VOLUME OF MATERIAL USED		
<u>1500 # Bentonite mixed w/ slurry</u>		

* TYPE OF WELL BEING ABANDONED:
 DRILLED _____ JETTED
 _____ BORED _____ HAND DUG
 _____ OTHER (specify) _____

* USE CODE:
 DOMESTIC _____ MUNICIPAL/PUBLIC
 _____ IRRIGATION _____ INDUSTRIAL
 _____ TEST/OBSERVATION _____ GEOTHERMAL

* TYPE OF CASING:
 STEEL _____ PLASTIC
 _____ CONCRETE _____ OTHER (specify) _____

SIZE OF CASING: 6 INCHES IN DIAMETER

DEPTH OF WELL: 500 FEET DEEP

WAS ANY CASING REMOVED? YES _____ NO
 If yes, length removed, in feet: 2

WAS CASING RIPPED OR PERFORATED? _____ YES NO

Seany F. Eastenbury 040
 SIGNATURE-MASTER WELL DRILLER OR SUPERVISING SANITARIAN LICENSE#

MWD / MSD / MGS 12-21-18
 CIRCLE ONE DATE

COUNTY

Pursuant to § 10-624 of the State Govt. Article of the Maryland Code, personal info requested on this form is used in processing this form pursuant to COMAR 26.04.04. Failure to provide the info may result in this form not being processed. You have the right to inspect, amend, or correct this form. The Maryland Department of the Environment is subject to the Maryland Public Information Act. This form may be made available on the Internet via MDE's website and is subject to inspection or copying, in whole or in part, by the public and other governmental agencies, if not protected by federal or State Law.

Real Property Data Search (w3)

Search Result for HOWARD COUNTY

View Map	View GroundRent Redemption	View GroundRent Registration
--------------------------	--	--

Tax Exempt: None
 Exempt Class: None
 Special Tax Recapture: None

Account Identifier: District - 03 Account Number - 280381

Owner Information

Owner Name: HAYEK CARLETON S
 MOST HEIDI B
 Mailing Address: 3121 EVERGREEN WAY
 ELLICOTT CITY MD 21042-1023
 Use: RESIDENTIAL
 Principal Residence: YES
 Deed Reference: /02265/ 00531

Location & Structure Information

Premises Address: 3121 EVERGREEN WAY
 ELLICOTT CITY 21042-0000
 Legal Description: LOT 31 S 6
 3121 EVERGREEN WAY E S
 EVERGREEN VLY EST

Map:	Grid:	Parcel:	Neighborhood:	Subdivision:	Section:	Block:	Lot:	Assessment Year:	Plat No:
0023	0002	0092	3020202.14	2022			31	2019	Plat Ref:

Special Tax Areas: None
 Town: None
 Ad Valorem: 100
 Tax Class: None

Primary Structure Built	Above Grade Living Area	Finished Basement Area	Property Land Area	County Use
1971	2,881 SF		1.3500 AC	

Stories	Basement	Type	Exterior	Quality	Full/Half Bath	Garage	Last Notice of Major Improvements
2	YES	STANDARD UNIT	1/2 BRICK FRAME/ FRAME	4	3 full/ 1 half	1 Attached	

Value Information

	Base Value	Value As of 01/01/2019	Phase-in Assessments As of 07/01/2019	As of 07/01/2020
Land:	204,300	243,500		
Improvements	281,700	271,500		
Total:	486,000	515,000	495,667	505,333
Preferential Land:	0			0

Transfer Information

Seller: BERME L VINCENT A & WF Type: ARMS LENGTH IMPROVED	Date: 11/29/1990 Deed1: /02265/ 00531	Price: \$208,000 Deed2:
Seller:	Date:	Price:
Type:	Deed1:	Deed2:
Seller:	Date:	Price:
Type:	Deed1:	Deed2:

Exemption Information

Partial Exempt Assessments:	Class	07/01/2019	07/01/2020
County:	000	0.00	
State:	000	0.00	
Municipal:	000	0.00 0.00	0.00 0.00

Tax Exempt: None
 Exempt Class: None
 Special Tax Recapture: None

Homestead Application Information

Homestead Application Status: Approved 01/26/2010

Homeowners' Tax Credit Application Information

Homeowners' Tax Credit Application Status: No Application

Date:

1. This screen allows you to search the Real Property database and display property records.
2. Click **here** for a glossary of terms.
3. Deleted accounts can only be selected by Property Account Identifier.
4. The following pages are for information purpose only. The data is not to be used for legal reports or documents. While we have confidence in the accuracy of these records, the Department makes no warranties, expressed or implied, regarding the information.