
 WATER WELL ABANDONMENT-SEALING REPORT FORM

SUBMIT COPIES OF COMPLETED FORM TO:

- * COUNTY ENVIRONMENTAL AGENCY (contact MDE, WMA if address needed)
- * WELL OWNER
- * MDE, WATER MANAGEMENT ADMINISTRATION, WELL PROGRAM

APPROVED
 10/16/2019
 (Signature)

DATE WELL ABANDONED: APRIL 19, 2019 (month/day/year)

* PERMIT NUMBER OF ABANDONED WELL (if any) _____


* PERMIT NUMBER OF REPLACEMENT WELL: _____

* PERSON ABANDONING WELL: Bruce Thompson WELL DRILLER'S LICENSE NUMBER: ISD 038

* OWNER'S NAME: Howard County CIRCLE: MWD / MSD / MGD

* WELL LOCATION:
 COUNTY: Howard
 NEAREST TOWN: ELK RIDGE
 TAX MAP _____ BLOCK _____ PARCEL _____
 SUBDIVISION: _____
 SECTION: _____ LOT: _____
 STREET ADDRESS: 6555 Belmont Woods Rd

SITE LOCATION MAP

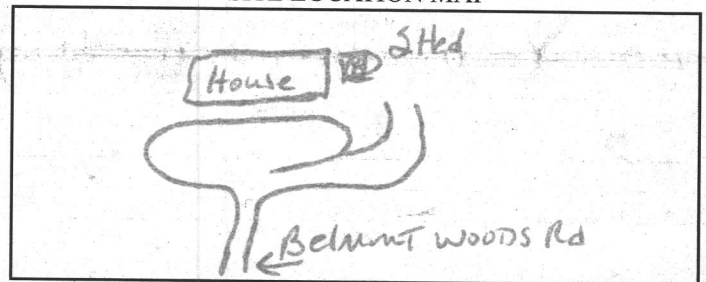

LATITUDE 3 9.226187

LONGITUDE 7 6.744952

LOG OF SEALING MATERIAL

MATERIAL	FEET	
	FROM	TO
Bentonite	135	4
PIT	4	0

VOLUME OF MATERIAL USED

750# mixed As slurry

* TYPE OF WELL BEING ABANDONED:
 DRILLED JETTED
 BORED HAND DUG
 OTHER (specify) _____

* USE CODE:
 DOMESTIC MUNICIPAL/PUBLIC
 IRRIGATION INDUSTRIAL
 TEST/OBSERVATION GEOTHERMAL

* TYPE OF CASING:
 STEEL PLASTIC
 CONCRETE OTHER (specify) _____

SIZE OF CASING: 6 INCHES IN DIAMETER

DEPTH OF WELL: 135 FEET DEEP

WAS ANY CASING REMOVED? YES NO
 If yes, length removed, in feet: _____

WAS CASING RIPPED OR PERFORATED? YES NO

Sevy F. Esterday 040
 SIGNATURE-MASTER WELL DRILLER OR SUPERVISING SANITARIAN LICENSE#

MWD / MSD / MGS

CIRCLE ONE

DATE

COUNTY



Pursuant to § 10-624 of the State Govt. Article of the Maryland Code, personal info requested on this form is used in processing this form pursuant to COMAR 26.04.04. Failure to provide the info may result in this form not being processed. You have the right to inspect, amend, or correct this form. The Maryland Department of the Environment is subject to the Maryland Public Information Act. This form may be made available on the Internet via MDE's website and is subject to inspection or copying, in whole or in part, by the public and other governmental agencies, if not protected by federal or State Law.

Real Property Data Search (w3)

Search Result for HOWARD COUNTY

View Map		View GroundRent Redemption			View GroundRent Registration					
Tax Exempt: None		Special Tax Recapture: None								
Exempt Class: None										
Account Identifier:		District - 01 Account Number - 180495								
Owner Information										
Owner Name:	HOWARD COUNTY MD DEPARTMENT OF PUBLIC WORKS			Use:	EXEMPT COMMERCIAL					
Mailing Address:	3430 COURT HOUSE DR ELLCOTT CITY MD 21043-			Principal Residence:	NO					
				Deed Reference:	/14129/ 00538					
Location & Structure Information										
Premises Address:	6555 BELMONT WOODS RD ELKRIDGE 21075-0000			Legal Description:	68.888 A. 6555 BELMONT WOODS RD BELMONT CENTER					
Map:	Grid:	Parcel:	Neighborhood:	Subdivision:	Section:	Block:	Lot:	Assessment Year:	Plat No:	
0032	0019	0002	30000.14	0000				2018	Plat Ref: 22875	
Special Tax Areas: None				Town:	None					
				Ad Valorem:	103					
				Tax Class:	None					
Primary Structure Built	Above Grade Living Area		Finished Basement Area		Property Land Area		County Use			
1985	18,177 SF				68.8880 AC					
Stories	Basement	Type	Exterior	Quality	Full/Half Bath	Garage	Last Notice of Major Improvements			
		MULTI-PURPOSE SCHOOL BUILDING	/	C3						
Value Information										
	Base Value		Value		Phase-in Assessments					
			As of		As of		As of			
			01/01/2018		07/01/2019		07/01/2020			
Land:	5,403,100		5,403,100							
Improvements	623,000		623,200							
Total:	6,026,100		6,026,300		6,026,233		6,026,300			
Preferential Land:	0						0			
Transfer Information										
Seller: HOWARD COMMUNITY COLLEGE			Date: 07/09/2012			Price: \$2,700,000				
Type: ARMS LENGTH MULTIPLE			Deed1: /14129/ 00538			Deed2:				
Seller: THE HOWARD COMMUNITY COLLEGE			Date: 11/18/2008			Price: \$4,431,900				
Type: NON-ARMS LENGTH OTHER			Deed1: /11412/ 00419			Deed2:				
Seller: AMERICAN CHEMICAL SOCIETY			Date: 11/23/2004			Price: \$4,800,000				
Type: ARMS LENGTH IMPROVED			Deed1: /08797/ 00298			Deed2:				
Exemption Information										
Partial Exempt Assessments:	Class		07/01/2019		07/01/2020					
County:	500		6,026,233.00		6,026,300.00					
State:	500		6,026,233.00		6,026,300.00					
Municipal:	500		0.00 0.00		0.00 0.00					
Tax Exempt: None		Special Tax Recapture: None								
Exempt Class: None										
Homestead Application Information										
Homestead Application Status: No Application										
Homeowners' Tax Credit Application Information										

Homeowners' Tax Credit Application Status: No Application**Date:**

1. This screen allows you to search the Real Property database and display property records.
2. Click **here** for a glossary of terms.
3. Deleted accounts can only be selected by Property Account Identifier.
4. The following pages are for information purpose only. The data is not to be used for legal reports or documents. While we have confidence in the accuracy of these records, the Department makes no warranties, expressed or implied, regarding the information.