
 WATER WELL ABANDONMENT-SEALING REPORT FORM

SUBMIT COPIES OF COMPLETED FORM TO:

- * COUNTY ENVIRONMENTAL AGENCY (contact MDE, WMA if address needed)
- * WELL OWNER
- * MDE, WATER MANAGEMENT ADMINISTRATION, WELL PROGRAM

APPROVED
 10/16/2017


DATE WELL ABANDONED: 2-16-18 (month/day/year)

* PERMIT NUMBER OF ABANDONED WELL (if any) _____
 * PERMIT NUMBER OF REPLACEMENT WELL: _____

* PERSON ABANDONING WELL: ROBERT COPSEY WELL DRILLER'S LICENSE NUMBER: 161
 * OWNER'S NAME: HESTER = Gladys Rocha CIRCLE: MWD/MSD/MGD

* WELL LOCATION:
 COUNTY: HOWARD
 NEAREST TOWN: Columbia
 TAX MAP 0029 BLOCK _____ PARCEL 0033
 SUBDIVISION: 0000
 SECTION: _____ LOT: _____
 STREET ADDRESS: 10483 ROUTE 108 Columbia

SITE LOCATION MAP

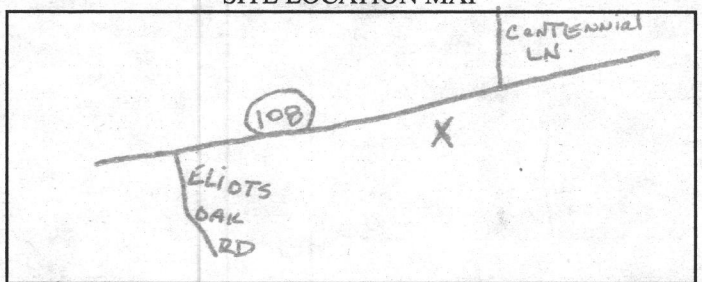

LATITUDE 3 9 . 1 4 0 7 0 7
 LONGITUDE 7 6 . 5 2 3 0 6 2

LOG OF SEALING MATERIAL

MATERIAL	FEET	
	FROM	TO
<u>Bentonite clay</u>	<u>81</u>	<u>5</u>

- * TYPE OF WELL BEING ABANDONED:
 DRILLED JETTED
 BORED HAND DUG
 OTHER (specify) _____
- * USE CODE:
 DOMESTIC MUNICIPAL/PUBLIC
 IRRIGATION INDUSTRIAL
 TEST/OBSERVATION GEOTHERMAL

VOLUME OF MATERIAL USED

1040 lbs 3/8 Bariod Hole plug

- * TYPE OF CASING:
 STEEL PLASTIC
 CONCRETE OTHER (specify) _____

SIZE OF CASING: 6" INCHES IN DIAMETER

DEPTH OF WELL: 81 FEET DEEP

WAS ANY CASING REMOVED? YES NO
 If yes, length removed, in feet: _____

WAS CASING RIPPED OR PERFORATED? YES NO

Robert P. Copsy 161
 SIGNATURE-MASTER WELL DRILLER OR SUPERVISING SANITARIAN LICENSE#

MWD / MSD / MGS 2/16/18
 CIRCLE ONE DATE



Pursuant to § 10-624 of the State Govt. Article of the Maryland Code, personal info requested on this form is used in processing this form pursuant to COMAR 26.04.04. Failure to provide the info may result in this form not being processed. You have the right to inspect, amend, or correct this form. The Maryland Department of the Environment is subject to the Maryland Public Information Act. This form may be made available on the Internet via MDE's website and is subject to inspection or copying, in whole or in part, by the public and other governmental agencies, if not protected by federal or State Law.

Real Property Data Search (w3)

Search Result for HOWARD COUNTY

View Map		View GroundRent Redemption			View GroundRent Registration				
Tax Exempt: None		Special Tax Recapture: None							
Exempt Class: None									
Account Identifier:		District - 05 Account Number - 359155							
Owner Information									
Owner Name:		ROCHA HECTOR I ROCHA GLADYS			Use: Principal Residence:		RESIDENTIAL NO		
Mailing Address:		13125 BRIGHTON DAM RD CLARKSVILLE MD 21029-			Deed Reference:		/17668/ 00328		
Location & Structure Information									
Premises Address:		10483 ROUTE 108 COLUMBIA 21044-0000			Legal Description:		1 ACRE 10483 ROUTE 108		
Map:	Grid:	Parcel:	Neighborhood:	Subdivision:	Section:	Block:	Lot:	Assessment Year:	Plat No:
0029	0012	0033	5030303.14	3003				2020	Plat Ref:
Special Tax Areas: None					Town:		None		
					Ad Valorem:		101		
					Tax Class:		None		
Primary Structure Built		Above Grade Living Area		Finished Basement Area		Property Land Area		County Use	
1955		1,006 SF				1.0000 AC			
Stories	Basement	Type	Exterior	Quality	Full/Half Bath	Garage	Last Notice of Major Improvements		
1	YES	STANDARD UNIT	BRICK/	4	1 full				
Value Information									
		Base Value		Value		Phase-in Assessments			
				As of		As of		As of	
				01/01/2017		07/01/2019		07/01/2020	
Land:		225,000		225,000					
Improvements		69,000		69,000					
Total:		294,000		294,000		294,000			
Preferential Land:		0							
Transfer Information									
Seller: MARTIN STANLEY D			Date: 06/28/2017			Price: \$338,500			
Type: ARMS LENGTH IMPROVED			Deed1: /17668/ 00328			Deed2:			
Seller:			Date:			Price: \$0			
Type:			Deed1: /00272/ 00523			Deed2:			
Seller:			Date:			Price:			
Type:			Deed1:			Deed2:			
Exemption Information									
Partial Exempt Assessments:		Class		07/01/2019		07/01/2020			
County:		000		0.00					
State:		000		0.00					
Municipal:		000		0.00		0.00			
Tax Exempt: None		Special Tax Recapture: None							
Exempt Class: None									
Homestead Application Information									
Homestead Application Status: No Application									

Homeowners' Tax Credit Application Status: No Application**Date:**

1. This screen allows you to search the Real Property database and display property records.
2. Click **here** for a glossary of terms.
3. Deleted accounts can only be selected by Property Account Identifier.
4. The following pages are for information purpose only. The data is not to be used for legal reports or documents. While we have confidence in the accuracy of these records, the Department makes no warranties, expressed or implied, regarding the information.