
 WATER WELL ABANDONMENT-SEALING REPORT FORM

SUBMIT COPIES OF COMPLETED FORM TO:

- * COUNTY ENVIRONMENT AGENCY (contact MDE, WMA if address needed)
- * WELL OWNER
- * MDE, WATER MANAGEMENT ADMINISTRATION, WELL PROGRAM

DATE WELL ABANDONED: 3/3/08 (month/day/year)

* PERMIT NUMBER OF ABANDONED WELL (if any)

H0 - 94 - 4016

* PERMIT NUMBER OF REPLACEMENT WELL

* PERSON ABANDONING WELL: Richard A. Crummitt


WELL DRILLERS LICENSE NUMBER: WR0014

CIRCLE: MWD/MSD/MGD

* OWNER'S NAME: HOWARD CO Schools

SITE LOCATION MAP

* WELL LOCATION:
 COUNTY: Howard
 NEAREST TOWN: Glenwood Middle School
 TAX MAP _____ BLOCK _____ PARCEL _____
 SUBDIVISION: _____
 SECTION: _____ LOT: _____
 NEAREST ROAD: 2680 Route 97

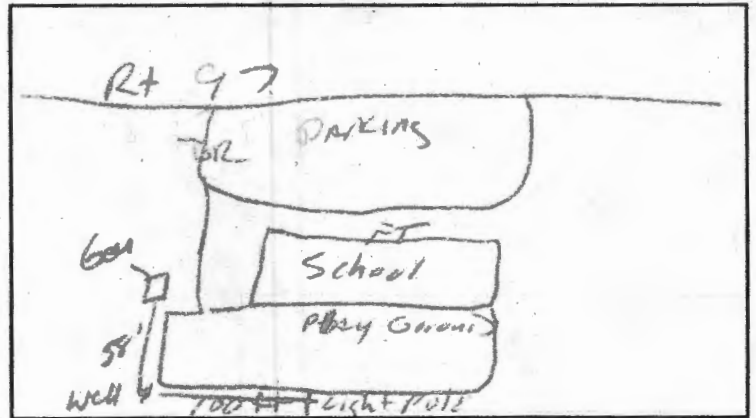

* TYPE OF WELL BEING ABANDONED:

- DRILLED JETTED
- BORED/AUGERED HAND DUG
- OTHER (specify) _____

LOG OF SEALING MATERIAL

MATERIAL	FEET	
	FROM	TO
Gravel	500	136
Bentonite	136	1
Top soil	1	0
VOLUME OF MATERIAL USED		
2 1/2 tons Gravel 10 bags of Bentonite		

* USE CODE:

- DOMESTIC MUNICIPAL/PUBLIC
- IRRIGATION INDUSTRIAL
- TEST/OBSERVATION GEOTHERMAL

* TYPE OF CASING:

- STEEL PLASTIC
- CONCRETE OTHER (specify) _____

* SIZE OF CASING: _____ INCHES IN DIAMETER

* DEPTH OF WELL: 500 FEET DEEP

* WAS ANY CASING REMOVED? YES _____ NO
 if yes, length removed, in feet: 3

* WAS CASING RIPPED OR PERFORATED? _____ YES NO

SIGNATURE - MASTER WELL DRILLER OR SUPERVISING SANITARIAN

LICENSE # 0410

MWD/MSD/MGD
 CIRCLE ONE

DATE 4/28/08