
 WATER WELL ABANDONMENT-SEALING REPORT FORM

SUBMIT COPIES OF COMPLETED FORM TO:

- * COUNTY ENVIRONMENTAL AGENCY (contact MDE, WMA if address needed)
- * WELL OWNER
- * MDE, WATER MANAGEMENT ADMINISTRATION, WELL PROGRAM

APPROVED
 10/16/2019

DATE WELL ABANDONED: 3/31/16 (month/day/year)

* PERMIT NUMBER OF ABANDONED WELL (if any) _____

* PERMIT NUMBER OF REPLACEMENT WELL: _____

* PERSON ABANDONING WELL: ROBERT COPSEY WELL DRILLER'S LICENSE NUMBER: 161

CIRCLE: MWD / MSD / MGD

* OWNER'S NAME: DERICK & KARA MILLER


* WELL LOCATION:

COUNTY: HOWARD
 NEAREST TOWN: ELICOTT CITY
 TAX MAP 0017 BLOCK _____ PARCEL 0509
 SUBDIVISION: MAKOWSKI PROPERTIES
 SECTION: _____ LOT: 2
 STREET ADDRESS: 3000 MULLINEAUX LANE
ELICOTT CITY MD. 21042

LATITUDE 3 9 . 1 7 2 1 6 3

LONGITUDE 7 6 . 5 1 5 3 6 6

SITE LOCATION MAP

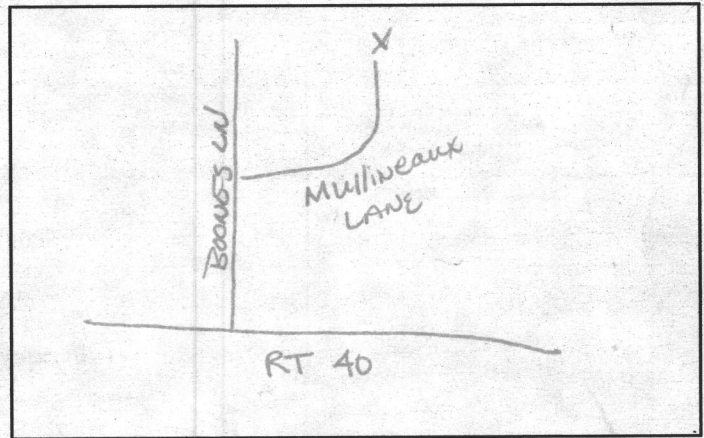

* TYPE OF WELL BEING ABANDONED:

DRILLED _____ JETTED
 BORED _____ HAND DUG
 OTHER (specify) _____

* USE CODE:

DOMESTIC _____ MUNICIPAL/PUBLIC
 IRRIGATION _____ INDUSTRIAL
 TEST/OBSERVATION _____ GEOTHERMAL

* TYPE OF CASING:

STEEL _____ PLASTIC
 CONCRETE _____ OTHER (specify) _____

SIZE OF CASING: 6" INCHES IN DIAMETER

DEPTH OF WELL: 91 FEET DEEP

WAS ANY CASING REMOVED? YES _____ NO
 If yes, length removed, in feet: 5

WAS CASING RIPPED OR PERFORATED? _____ YES NO

LOG OF SEALING MATERIAL

MATERIAL	FEET	
	FROM	TO
BENTONITE CLAY	91'	5'
fill	5	0
VOLUME OF MATERIAL USED		
100lbs bentonite clay		

Robert P. Copsey
 SIGNATURE-MASTER WELL DRILLER OR SUPERVISING SANITARIAN LICENSE# 161

MWD / MSD / MGS
 CIRCLE ONE

3/31/16
 DATE

COUNTY

Real Property Data Search (w3)

Search Result for HOWARD COUNTY

View Map		View GroundRent Redemption				View GroundRent Registration					
Tax Exempt: None		Special Tax Recapture: None									
Exempt Class: None											
Account Identifier:		District - 02 Account Number - 227428									
Owner Information											
Owner Name:	MILLER KARA LEE MILLER DERICK FRANKLIN				Use:	RESIDENTIAL					
Mailing Address:	3000 MULLINEAUX LN ELLCOTT CITY MD 21042-2152				Principal Residence:	YES					
					Deed Reference:	/16399/ 00118					
Location & Structure Information											
Premises Address:	3000 MULLINEAUX LN ELLCOTT CITY 21042-0000				Legal Description:	LOT 2 40,906 SQ 3000 MULLINEAUX LN R/W MAKOWSKI PROPERTY					
Map:	Grid:	Parcel:	Neighborhood:	Subdivision:	Section:	Block:	Lot:	Assessment Year:	Plat No:	13038	
0017	0019	0509	2080801.14	8001			2	2019	Plat Ref:		
Special Tax Areas: None				Town:			None				
				Ad Valorem:			104				
				Tax Class:			None				
Primary Structure Built	Above Grade Living Area			Finished Basement Area		Property Land Area		County Use			
1968	3,096 SF			700 SF		40,906 SF					
Stories	Basement	Type	Exterior	Quality	Full/Half Bath	Garage	Last Notice of Major Improvements				
2	YES	STANDARD UNIT	FRAME/	4	4 full/ 1 half	2 Attached					
Value Information											
			Base Value	Value	Phase-in Assessments						
				As of	As of		As of				
				01/01/2019	07/01/2019		07/01/2020				
Land:			203,400	256,900							
Improvements			243,200	357,200							
Total:			446,600	614,100		502,433		558,267			
Preferential Land:			0					0			
Transfer Information											
Seller: OKEEFE EDWARD				Date: 08/24/2015			Price: \$466,000				
Type: ARMS LENGTH IMPROVED				Deed1: /16399/ 00118			Deed2:				
Seller: WAAGBO STEPHEN F				Date: 05/04/2012			Price: \$465,000				
Type: ARMS LENGTH IMPROVED				Deed1: /13981/ 00010			Deed2:				
Seller: MAKOWSKI EUGENE A				Date: 02/25/1998			Price: \$208,000				
Type: ARMS LENGTH IMPROVED				Deed1: /04197/ 00373			Deed2:				
Exemption Information											
Partial Exempt Assessments:	Class		07/01/2019			07/01/2020					
County:	000		0.00			0.00					
State:	000		0.00			0.00					
Municipal:	000		0.00 0.00			0.00 0.00					
Tax Exempt: None		Special Tax Recapture: None									
Exempt Class: None											
Homestead Application Information											
Homestead Application Status: Approved 08/16/2017											
Homeowners' Tax Credit Application Information											

Homeowners' Tax Credit Application Status: No Application**Date:**

1. This screen allows you to search the Real Property database and display property records.
2. Click **here** for a glossary of terms.
3. Deleted accounts can only be selected by Property Account Identifier.
4. The following pages are for information purpose only. The data is not to be used for legal reports or documents. While we have confidence in the accuracy of these records, the Department makes no warranties, expressed or implied, regarding the information.