
 WATER WELL ABANDONMENT-SEALING REPORT FORM

SUBMIT COPIES OF COMPLETED FORM TO:

- * COUNTY ENVIRONMENTAL AGENCY (contact MDE, WMA if address needed)
- * WELL OWNER
- * MDE, WATER MANAGEMENT ADMINISTRATION, WELL PROGRAM

APPROVED
 10/16/2019
 (Signature)

DATE WELL ABANDONED: 11/27/2017 (month/day/year)

* PERMIT NUMBER OF ABANDONED WELL (if any) _____

* PERMIT NUMBER OF REPLACEMENT WELL: _____

* PERSON ABANDONING WELL: Michael Isom

WELL DRILLER'S LICENSE NUMBER: 162


CIRCLE: MWD / MSD / MGD

* OWNER'S NAME: ~~Howard County~~ Howard County

* WELL LOCATION: Dept of Public works

SITE LOCATION MAP

COUNTY: HOWARD
 NEAREST TOWN: Ellicott City
 TAX MAP 25 BLOCK 1 PARCEL 102
 SUBDIVISION: _____
 SECTION: _____ LOT: _____
 STREET ADDRESS: 3427 Rogers Avenue

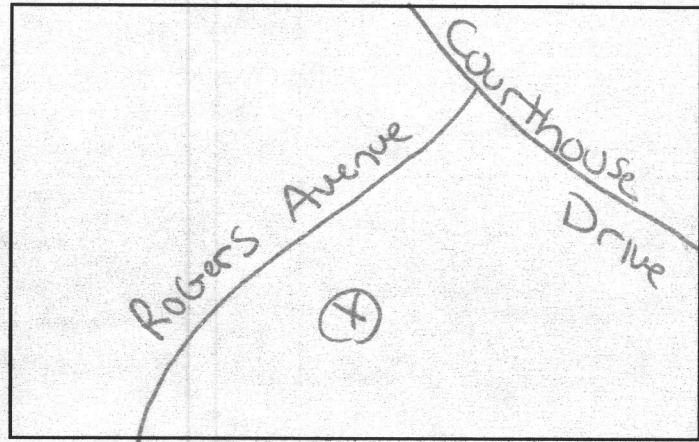

LATITUDE 39.27647

LONGITUDE 76.80778

- * TYPE OF WELL BEING ABANDONED:
 DRILLED JETTED
 BORED HAND DUG
 OTHER (specify) _____

LOG OF SEALING MATERIAL

- * USE CODE:
 DOMESTIC MUNICIPAL/PUBLIC
 IRRIGATION INDUSTRIAL
 TEST/OBSERVATION GEOTHERMAL

MATERIAL	FEET	
	FROM	TO
Stone	15	4
Cement		
GROUT	4	0

- * TYPE OF CASING:
 STEEL PLASTIC
 CONCRETE OTHER (specify) Brick

SIZE OF CASING: 36 INCHES IN DIAMETER

DEPTH OF WELL: 15 FEET DEEP

WAS ANY CASING REMOVED? YES NO

If yes, length removed, in feet: _____

WAS CASING RIPPED OR PERFORATED? YES NO

VOLUME OF MATERIAL USED
20 tons Stone
3000 lbs Cement

SIGNATURE-MASTER WELL DRILLER OR SUPERVISING SANITARIAN (Signature) LICENSE# 162

MWD / MSD / MGS

CIRCLE ONE

11/30/17 DATE

COUNTY

Real Property Data Search (w4)

Search Result for HOWARD COUNTY

View Map		View GroundRent Redemption				View GroundRent Registration			
Tax Exempt: None		Special Tax Recapture: None							
Exempt Class: None									
Account Identifier:		District - 02 Account Number - 216833							
Owner Information									
Owner Name:		HOWARD COUNTY MD DEPT OF PUBLIC WORKS				Use:		EXEMPT	
Mailing Address:		3430 COURT HOUSE DR ELLCOTT CITY MD 21043-4300				Principal Residence:		NO	
						Deed Reference:		/01963/ 00715	
Location & Structure Information									
Premises Address:		3427 ROGERS AVE ELLCOTT CITY 21043-0000				Legal Description:		33,442 SQ' 3427 ROGERS AVE ELLCOTT CITY	
Map:	Grid:	Parcel:	Neighborhood:	Subdivision:	Section:	Block:	Lot:	Assessment Year:	Plat No:
0025	0001	0102	2010101.14	0000				2018	Plat Ref:
Special Tax Areas: None						Town:		None	
						Ad Valorem:		102	
						Tax Class:		None	
Primary Structure Built		Above Grade Living Area		Finished Basement Area		Property Land Area		County Use	
						33,442 SF			
Stories	Basement	Type	Exterior /	Quality	Full/Half Bath	Garage	Last Notice of Major Improvements		
Value Information									
		Base Value		Value		Phase-in Assessments			
				As of		As of		As of	
				01/01/2018		07/01/2019		07/01/2020	
Land:		173,200		173,200					
Improvements		0		0					
Total:		173,200		173,200		173,200		173,200	
Preferential Land:		0						0	
Transfer Information									
Seller: DOYLE PATRICIA L				Date: 03/02/1989			Price: \$144,900		
Type: NON-ARMS LENGTH OTHER				Deed1: /01963/ 00715			Deed2:		
Seller: DOYLE DENNIS M & WF				Date: 10/03/1988			Price: \$0		
Type: NON-ARMS LENGTH OTHER				Deed1: /01893/ 00140			Deed2:		
Seller:				Date:			Price:		
Type:				Deed1:			Deed2:		
Exemption Information									
Partial Exempt Assessments:		Class		07/01/2019		07/01/2020			
County:		500		173,200.00		173,200.00			
State:		500		173,200.00		173,200.00			
Municipal:		500		0.00 0.00		0.00 0.00			
Tax Exempt: None		Special Tax Recapture: None							
Exempt Class: None									
Homestead Application Information									
Homestead Application Status: No Application									
Homeowners' Tax Credit Application Information									

Homeowners' Tax Credit Application Status: No Application**Date:**

1. This screen allows you to search the Real Property database and display property records.
2. Click **here** for a glossary of terms.
3. Deleted accounts can only be selected by Property Account Identifier.
4. The following pages are for information purpose only. The data is not to be used for legal reports or documents. While we have confidence in the accuracy of these records, the Department makes no warranties, expressed or implied, regarding the information.