

\*\*\*\*\*  
 WATER WELL ABANDONMENT-SEALING REPORT FORM  
 \*\*\*\*\*

SUBMIT COPIES OF COMPLETED FORM TO:

- \* COUNTY ENVIRONMENT AGENCY (contact MDE, WMA if address needed)
- \* WELL OWNER
- \* MDE, WATER MANAGEMENT ADMINISTRATION, WELL PROGRAM

APPROVED  
 10/16/2019

DATE WELL ABANDONED: 4/21/16 (month/day/year)

\* PERMIT NUMBER OF ABANDONED WELL (if any) \_\_\_\_\_

\* PERMIT NUMBER OF REPLACEMENT WELL \_\_\_\_\_


\* PERSON ABANDONING WELL: Michael Barlow

WELL DRILLERS LICENSE NUMBER: 355  
 CIRCLE: MWD/MSD/MGD

\* OWNER'S NAME: Jacob Wagner

SITE LOCATION MAP

\* WELL LOCATION:  
 COUNTY: Howard  
 NEAREST TOWN: Glenn  
 TAX MAP 22 BLOCK 7 PARCEL 94  
 SUBDIVISION: Sullivan Property  
 SECTION: \_\_\_\_\_ LOT: 1  
 NEAREST ROAD: 13755 Burntwoods Rd

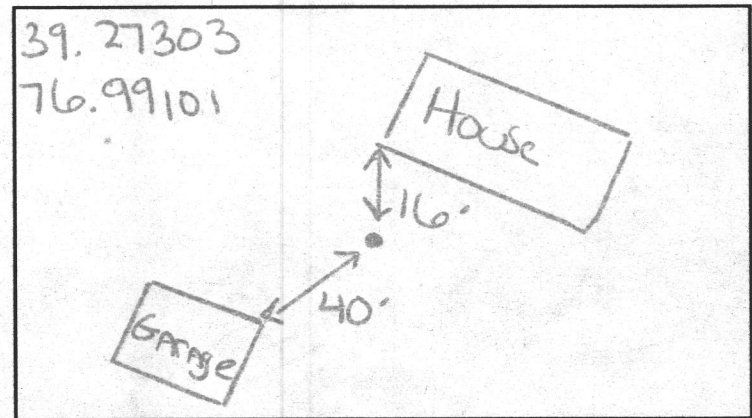

\* TYPE OF WELL BEING ABANDONED:

- DRILLED  JETTED
- BORED/AUGERED  HAND DUG
- OTHER (specify) \_\_\_\_\_

\* USE CODE:

- DOMESTIC  MUNICIPAL/PUBLIC
- IRRIGATION  INDUSTRIAL
- TEST/OBSERVATION  GEOTHERMAL

\* TYPE OF CASING:

- STEEL  PLASTIC
- CONCRETE  OTHER (specify) stone

\* SIZE OF CASING: 48 INCHES IN DIAMETER

\* DEPTH OF WELL: 68 FEET DEEP

\* WAS ANY CASING REMOVED?  YES  NO  
 if yes, length removed, in feet: \_\_\_\_\_

\* WAS CASING RIPPED OR PERFORATED?  YES  NO

LOG OF SEALING MATERIAL

MATERIAL	FEET	
	FROM	TO
Stone	68	5
Cement	5	2
SOIL	2	0
VOLUME OF MATERIAL USED		

SIGNATURE-MASTER WELL DRILLER OR SUPERVISING SANITARIAN \_\_\_\_\_

355  
 LICENSE #

MWD/MSD/MGD  
 CIRCLE ONE

4/22/16  
 DATE

Real Property Data Search ( w1)

Search Result for HOWARD COUNTY

View Map		View GroundRent Redemption				View GroundRent Registration				
Tax Exempt: None		Special Tax Recapture: None								
Exempt Class: None										
Account Identifier:		District - 03 Account Number - 297039								
Owner Information										
Owner Name:	WAGNER JACOB L				Use:	RESIDENTIAL				
					Principal Residence:	YES				
Mailing Address:	13755 BURNTWOODS RD GLENELG MD 21737-9724				Deed Reference:	/14515/ 00059				
Location & Structure Information										
Premises Address:	13755 SW BURNTWOODS RD GLENELG 21737-0000				Legal Description:	LOT 1 4.271 A 13755 BURNTWOODS RD SULLIVAN SUBDIVISION				
Map:	Grid:	Parcel:	Neighborhood:	Subdivision:	Section:	Block:	Lot:	Assessment Year:	Plat No:	6864
0022	0007	0094	3020201.14	2001			1	2019	Plat Ref:	
Special Tax Areas: None						Town:	None			
						Ad Valorem:	100			
						Tax Class:	None			
Primary Structure Built	Above Grade Living Area			Finished Basement Area		Property Land Area		County Use		
1980	2,600 SF			470 SF		4.2700 AC				
Stories	Basement	Type	Exterior	Quality	Full/Half Bath	Garage	Last Notice of Major Improvements			
2	YES	STANDARD UNIT	SIDING/	4	2 full/ 1 half					
Value Information										
		Base Value	Value		Phase-in Assessments					
			As of		As of		As of			
			01/01/2019		07/01/2019		07/01/2020			
Land:	149,500		239,500							
Improvements	268,900		244,800							
Total:	418,400		484,300		440,367		462,333			
Preferential Land:	0						0			
Transfer Information										
Seller: WAGNER JACOB L				Date: 12/10/2012			Price: \$0			
Type: NON-ARMS LENGTH OTHER				Deed1: /14515/ 00059			Deed2:			
Seller: SULLIVAN HERBERT H				Date: 06/04/2009			Price: \$562,750			
Type: ARMS LENGTH IMPROVED				Deed1: /11787/ 00434			Deed2:			
Seller:				Date:			Price:			
Type:				Deed1:			Deed2:			
Exemption Information										
Partial Exempt Assessments:	Class		07/01/2019		07/01/2020					
County:	000		0.00							
State:	000		0.00							
Municipal:	000		0.00 0.00		0.00 0.00					
Tax Exempt: None		Special Tax Recapture: None								
Exempt Class: None										
Homestead Application Information										
Homestead Application Status: Approved 06/22/2017										

---

**Homeowners' Tax Credit Application Status:** No Application**Date:**

---

1. This screen allows you to search the Real Property database and display property records.
2. Click **here** for a glossary of terms.
3. Deleted accounts can only be selected by Property Account Identifier.
4. The following pages are for information purpose only. The data is not to be used for legal reports or documents. While we have confidence in the accuracy of these records, the Department makes no warranties, expressed or implied, regarding the information.