

Bureau of Environmental Health

8930 Stanford Boulevard, Columbia, MD 21045

Main: 410-313-2640 | Fax: 410-313-2648

TDD 410-313-2323 | Toll Free 1-866-313-6300

www.hchealth.org

Facebook: www.facebook.com/hocohealth

Twitter: HowardCoHealthDep

Dr. Maura J. Rossman, M.D., Health Officer

INFORMATION FORM - SEPTIC SYSTEM REPAIR/UPGRADE

Reason for Request:

- Failing System
System relocation for proposed addition
System upgrade for proposed addition
Inadequate treatment zone
Collapsed septic tank
Collapsed drywell

Has the septic tank been pumped within the last month?

- Yes Date pumped: N/A
No

Was a visual inspection of the septic tank and/or drain fields conducted?

- Yes Explain observations:
No

Was a visual inspection of the sewage line conducted?

- Yes
Blockage leading to the tank
Yes. Explain:
No
Blockage leading to the field
Yes. Explain:
No

Existing system design

- Drywell
Trench
Mound
Unknown
Other:

Is discharge surfacing on the ground?

- Yes
No

Additional Comments:

*For REPAIRS, are the owners proposing, or do they plan to add in the future, any additions or modifications to the property, i.e. pools, living space additions, garages, etc? This information must be disclosed at the time of this application. The Health Department will not be able to accommodate requests in the field for property modifications unrelated to the repair request. Such requests may require an additional fee, testing, and submittal of a Percolation Certification Plan, if the property does not meet current Code and Regulation.

Septic Contractor: Hatfields Equipment Inc Contractor's Phone: 301 490 4289

Contractor's Address: PO Box 519 Annapolis Junction MD 20721

Property Address: 16347 Frederick Road County file:

Subdivision: Lot: Year Built:

Owner's Name: Susan Leake Owner's Phone:

Name of previous owners: Existing bedrooms: 4

Proposed bedrooms:

Has this request been previously discussed with a Sanitarian? (Name):

Public Sewer available/nearby:

*A Sanitarian will be in contact within three business days, depending upon the urgency of the situation, to coordinate the scheduling/review of the repair or upgrade.

Prior to scheduling inspections, scaled plans should be submitted to clarify the nature of the addition.



Print out a copy of Real Property Data via Dept. of Taxation website Indexed file found

If public sewer may be nearby, verify whether sewer is technically "available" through the Bureau of Engineering.

If sewer is available and the property is within the Metropolitan District, connection to sewer is required: if the owner believes reason for exemption exists, the owner should justify the request in writing.

If soil/site conditions are limited and sewer and/or Metro District status is not conducive to connection, the Sanitarian may recommend pursuit of Emergency Sewer Extension or Emergency Metro District Inclusion. The Owner should contact the Bureau of Utilities for details.

No permit is to be issued nor inspection to be scheduled without prior fee collection at the office unless an emergency situation exists. The contractor is to notify office of the emergency situation as soon as possible.

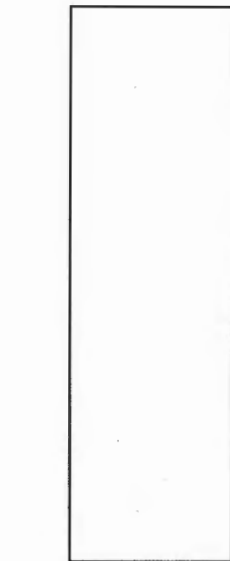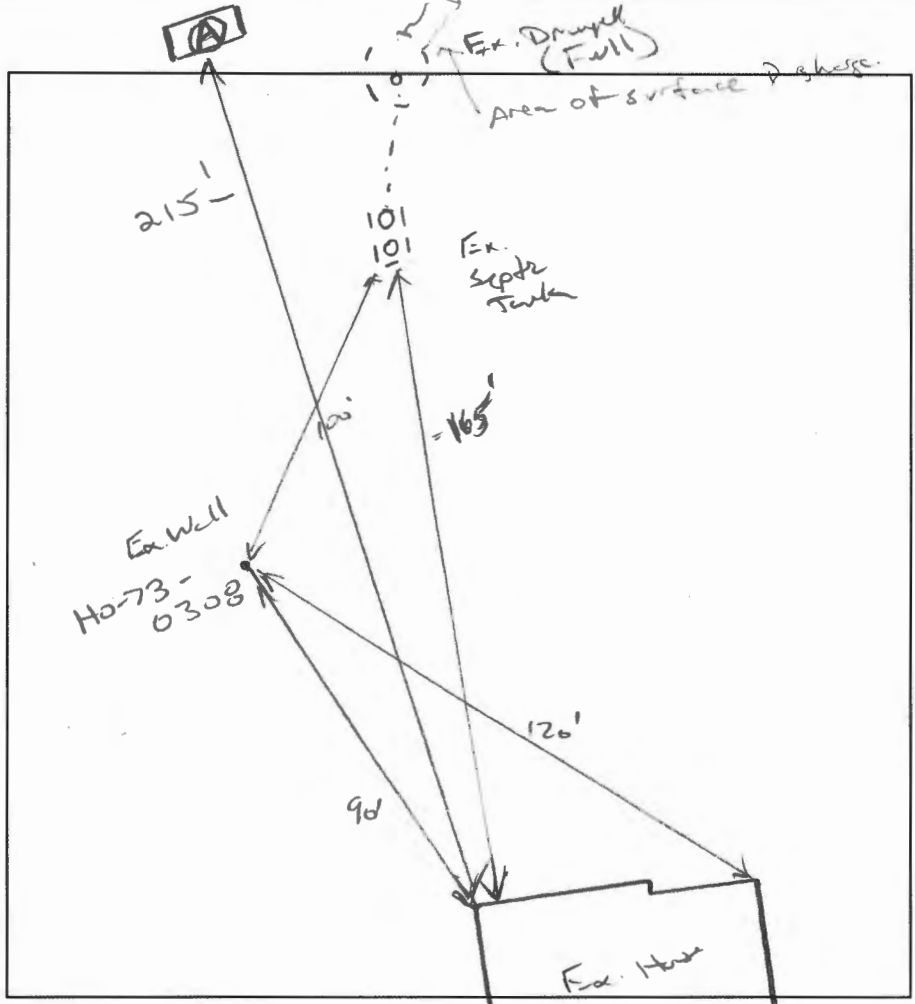

(A)

2'

4'

12'

Br L,
2" BK roots
Fruable
11 Br CL
m/c SBK
Fruable, CW
roots
5% Sapwood
11 Br Y SLL
WK F SBK
CW, Fruable
micaceous,
15% shale
15% Sapwood
Lvs

DATE	TEST #	DEPTH	START	BREAK 1" DROP	STOP 2" DROP	TIME OF 2ND INCH	P/F/H
7/23/19	(A)	5' 12"	00:58	01:06	01:18	12	(P)
		H ₂ O found @ 12"				15-20	(P)

REMARKS Ex. Driveway full w/ surface discharge.

SANITARIAN K. Wolf BACKHOE Hartfield's OTHERS _____

TEST HOLES USED IN SDA _____ AVG. PERC TIME _____ SQ. FT/BR _____

TRENCH WIDTH 3' INLET DEPTH 2.5' MAX. BOT DEPTH 7' EFFECTIVE SW 4.5-7'
(2.5' or .55)

$$4BR = \frac{600}{0.2} = 750 \div 3 = 250 (.55) = \underline{\underline{137.5}} \quad (2 \times 69)$$



HOWARD COUNTY HEALTH DEPARTMENT

65543

Received From

Handwritten name: [Illegible]

DATE 7/18/11

PHONE # 301-970-1651

CASH

CHECK

NO.

Handwritten: 2466

For Repair - 16347 Federal Rd

One hundred and [Illegible] Dollars

\$ 165.00

Received By

Handwritten signature: [Illegible]