

RECEIVED

AUG 05 2019

LICENSES & PERMITS
DIVISION

5 August 2019

13942 Hallowell Court
Dayton, MD 20136

Howard County Department of
Inspections, Licenses, and Permits
3430 Court House Drive
Ellicott City, MD 21043

Re: Building Permit B19002401

Approved 8/15/2019
R/E

Dear Sir/Madam:

I received a building permit to install a hot tub. I would like to amend my application so that I can also construct a cedar gazebo with an aluminum roof to go over the hot tub. The outside dimension of the gazebo is 12' x 12' and the height is 10.5'. I am including a photo of the gazebo.

Sincerely yours,

Sarah K Eichhorn

Sarah K. Eichhorn
301-741-2852

Enclosures: Gazebo Design
Check No. 761, dated 5 August 2019, \$25.00
Copy of Building Permit: B19002401
Revised Plat

Invoice # 585046
ck # 761
paid

cc: PTZ
Healter

* Mail one issued *

Delivery ZIP Code: 21029 Change

Home / Patio, Lawn & Garden / Backyard & Outdoor Structures / Gazebos

Approved RS R002401
8/15/2019 RJK

12' x 12' Cedar Gazebo with Aluminum Roof



Curbside Delivery Included

Features:

- 100% FSC Certified Wood
- Water-Based Stain
- Fully Paintable
- Assembly Required

Qty

Add to Cart

Arrives approximately 3 - 4 weeks from time of order.


Add to Registry

Manuals, Information & Guides

Dimensional Drawing

Roof English


Roof Spanish

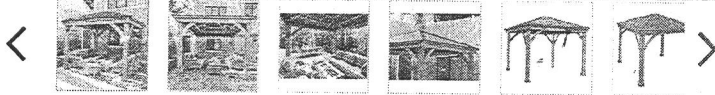

Product Details

Attention: As the purchaser and/or installer of this product, you are advised to consult your local city, municipality and applicable HOA guidelines for guidance on building codes and/or zoning requirements for your area before purchase. This structure may require a permit.

Product details have been supplied by the Manufacturer, and are hosted by a third party.

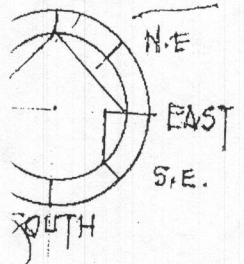

REVISED
Date: 8-5-19
Comments: Add 12' x 12' gazebo over hot tub

Approved R14
8/15/19

BUILDING RESTRICTION LINES

EXISTING SEPTIC AREA
19,000 SQ. FT.

OUTLET BASIN
APPROX.

1: NEW ADDITION
1 STORY - 484 GSF

EXIST. SEPTIC TANK

2: NEW RAISED
WOOD DECK
W/ STAIR
TO GRADE

3: NEW LANDING
W/ STAIR TO GRADE

NEW TERRACE
AT GRADE W/ LOW
RETAIN. WALLS & SUIT
(BY OWNERS)

4: NEW SCREEN PORCH
W/ ROOF DECK & V.
3000 GSF FT. PRINT

12' x 12'
cedar gazebo

Hot Tub +
Concrete
Base
7' x 9'
with 28" x 36"
Dumpout for
steps


TEMP

EXIST. L.P. GAS T.

EXIST. STO. SHED
(12 x 20)
APPROX. LOC.

EXISTING
RIPED PLANTERS

EXISTING
POST LAMP
LOCATIONS

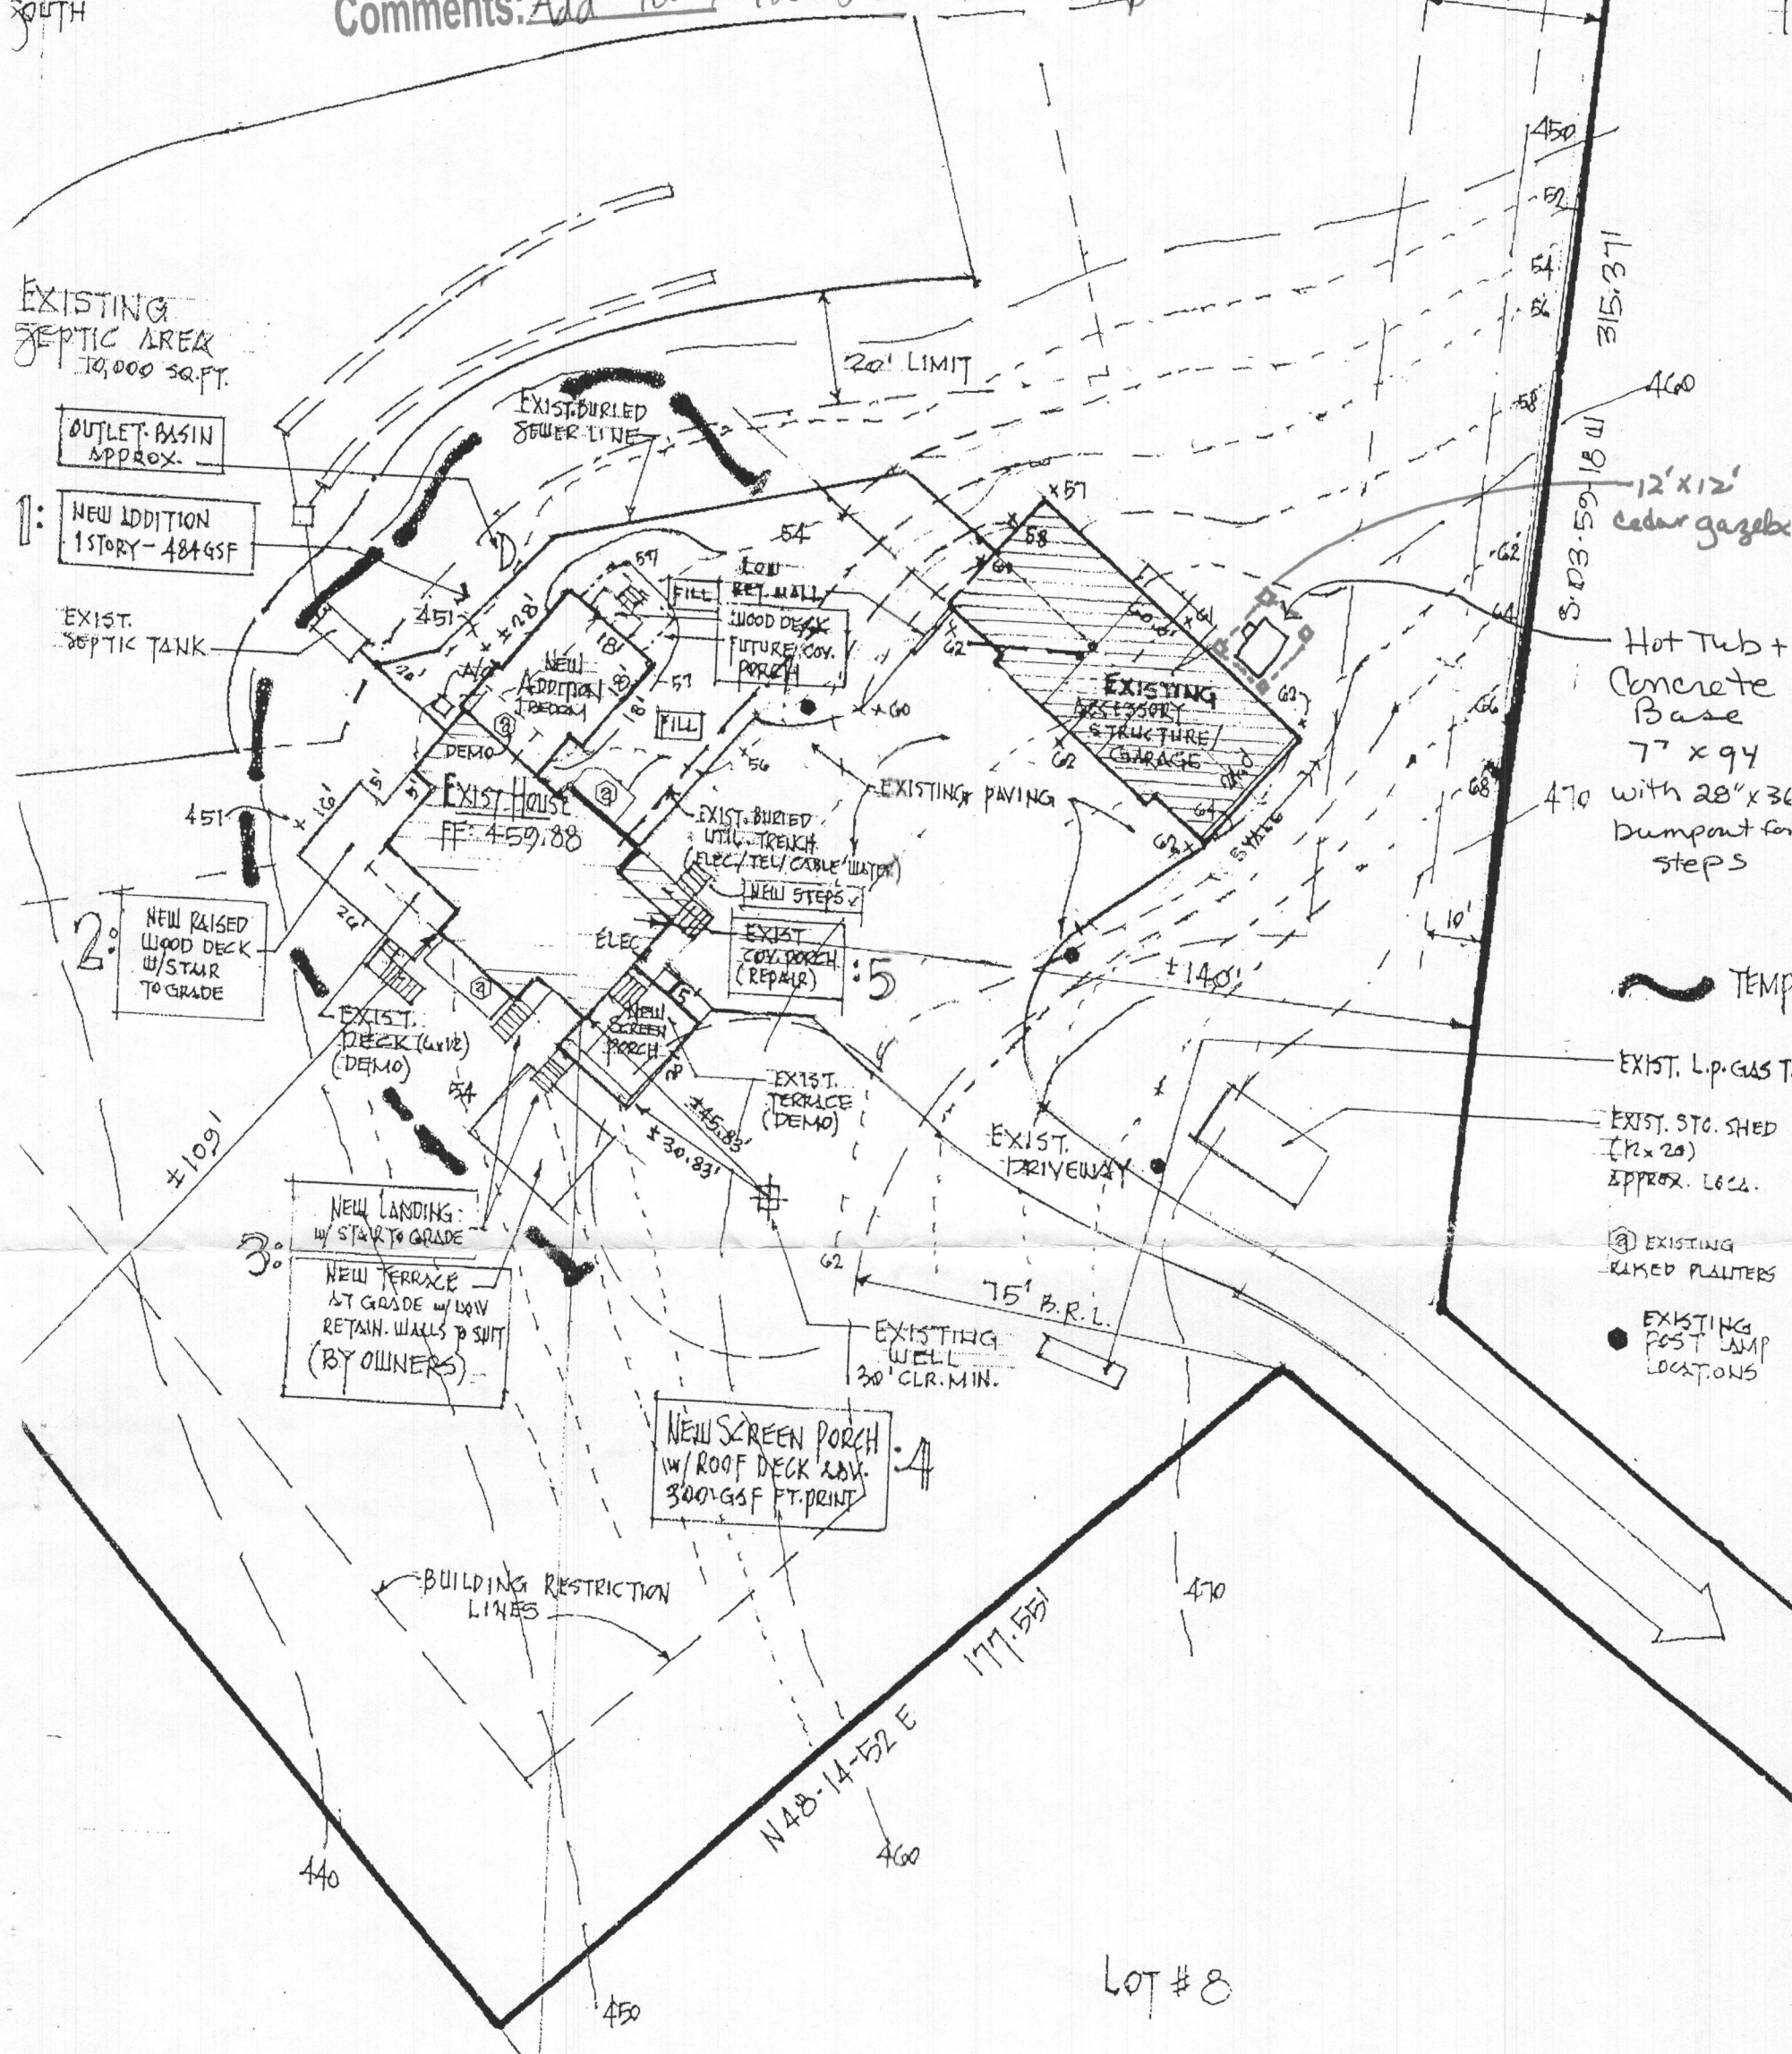

APPROVED
WALKTHRU BUILDING PERMITS
BP# B19002701 AP
APP. SAN Robert Freeman DATE 7/25/2019
DESC. OF WORK: Hot Tub As
Shawn