

C1 2909 SEQUENCE NO. (OEP USE ONLY) STATE OF MARYLAND WELL COMPLETION REPORT THIS REPORT MUST BE SUBMITTED WITHIN 45 DAYS AFTER WELL IS COMPLETED. COUNTY NUMBER A 32984

DATE Received DATE WELL COMPLETED 092089 Depth of Well 200 (TO NEAREST FOOT) PERMIT NO. 40-81-0707

OWNER Biddison Linda A last name first name STREET OR RFD Folly Quarter Rd. TOWN Glenely SUBDIVISION Berilla Property SECTION LOT 2

WELL LOG Not required for driven wells STATE THE KIND OF FORMATIONS PENETRATED, THEIR COLOR, DEPTH, THICKNESS AND IF WATER BEARING

DESCRIPTION (Use additional sheets if needed)	FEET FROM	TO	Check if water bearing
Top Soil	0	2	
Sandy	2	21	
Sand Stone	21	35	✓
Micka	35	45	
Sand Stone	45	55	✓
Micka	55	200	

GROUTING RECORD WELL HAS BEEN GROUTED (Circle Appropriate Box) TYPE OF GROUTING MATERIAL CEMENT CM BENTONITE CLAY BC NO. OF BAGS 42 NO. OF POUNDS 300 GALLONS OF WATER DEPTH OF GROUT SEAL (to nearest foot) from 0 ft. to 48 ft.

CASING RECORD casing types insert appropriate code below ST CO STEEL CONCRETE PL OT PLASTIC OTHER MAIN Nominal diameter Total depth CASING top (main) casing of main casing TYPE (nearest inch) (nearest foot) PL 6 30

OTHER CASING (if used) diameter inch depth (feet) from to


SCREEN RECORD screen type or open hole insert appropriate code below ST BR HO STEEL BRASS OPEN HOLE PL OT PLASTIC OTHER DEPTH (nearest ft.) 110 28 200

GRAVEL PACK IF WELL DRILLED WAS FLOWING WELL INSERT F IN BOX 68

OEP USE ONLY (NOT TO BE FILLED IN BY DRILLER) T (E.R.O.S.) WQ 70 72 74 75 76 TELESCOPE CASING LOG INDICATOR OTHER DATA

PUMPING TEST HOURS PUMPED (nearest hour) 3 PUMPING RATE (gal. per min. to nearest gal.) 4 METHOD USED TO MEASURE PUMPING RATE Bucket WATER LEVEL (distance from land surface) BEFORE PUMPING 28 WHEN PUMPING 80 TYPE OF PUMP USED (for test) A air P piston T turbine C centrifugal R rotary O other J jet S submersible

PUMP INSTALLED DRILLER WILL INSTALL PUMP YES NO IF DRILLER INSTALLS PUMP, THIS SECTION MUST BE COMPLETED FOR ALL WELLS EXCEPT HOME USE TYPE OF PUMP INSTALLED PLACE (A,C,J,P,R,S,T,O) IN BOX - SEE ABOVE: CAPACITY: GALLONS PER MINUTE (to nearest gallon) PUMP HORSE POWER PUMP COLUMN LENGTH (nearest ft.) CASING HEIGHT: (circle appropriate box, and enter casing height) above below LAND SURFACE 2 (nearest foot)

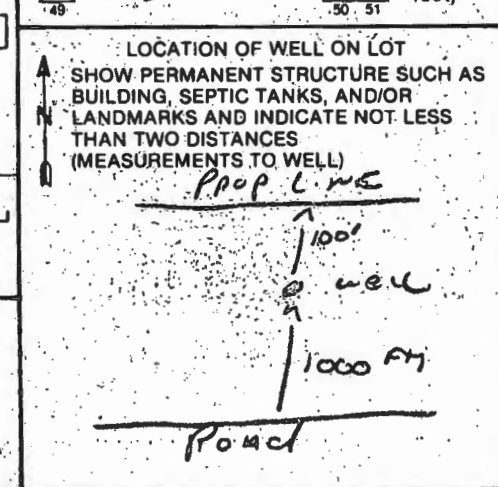

CIRCLE APPROPRIATE LETTER A WELL WAS ABANDONED AND SEALED WHEN THIS WELL WAS COMPLETED E ELECTRIC LOG OBTAINED P TEST WELL CONVERTED TO PRODUCTION WELL I HEREBY CERTIFY THAT THIS WELL HAS BEEN CONSTRUCTED IN ACCORDANCE WITH COMAR 10.17.13 "WELL CONSTRUCTION" AND IN CONFORMANCE WITH ALL CONDITIONS STATED IN THE ABOVE CAPTIONED PERMIT, AND THAT THE INFORMATION PRESENTED HEREIN IS ACCURATE AND COMPLETE TO THE BEST OF MY KNOWLEDGE. DRILLERS IDENT. NO. 27 DRILLERS SIGNATURE Ralph Mayne (MUST MATCH SIGNATURE ON APPLICATION) SITE SUPERVISOR (sign. of driller or journeyman responsible for sitework, if different from permittee)

Review 1/31/85 on p. 5

well Permit No. HO - 81-0707

subdivision BERILLA Prop Lot 2 Block Plat Sec.
 well Driller Ralph MAYNE Owner Linda A Child, Son

Well Driller Ralph Mayne Owner Linda A. Bidelson

Distance of measuring point (M.P.) above ground 1 ft.

Static water level (S.W.L.) below M.P. 28


Time pump started 2:46

Pumping rate 9 C.P.M.

Total time 15 min to reach pumping water level 80 ft. below M.P.

[illegible]

30 ft PL - 7 bags

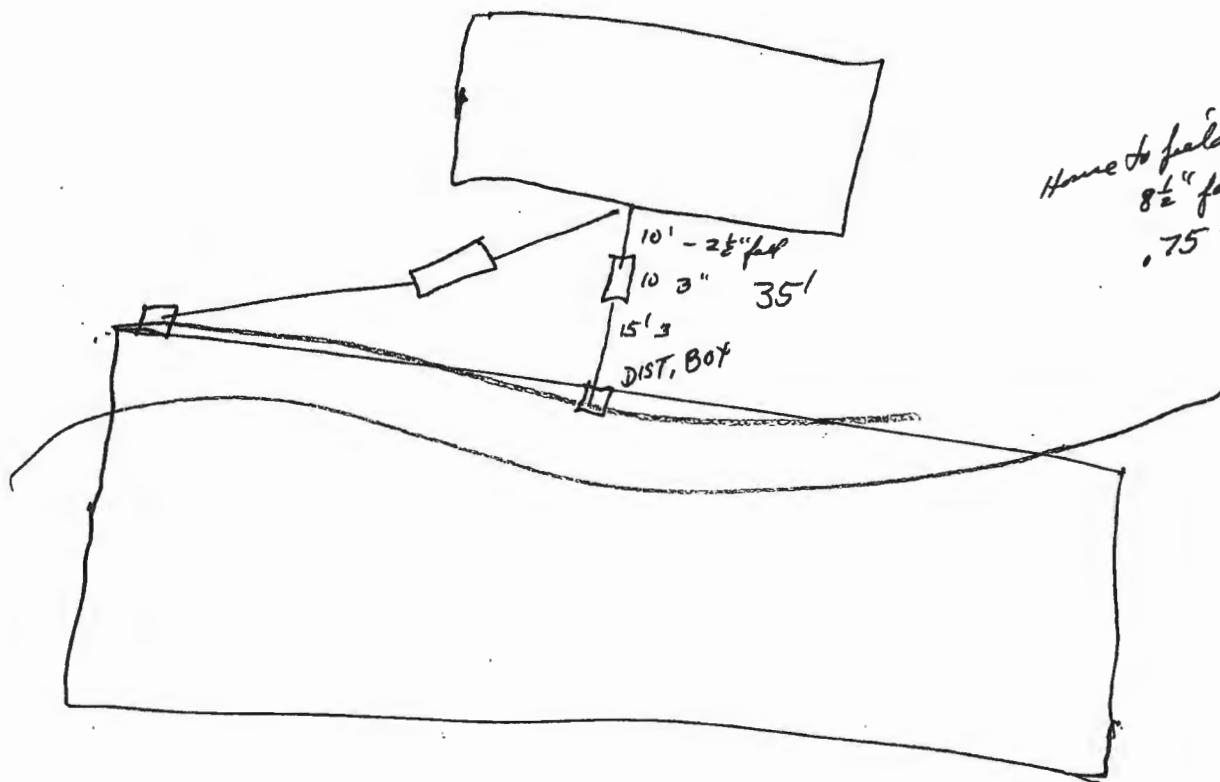

Home to field
 $8\frac{1}{2}"$ fall
.75'

CURVE DATA

Δ	TANGENT	CHORD BEARING & DISTANCE
35°-30'	82.87	N 78°-18'-57" W 163.33

PART TWO
FOX DEN FARM
PB 10 F 63
LOT 5

PLAT.

*Replace deck
with a 10'x13'
porch*

PART ONE
FOX DEN FARM
PB 10 F 63
LOT 1

*The shown
deck location
will have no
impact to the
existing well
or septic*

*OK to
proceed
AA*

