

**COMPLETE THIS FORM WHEN DROPPING OFF ANY  
CORRESPONDENCE AND/OR PLANS TO THE HOWARD COUNTY  
DEPARTMENT OF INSPECTIONS, LICENSES AND PERMITS COUNTER:**

Date: 10/22/2019

To: Plan Review  
(Person's Name and Division)

From: Flora Mulkey (919) 961-4506  
(Your Name, Company Name and Telephone Number)

Subject: Project name Mulkey/By Residence  
Project site address 13945 Brighton Dam Rd, Clarksville, MD 21029  
Permit # B19003534 SDP # \_\_\_\_\_  
Other information pertinent to this project \_\_\_\_\_

Please check the attachments below that you are submitting with this transmittal:

- Letter of response to address plan review comment letter
- Revised plans and/or revised details: When submitting for a complete re-review, **duplicate sets shall be submitted.**
- Letter Summarizing Changes
- Energy conservation calculations
- Copies of \_\_\_\_\_ (be specific).

Health Department Request       DPZ/ DED Request       Applicant's Request

Two sets of single family dwelling model plans to be placed on permanent file: Model name and/or # \_\_\_\_\_

Other Removing 2nd door from proposed closet on 1st floor; move + enlarge window in master bedroom 1st floor

**Contact Person Information: (Required)**

Flora Mulkey  
Please Print Name

Telephone No: (919) 961-4506

E-Mail Address: Stats151@gmail.com

**PLEASE ASSURE ALL DOCUMENTS AND/OR REVISIONS ARE APPROPRIATELY SIGNED AND SEALED, IF NECESSARY, BY A LICENSED ARCHITECT OR ENGINEER. PLEASE BE ADVISED THAT INSUFFICIENT INFORMATION MAY RESULT IN THE DELAY OF REVIEW BY THE PLANS EXAMINER. THE DEPARTMENT OF INSPECTIONS, LICENSES AND PERMITS WILL CONTACT YOU IF THERE IS A PROBLEM. IN ADDITION, ONCE THE BUILDING PERMIT IS APPROVED BY THE PLAN REVIEW DIVISION AND ALL OTHER REQUIRED SIGNATORY AGENCIES, AND THE BUILDING PERMIT IS READY FOR ISSUANCE, THE PERMIT DIVISION WILL NOTIFY THE APPROPRIATE CONTACT PERSON FOR PERMIT PICK UP. ALL PERMIT STATUS INQUIRIES SHALL BE DIRECTED TO THE PERMIT DIVISION AT 410-313-2455. CODE RELATED QUESTIONS AND PLAN REVIEW INQUIRIES SHALL BE DIRECTED TO THE PLAN REVIEW DIVISION AT 410-313-2436. PLEASE ALLOW A MINIMUM OF FIVE (5) WORKING DAYS FOR ANY PLAN SUBMITTALS TO BE REVIEWED. THANK YOU.**

Received by [Signature]

CC: DPZ  
Health Dept.

01LP 2019 007 77 048105

LOT 30

P.B. 8, P. 99

S 82°43'50" W  
(10' UTILITY EASEMENT) 182.24'


**REVISED**  
Date: 10/23/19  
B19003534  
Comments: Move + enlarge window

LOT 28 in master  
P.B. 8, P. 99  
HAVILAND HILLS  
80,050 SF±  
OR 1.84 Ac±  
Bedroom

LOT 19  
P.B. 8, P. 99  
HAVILAND HILLS

475.00'

(10' UTILITY EASEMENT)

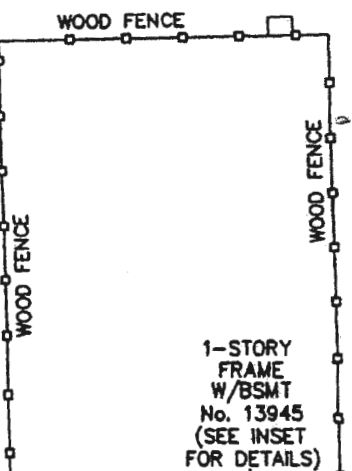

1-STORY  
FRAME  
W/BSMT  
No. 13945  
(SEE INSET  
FOR DETAILS)

new larger  
window  
in master



524.02'

N 01°40'50" E

S 01°40'50" W

MAC.  
DRIVE

(75' B.R.L.)


L=162.30'  
R=792.89'

BRIGHTON DAM ROAD

I HEREBY CERTIFY THAT IMPROVEMENTS ARE LOCATED AS SHOWN HEREON AND TO THE BEST OF MY INFORMATION, PROFESSIONAL KNOWLEDGE AND BELIEF, THERE ARE NO ENCROACHMENTS EXCEPT AS SHOWN.

*M.N. Roshan*  
M.N. ROSHAN, L.S. DATE  
MD REG. No. 11049

ADDRESS:  
13945 BRIGHTON DAM ROAD  
CLARKSVILLE, MARYLAND 21029

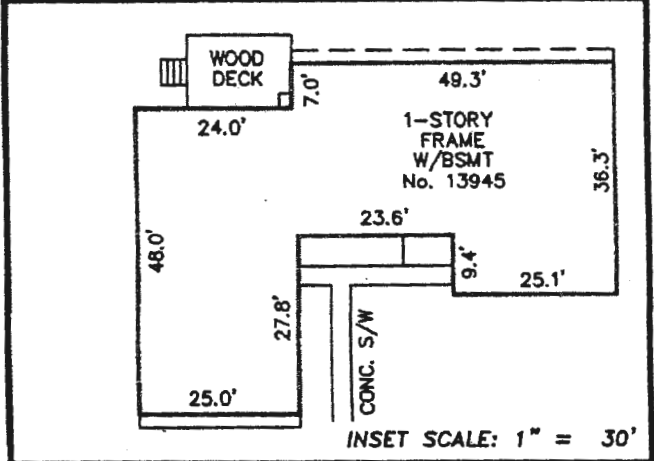

NOTES:


1. THIS IMPROVEMENT LOCATION DRAWING:
  - A. IS OF BENEFIT TO A CONSUMER ONLY INsofar AS IT IS REQUIRED BY A LENDER OR A TITLE INSURANCE COMPANY OR ITS AGENT IN CONNECTION WITH CONTEMPLATED TRANSFER, FINANCING OR REFINANCING;
  - B. IS NOT TO BE RELIED UPON FOR THE ESTABLISHMENT OR LOCATION OF FENCES, GARAGES, BUILDINGS, OR OTHER EXISTING OR FUTURE IMPROVEMENTS; AND
  - C. DOES NOT PROVIDE FOR THE ACCURATE IDENTIFICATION OF PROPERTY BOUNDARY LINES, BUT SUCH IDENTIFICATION MAY NOT BE REQUIRED FOR THE TRANSFER OF TITLE OR SECURING FINANCING OR REFINANCING.
2. THE LEVEL OF ACCURACY OF APPARENT SETBACK DISTANCES IS ONE FOOT, MORE OR LESS.
3. THIS PLAT, WAS PREPARED WITHOUT BENEFIT OF A TITLE REPORT.

LOCATION DRAWING  
LOT 28  
P.B. 8, P. 99  
HAVILAND HILLS  
HOWARD COUNTY, MARYLAND  
SCALE: 1" = 60' DATE: MAY 26, 2015

FILE No.	L05507
NJR	CLIENT MD19884



**NJR & ASSOCIATES, LLC.**  
**LAND SURVEYING AND PLANNING**  
1813 MONTEVIDEO ROAD  
JESSUP, MARYLAND 20794  
TEL: (410)799-9089 FAX: (410)799-9093

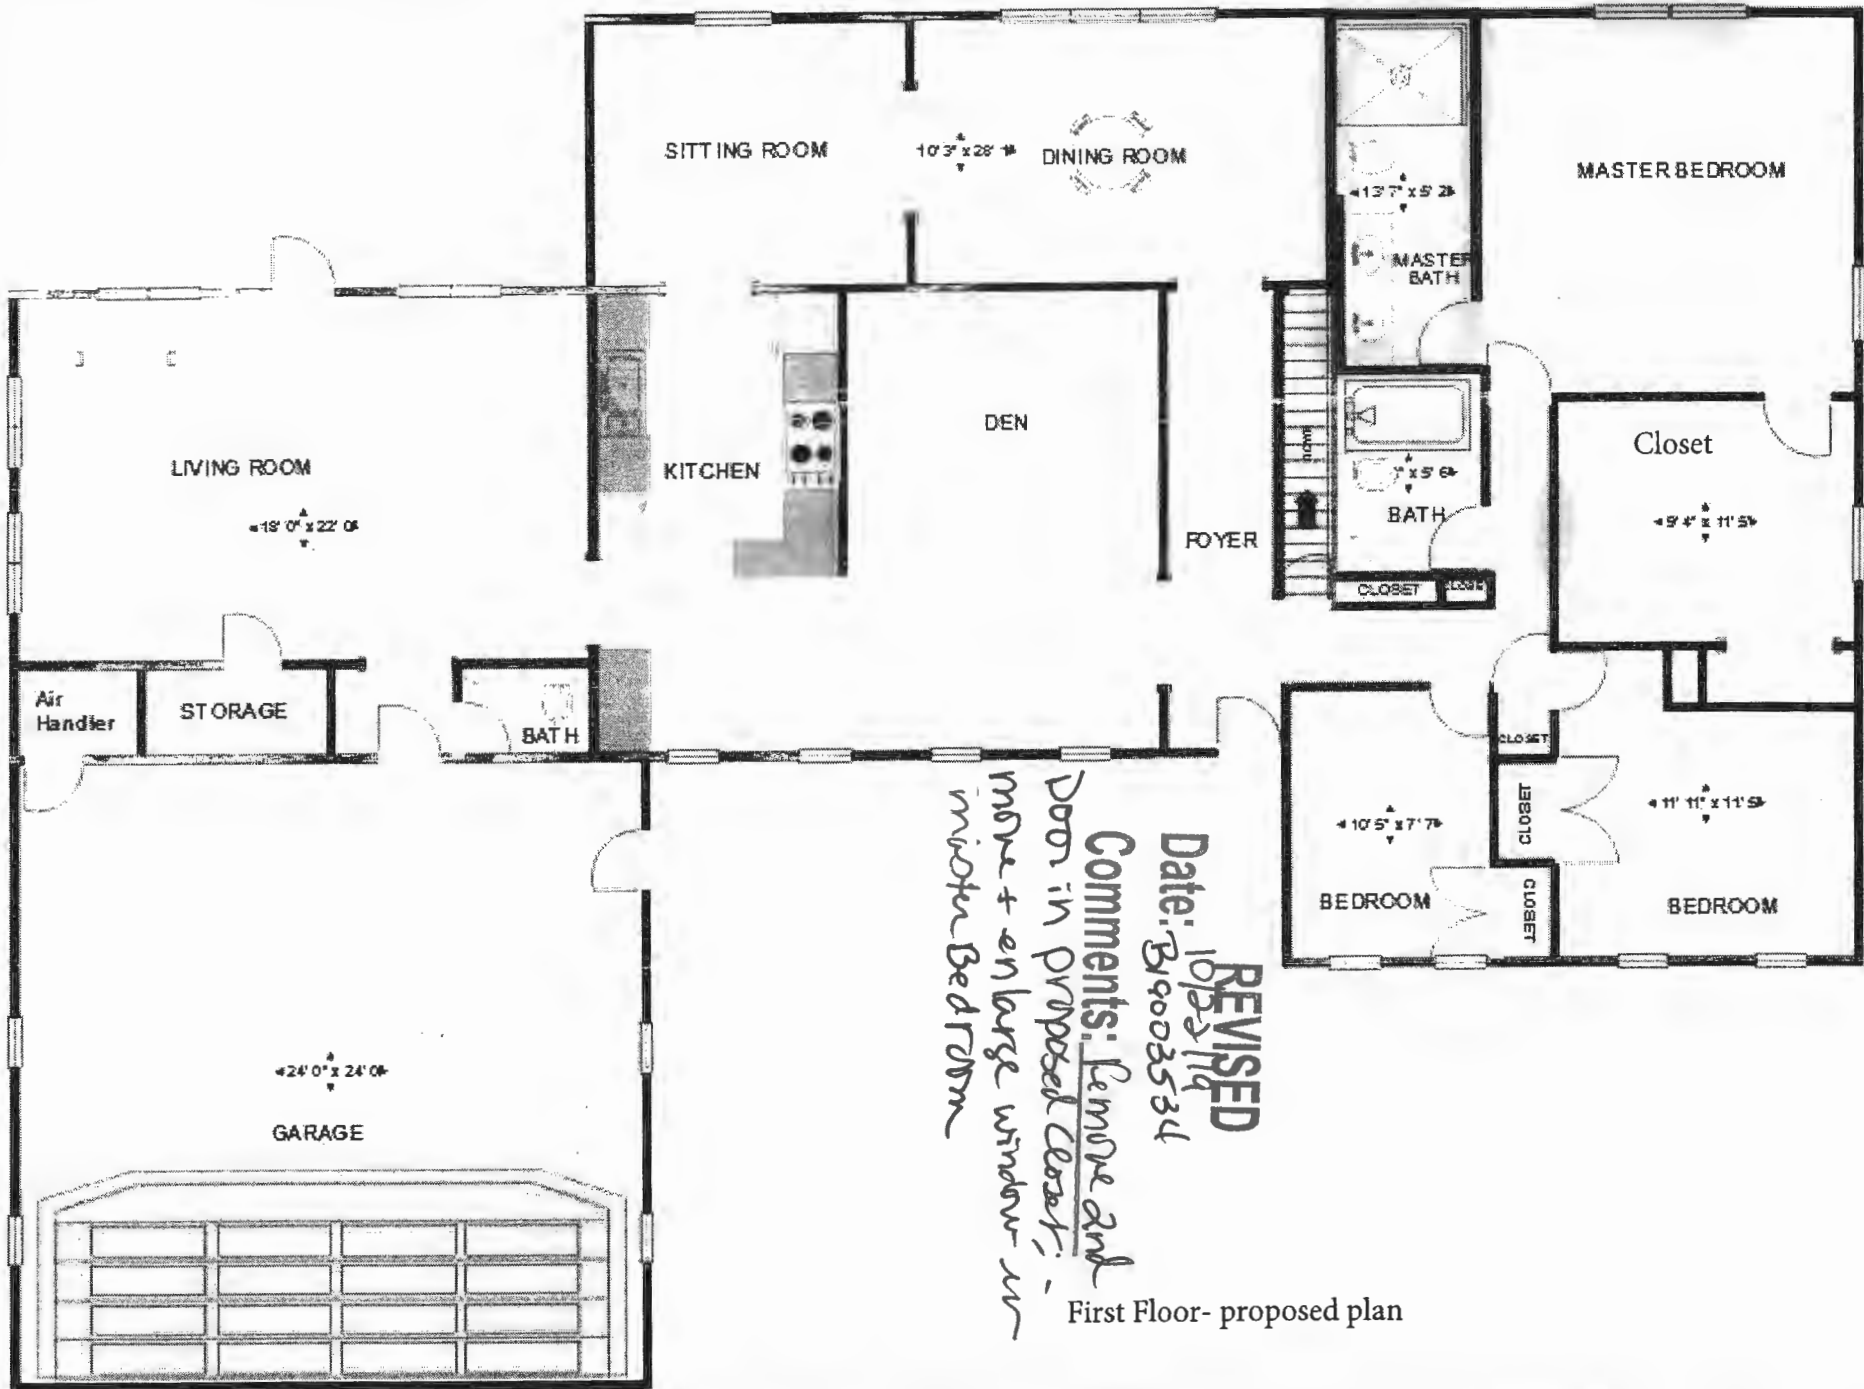

**REVISED**  
 Date: 10/22/14  
 By: 9003534  
 Comments: Remove and  
 move + enlarge window in  
 master Bedroom

First Floor- proposed plan