

## Real Property Data Search ( w4)

## Search Result for HOWARD COUNTY

<a href="#">View Map</a>	<a href="#">View GroundRent Redemption</a>	<a href="#">View GroundRent Registration</a>
<b>Tax Exempt:</b> None		<b>Special Tax Recapture:</b> None
<b>Exempt Class:</b> None		
<b>Account Identifier:</b>	<b>District - 02 Account Number - 256479</b>	
Owner Information		
<b>Owner Name:</b>	BD OF COUNTY COMMISSIONERS DEPT PUBLIC WORKS	<b>Use:</b> <b>Principal Residence:</b> EXEMPT NO
<b>Mailing Address:</b>	COURT HOUSE ELLCOTT CITY MD 21043	<b>Deed Reference:</b> /00180/ 00339
Location & Structure Information		
<b>Premises Address:</b>	4411 NEW CUT RD ELLCOTT CITY 21043-0000	<b>Legal Description:</b> PAR B 74.817 A 4411 NEW CUT ROAD NEW CUT LANDFILL INCL RS
<b>Map:</b>	<b>Grid:</b>	<b>Parcel:</b>
0031	0002	0529
<b>Neighborhood:</b>	<b>Subdivision:</b>	<b>Section:</b>
2050510.14	0000	
<b>Block:</b>	<b>Lot:</b>	<b>Assessment Year:</b>
	PAR B	2018
<b>Plat No:</b>	<b>Plat Ref:</b>	
16202		
<b>Special Tax Areas:</b> None	<b>Town:</b>	None
	<b>Ad Valorem:</b>	102
	<b>Tax Class:</b>	None
<b>Primary Structure Built</b>	<b>Above Grade Living Area</b>	<b>Finished Basement Area</b>
		<b>Property Land Area</b>
		74.8100 AC
<b>County Use</b>		
<b>Stories</b>	<b>Basement</b>	<b>Type</b>
<b>Exterior</b>	<b>Quality</b>	<b>Full/Half Bath</b>
<b>Garage</b>	<b>Last Notice of Major Improvements</b>	
Value Information		
	<b>Base Value</b>	<b>Value</b>
		As of
		01/01/2018
<b>Land:</b>	1,988,800	1,988,800
<b>Improvements</b>	0	0
<b>Total:</b>	1,988,800	1,988,800
<b>Preferential Land:</b>	0	0
		<b>Phase-in Assessments</b>
		As of
		07/01/2019
		As of
		07/01/2020
		1,988,800
		1,988,800
Transfer Information		
<b>Seller:</b>	<b>Date:</b>	<b>Price:</b>
<b>Type:</b>	<b>Deed1:</b>	<b>Deed2:</b>
<b>Seller:</b>	<b>Date:</b>	<b>Price:</b>
<b>Type:</b>	<b>Deed1:</b>	<b>Deed2:</b>
<b>Seller:</b>	<b>Date:</b>	<b>Price:</b>
<b>Type:</b>	<b>Deed1:</b>	<b>Deed2:</b>
Exemption Information		
<b>Partial Exempt Assessments:</b>	<b>Class</b>	07/01/2019
		07/01/2020
<b>County:</b>	500	1,988,800.00
<b>State:</b>	500	1,988,800.00
<b>Municipal:</b>	500	0.00 0.00
		0.00 0.00
<b>Tax Exempt:</b> None	<b>Special Tax Recapture:</b> None	
<b>Exempt Class:</b> None		
Homestead Application Information		

# APPLICATION

*Prep.  
2/22/79  
9:30 AM  
cancelled*

SEWAGE DISPOSAL TESTING

A 29399

STATE OF MARYLAND - DEPARTMENT OF HEALTH AND MENTAL HYGIENE

P \_\_\_\_\_

HOWARD COUNTY HEALTH DEPARTMENT  
ENVIRONMENTAL HEALTH SERVICES  
P.O. BOX 476 ELLICOTT, MARYLAND 21043  
TELEPHONE: 992-2330

DISTRICT 2nd Election

DATE January 11, 1979

TO: THE COUNTY HEALTH OFFICER  
ELLICOTT CITY, MARYLAND

I, HEREBY, APPLY FOR THE NECESSARY TEST IN ORDER TO CONSTRUCT (OR RECONSTRUCT) A SEWAGE DISPOSAL SYSTEM.

PROPERTY OWNER Director, Department of Public Works, Howard County, Maryland  
3430 Court House Drive

ADDRESS George Howard Building, Ellicott City, MD. 21043 PHONE Kenneth L. Bolig  
992-2070

PROPERTY LOCATION Bureau of Engineering  
Project Engineer

SUBDIVISION \_\_\_\_\_ LOT NO. \_\_\_\_\_

ROAD AND DESCRIPTION Located on New Cut Road, North of Maryland Route 103

Present site of Howard County Landfill #1

SIZE OF LOT 11.00 ± Acres TYPE BLDG. Proposed County Employee Facility

THE SYSTEM INSTALLED UNDER THIS APPLICATION IS ACCEPTABLE ONLY UNTIL PUBLIC FACILITIES BECOME AVAILABLE.

I FULLY UNDERSTAND THE FEE CONNECTED WITH THE FILING OF THIS PERC TEST APPLICATION IS NON-REFUNDABLE UNDER

ANY CIRCUMSTANCES.

SIGNATURE OF APPLICANT Richard E. Freudenberger 1/12/79

APPROVED BY \_\_\_\_\_ FOR \_\_\_\_\_ DATE \_\_\_\_\_

REJECTED BY G. Keller FOR ANY/AREA TESTED DATE 10 Apr. 79


HOLD PENDING FURTHER TESTS \_\_\_\_\_ DATE \_\_\_\_\_

REASONS FOR REJECTION OR HOLDING Extensive grade cutting (10-20') - hard packed non-permeable soil, rock. (GLK)

# THIS IS NOT A PERMIT

SOIL PROFILE

0

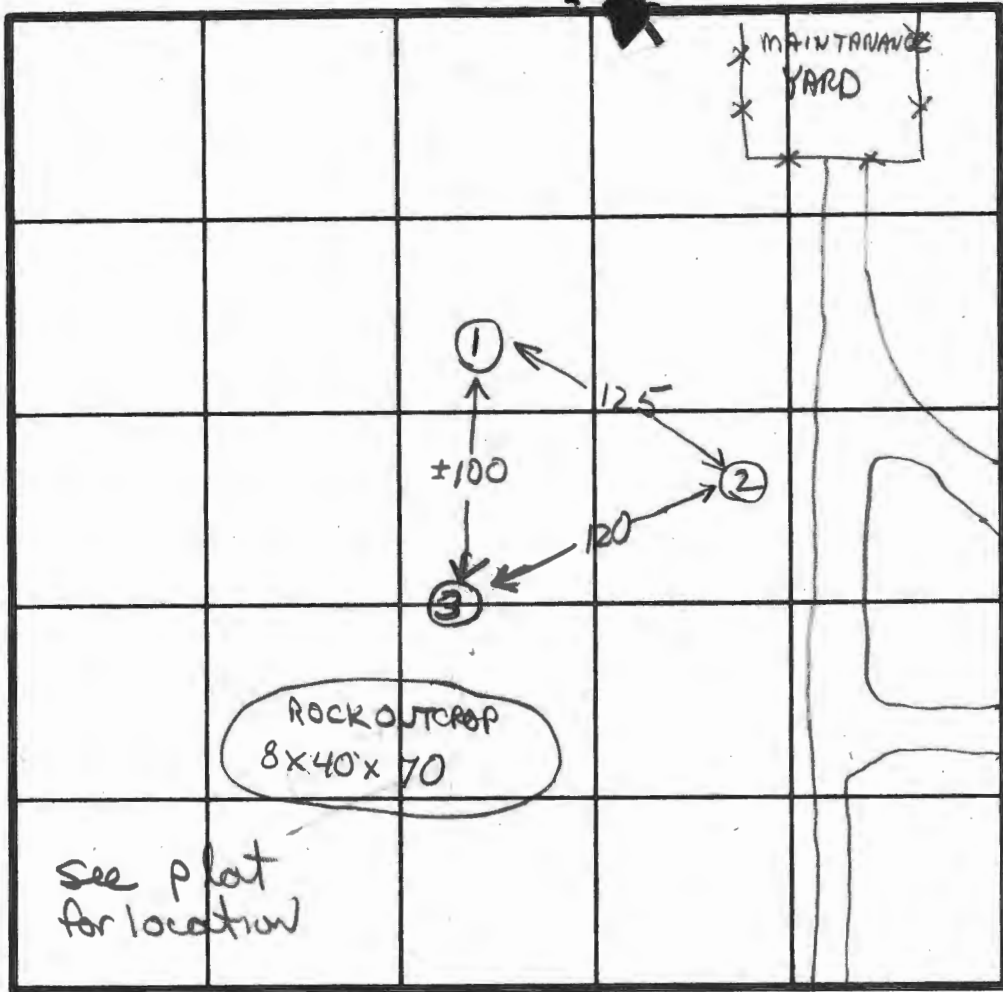

INDICATE NORTH - NAME ADJOINING ROADWAY AS BASE LINE.

NEW CUT ROAD

DATE	TEST NO.	DEPTH	PRE-WET		TEST - 1" DROP		TIME
			START	STOP	START	STOP	
4/10/79	15	2	1036	1106	1/4" drop - then NO drop - fairly		
	1D	9	Solid Rock				
	32	10	hard packed - veins of weathered rock				
	32	8	very hard packed - rock deep				

REMARKS (20+ feet) Extensive grade cutting - see tops on plat

VERY hard packed - parent material - silt loam

TESTED BY (GLK) 3 JS

ALSO PRESENT Bolig

# STATE OF MARYLAND

HOWARD COUNTY HEALTH DEPARTMENT  
ELLICOTT CITY, MARYLAND

Date

1/16 19 79

Name

Dept. of Public Works

Telephone No.

R. E. Freudenberger

DETAILED LOCATION OF SITE, DEVELOPMENT,  
SECTION, ROAD, LOT NO. & ELECTION DISTRICT

2nd  
New Cut Road - proposed  
County employee facility

PRIVATE SEWAGE DISPOSAL SYSTEMS

Testing and Inspection

\$

Installation Permit

\$

No charge

Received  
Payment

hs

ORIGINAL

A 29399

THIS RECEIPT IS NOT  
A PERMIT AND IT IS  
NOT A WARRANTY OF  
PERFORMANCE OF  
THE SYSTEM THAT  
IS INSTALLED.

