




Approved PLAN 11/8/2019


BUILD TO B.O.C.A  
POOL CODE

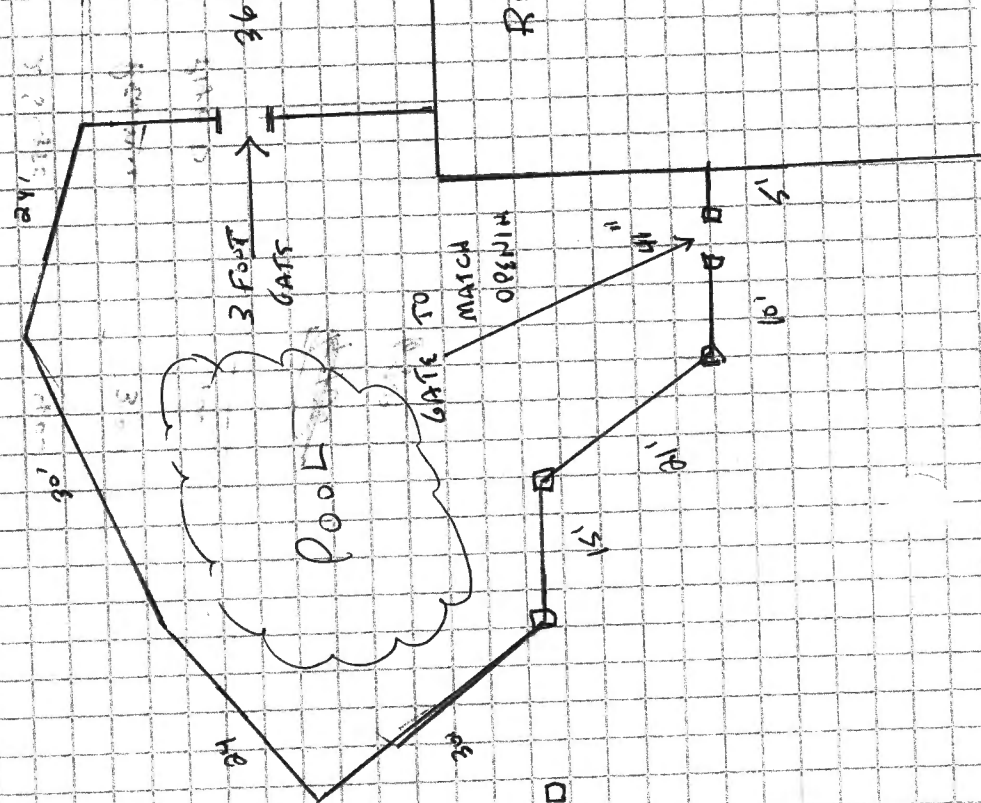

5  
4  
10  
21  
15  
30  
24  
30  
24  
30

199 LINEAL  
FOOT  
+  
(2) SINGLE GATE

13447  
20777  
CHRIS MAC C

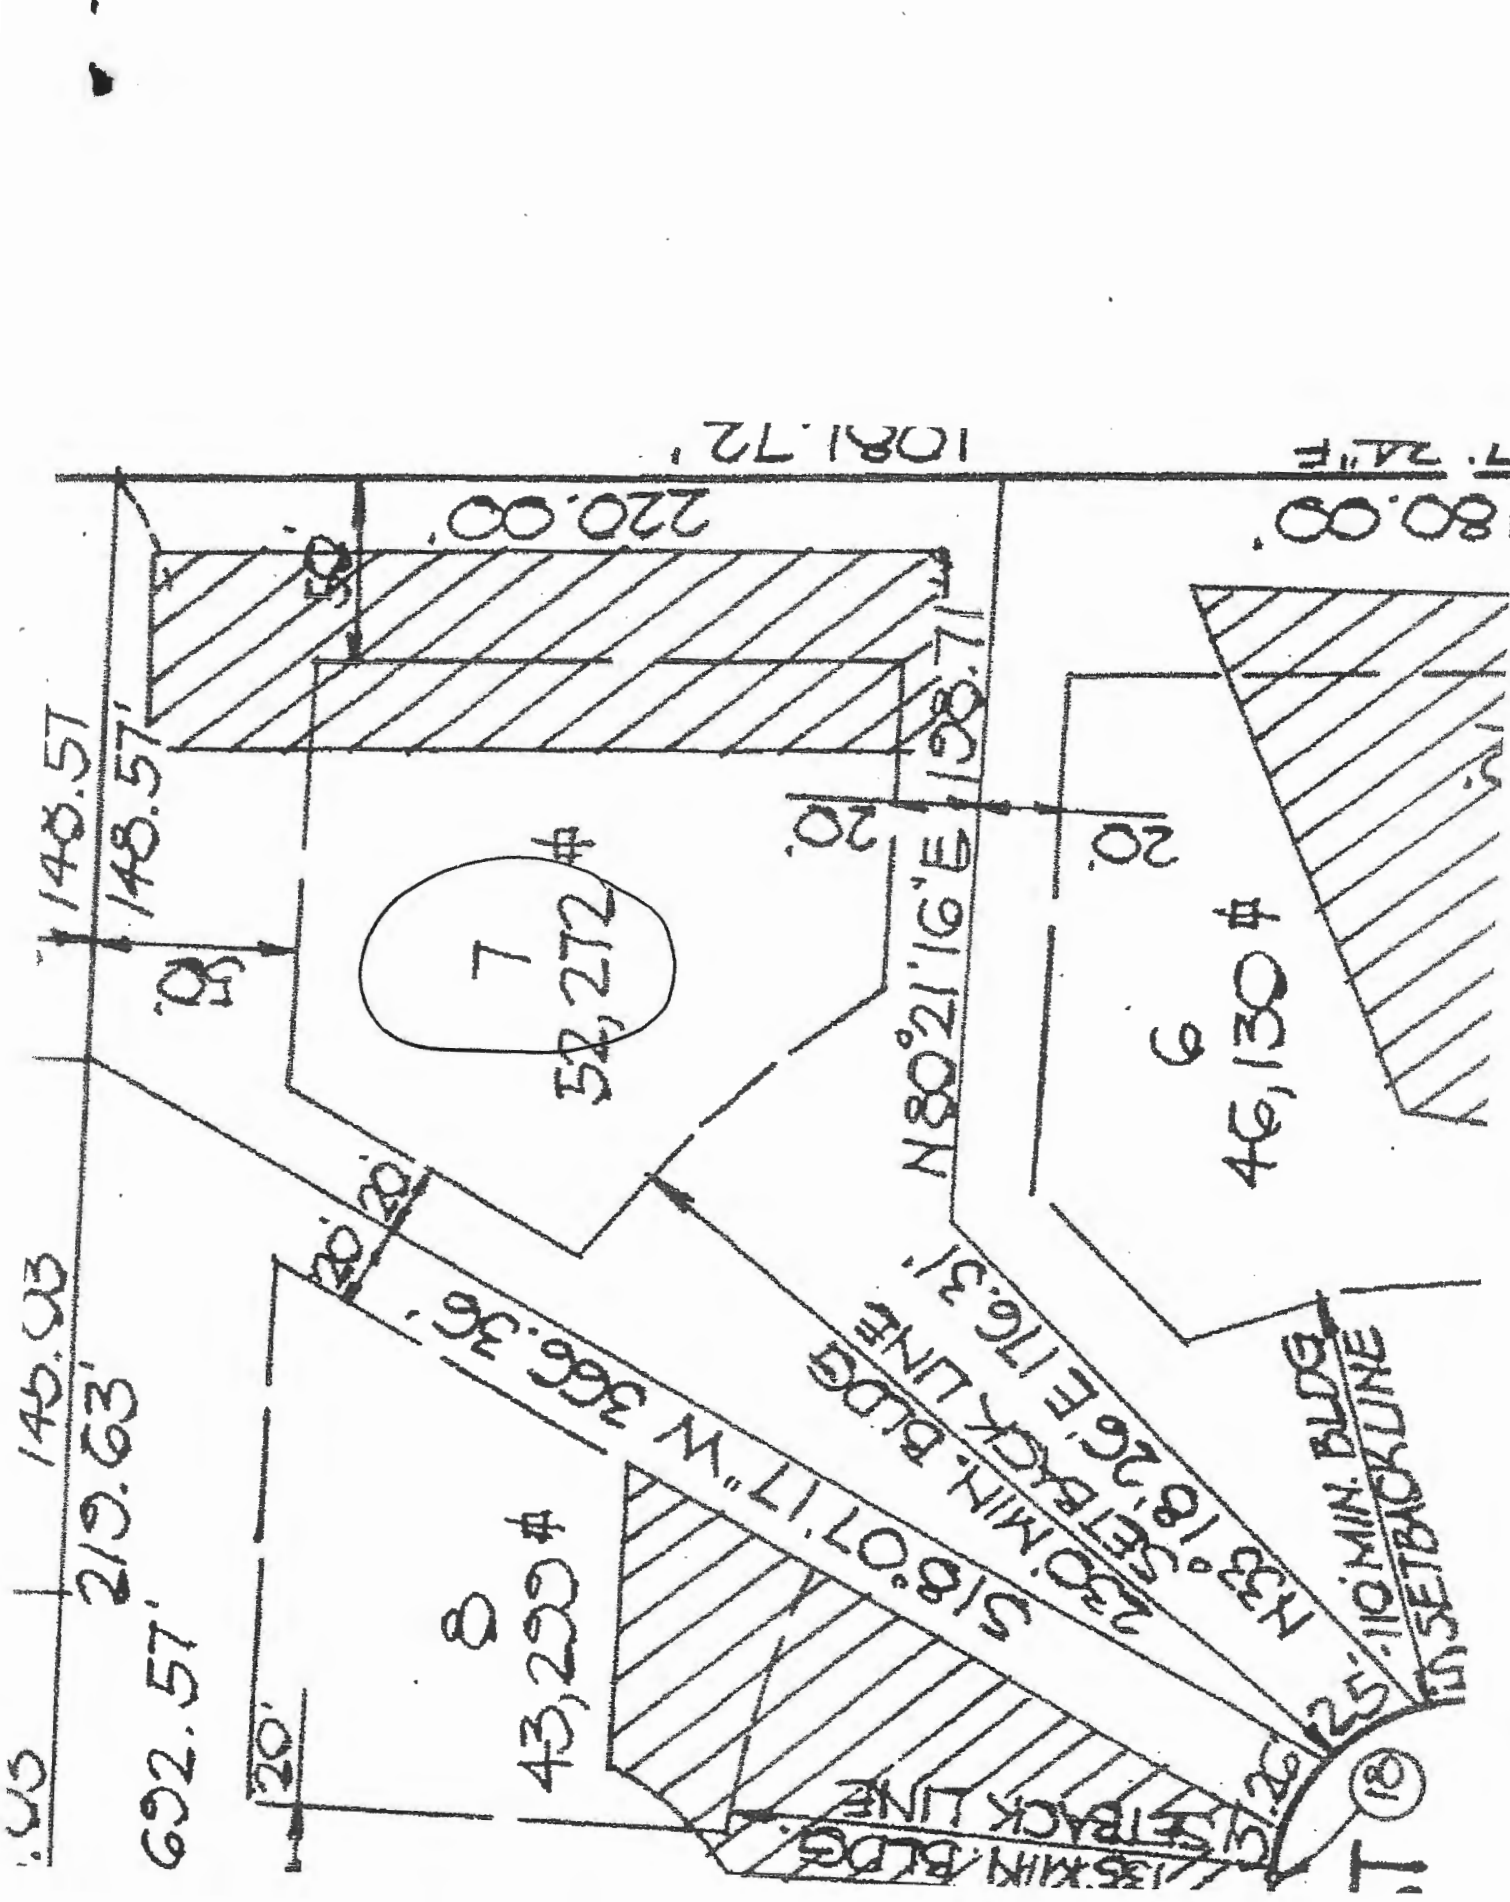

145.93  
219.63  
692.57

148.57  
148.57

8  
43,299 #

7  
52,272 #

6  
46,130 #

220.00

1081.72

80.00  
7.24" F

20'

20'

N80°21'16"E 198.71'

S18°07'17"W 366.36'  
230' MIN. BLDG SETBACK LINE

N33°18'26"E 176.31'  
133' MIN. BLDG SETBACK LINE

N33°10'11"W 125.11'  
110' MIN. BLDG SETBACK LINE

T 18

20'

30'

30'

20'

30'

30'

135' MIN. BLDG SETBACK LINE