

MARYLAND DEPARTMENT OF THE ENVIRONMENT, WATER MANAGEMENT ADMINISTRATION
 1800 Washington Blvd., Baltimore, Maryland 21230 (410) 537-3784

 WATER WELL ABANDONMENT-SEALING REPORT FORM

SUBMIT COPIES OF COMPLETED FORM TO:

- * COUNTY ENVIRONMENTAL AGENCY (contact MDE, WMA if address needed)
- * WELL OWNER
- * MDE, WATER MANAGEMENT ADMINISTRATION, WELL PROGRAM

Abandonment confirmed

3/26/15 SC

Well on property has 1-pc cap,
removable

DATE WELL ABANDONED: 11/28/2015 (month/day/year)

* PERMIT NUMBER OF ABANDONED WELL (if any) _____

* PERMIT NUMBER OF REPLACEMENT WELL: _____


* PERSON ABANDONING WELL: Richard A. Crummitt WELL DRILLER'S LICENSE NUMBER: W00014

CIRCLE: MWD / MSD / MGD

* OWNER'S NAME: Sophia Park

SITE LOCATION MAP

* WELL LOCATION:
 COUNTY: Howard
 NEAREST TOWN: Glenelg
 TAX MAP _____ BLOCK _____ PARCEL _____
 SUBDIVISION: _____
 SECTION: _____ LOT: _____
 STREET ADDRESS: 14034 BURNWOODS RD

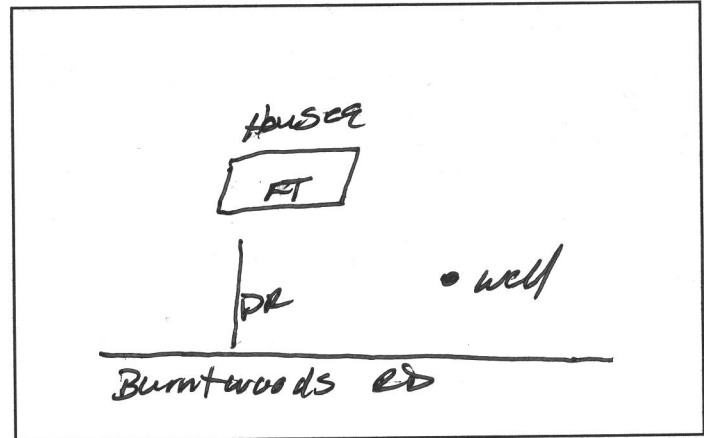

LATITUDE 39.276468

LONGITUDE 77.001962

- * TYPE OF WELL BEING ABANDONED:
 DRILLED JETTED
 BORED HAND DUG
 OTHER (specify) _____

LOG OF SEALING MATERIAL

- * USE CODE:
 DOMESTIC MUNICIPAL/PUBLIC
 IRRIGATION INDUSTRIAL
 TEST/OBSERVATION GEOTHERMAL

- * TYPE OF CASING:
 STEEL PLASTIC
 CONCRETE OTHER (specify) _____

SIZE OF CASING: 6 INCHES IN DIAMETER

DEPTH OF WELL: 98 FEET DEEP

WAS ANY CASING REMOVED? YES NO
 If yes, length removed, in feet: 3

WAS CASING RIPPED OR PERFORATED? YES NO

MATERIAL	FEET	
	FROM	TO
<u>Bentonite</u>	<u>98</u>	<u>1</u>
<u>Fill dirt</u>	<u>1</u>	<u>0</u>
VOLUME OF MATERIAL USED		
<u>7 bags Bentonite</u>		

Gene F. Eastman

 WATER WELL ABANDONMENT-SEALING REPORT FORM

SUBMIT COPIES OF COMPLETED FORM TO:

- * COUNTY ENVIRONMENTAL AGENCY (contact MDE, WMA if address needed)
- * WELL OWNER
- * MDE, WATER MANAGEMENT ADMINISTRATION, WELL PROGRAM

DATE WELL ABANDONED: 11/28/2015 (month/day/year)

* PERMIT NUMBER OF ABANDONED WELL (if any) _____

* PERMIT NUMBER OF REPLACEMENT WELL: _____

* PERSON ABANDONING WELL: Richard A. Crummitt WELL DRILLER'S LICENSE NUMBER: W00014
 CIRCLE: MWD / MSD / MGD


* OWNER'S NAME: Sophia Park

* WELL LOCATION:
 COUNTY: Howard
 NEAREST TOWN: Glenn
 TAX MAP _____ BLOCK _____ PARCEL _____
 SUBDIVISION: _____
 SECTION: _____ LOT: _____
 STREET ADDRESS: 14034 Burntwoods Rd

LATITUDE 39.226468

LONGITUDE 77.001962

SITE LOCATION MAP

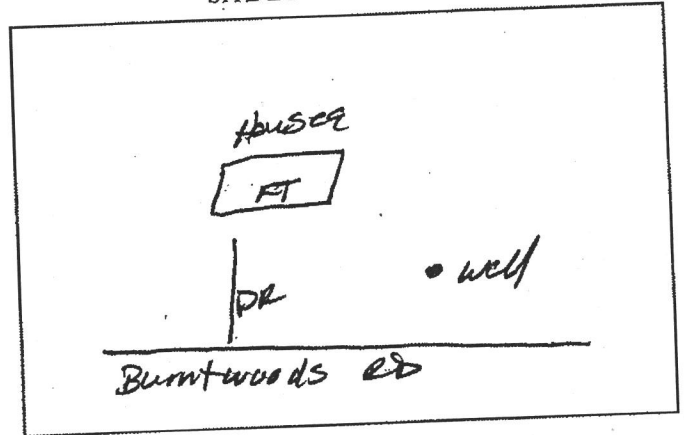

* TYPE OF WELL BEING ABANDONED:
 DRILLED _____ JETTED
 _____ BORED _____ HAND DUG
 _____ OTHER (specify) _____

* USE CODE:
 DOMESTIC _____ MUNICIPAL/PUBLIC
 _____ IRRIGATION _____ INDUSTRIAL
 _____ TEST/OBSERVATION _____ GEOTHERMAL

* TYPE OF CASING:
 STEEL _____ PLASTIC
 _____ CONCRETE _____ OTHER (specify) _____

SIZE OF CASING: 6 INCHES IN DIAMETER

DEPTH OF WELL: 98 FEET DEEP

WAS ANY CASING REMOVED? YES _____ NO
 If yes, length removed, in feet: 3

WAS CASING RIPPED OR PERFORATED? _____ YES NO

George F. Eastaugh
 SIGNATURE-MASTER WELL DRILLER OR SUPERVISING SANITARIAN LICENSE#

LOG OF SEALING MATERIAL

MATERIAL	FEET	
	FROM	TO
<u>Bentonite</u>	<u>98</u>	<u>1</u>
<u>Fill dirt</u>	<u>1</u>	<u>0</u>
VOLUME OF MATERIAL USED		
<u>7 bags Bentonite</u>		

040 MWD / MSD / MGS 1-29-15 *
 CIRCLE ONE DATE

L. Franklin Easterday, Inc.
 *****WELL DRILLING**GEOTHERMAL LOOPS**PUMPS & SERVICE*****
 9265 Brown Church Road
 Mt. Airy, Maryland 21771

301-824-1540
 PAID
 01/29/2015

1/28/2015

Sophia Park
 14034 Burntwoods Road
 Glenelg, Md 21737

14034 Burntwoods Road

Invoice #	1939	RN	2401	Terms	Net 10	Completion Date	1/28/2015	Permit #	P.O.#
Description						Quantity	Rate	Amount	
Labor and materials to abandon well							1,175.00	1,175.00	
<i>Completion report will be sent after receipt of payment in full</i>									
<i>Thank you for your business.</i>							Balance Due		\$1,175.00

Oswald, Hank

From: Sophia Park <s.park115@gmail.com>
Sent: Monday, February 02, 2015 3:40 PM
To: Oswald, Hank
Subject: Re: Invoice from Easterdays

They said the well that was furthest from the home was the one they abandoned. The one that is closer is the one that we are using.

-Sophia

On Mon, Feb 2, 2015 at 1:32 PM, Oswald, Hank <hoswald@howardcountymd.gov> wrote:

Hi Sophia:

Which well was it?

Hank

Hank Oswald, L.E.H.S.

Howard County Health Department

Bureau of Environmental Health

Well & Septic Program

410.313.1786

From: Sophia Park [mailto:s.park115@gmail.com]
Sent: Monday, February 02, 2015 1:31 PM
To: Oswald, Hank
Subject: Fwd: Invoice from Easterdays

Hi Hank,

Here is the email sent to us from the Well Company. Thanks again!

-Sophia Park

----- Forwarded message -----

From: **Sara Easterday** <saraeasterday@verizon.net>

Date: Thu, Jan 29, 2015 at 8:27 AM

Subject: Re: Invoice from Easterdays

To: Sophia Park <s.park115@gmail.com>

Good morning,

I have attached the paid invoice and the report. I have also mailed the report to the county with your copy mailed to you.

Thanks for your business! We greatly appreciate it!

Have a great day,

Sara

*Sara V Easterday
Administrative Assistant
L. Franklin Easterday, Inc.*

*Easterday Well & Pump
9265 Brown Church Road
Mt. Airy, Md. 21771
301-829-1640
301-829-2667-fax*

Saraeasterday@verizon.net

From: Sophia Park <s.park115@gmail.com>
To: "saraeasterday@verizon.net" <saraeasterday@verizon.net>
Sent: Wednesday, January 28, 2015 4:46 PM
Subject: Re: Invoice from Easterdays

Hi Sara,

I just called and made the payment with Mindy. If you can go ahead and mail the report out as soon as possible, I'd greatly appreciate it. Can you give me an email once you do so? Thanks so much!

-Sophia

On Wed, Jan 28, 2015 at 2:12 PM, <saraeasterday@verizon.net> wrote:

Hi Sophia,

Your invoice is attached. Once we receive payment I will mail the report to the county. You can send a check or call me with a credit card number if you would like.

Thank you for your business - we appreciate it very much.

Sincerely,

Sara

Sara V Easterday
Administrative Assistant
L. Franklin Easterday, Inc.
Easterday Well & Pump
9265 Brown Church Road
Mt. Airy, Md. 21771
301-829-1640
301-829-2667-fax

Saraeasterday@verizon.net