

APPLICATION

A 17509

SEWAGE DISPOSAL TESTING

P _____

MARYLAND STATE DEPARTMENT OF HEALTH

HOWARD COUNTY

ELLICOTT CITY

DISTRICT 5th

DATE 9/28/72

TO: THE COUNTY HEALTH OFFICER
ELLICOTT CITY, MARYLAND

I, HEREBY, APPLY FOR THE NECESSARY TESTS IN ORDER TO CONSTRUCT (OR RECONSTRUCT) A SEWAGE DISPOSAL SYSTEM.

PROPERTY OWNER Phase One, Ltd.

ADDRESS Urban Life Center, Columbia, Md.

PHONE 730-8200

PROPERTY LOCATION:

SUBDIVISION Adjacent to Clarksville Ridge

LOT NO. 11

ROAD AND DESCRIPTION Intersection of Route 32 and Whitegate Lane

OCCUPANT _____

PHONE _____

PERSON TO CONSTRUCT SYSTEM _____

ADDRESS _____

PHONE _____

SIZE OF LOT 5.2. acres

TYPE BLDG. 4 bedrooms

NUMBER OF BEDROOMS

IF NOT SINGLE RESIDENCE DESCRIBE _____

SIGNATURE OF APPLICANT /s/ William G. Rasch III

APPROVED BY _____

FOR _____

(KIND OF SYSTEM)

DATE _____

REJECTED BY _____

FOR _____

(KIND OF SYSTEM)


DATE _____

HOLD PENDING FURTHER TESTS _____

DATE _____

REASONS FOR REJECTION OR HOLDING _____

THIS IS NOT A PERMIT

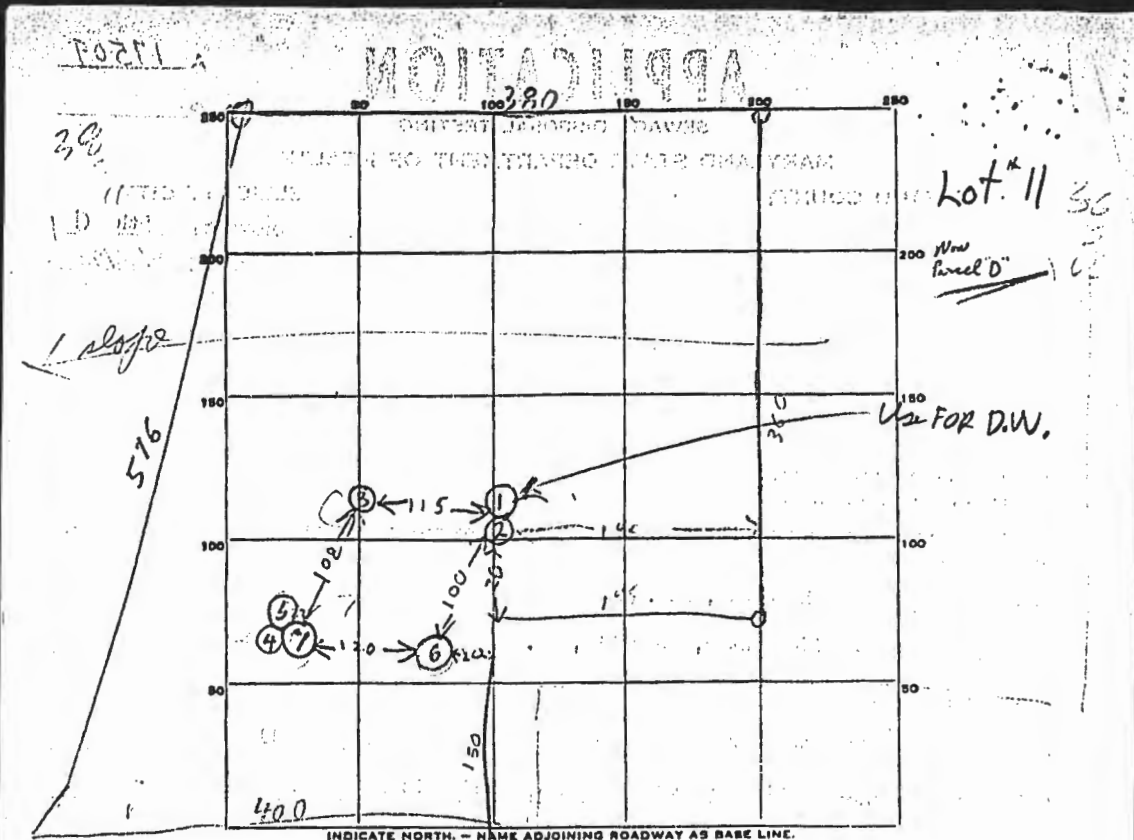

DATE	TEST NO.	DEPTH	PRE-WET		TEST - 1" DROP		TIME
			START	STOP	START	STOP	
1/15/72	1	3'	230	234	734	754	20
"	2	10 1/2'	218	234	734	745	12
"	3	11'	ALL SAND				
"	4	3 1/2'	256	308	Toil-Lug	Failure	
"	5	11'	200	228	213	319	10
"	6	10 1/2'	SAND		NO WATER		
"	7	4 1/2'	1017	1022	1022	1034	12
"	8						

max depth 4' 1/2'

average time 16 min

SOIL AUGER FINDING: Hold + chisel with Hodges (Use 45, + 7)

TESTED BY: ~~Streeter~~ Hodges on 10/17/72

REMARKS: Lot # 11