

DNR 214 9/71

SEQUENCE NO. **9974**  
(THIS NUMBER IS TO BE PUNCHED IN COLUMNS 6 ON ALL CARDS)

**STATE OF MARYLAND**  
**WATER RESOURCES ADMINISTRATION**  
**TAWES STATE OFFICE BLDG., ANNAPOLIS, MD: 21401**  
**WELL COMPLETION REPORT**

THIS REPORT MUST BE SUBMITTED WITHIN 30 DAYS AFTER WELL COMPLETION  
**FILL IN THIS FORM COMPLETELY**  
COUNTY NUMBER **W23293**

DATE RECEIVED (WRA USE ONLY) **May 26, 1976** DEPTH OF WELL **175**  
DATE WELL COMPLETED **05 16 75** (TO NEAREST FOOT) **28**  
PERMIT NO. FROM "PERMIT TO DRILL WELL" **40-74-1475**  
**28 29 30 31 32 33 34 35 36 37**  
DRILLER'S IDENTIFICATION NO. **256**

OWNER **Kramor, Robert & Nancy**  
LAST NAME FIRST NAME  
STREET OR RFD **5224 Everstar Place** POST OFFICE **Columbia, Maryland 21044**

WELL LOG		
STATE THE KIND OF FORMATIONS PENETRATED, THEIR COLOR, DEPTH, THICKNESS AND IF WATER BEARING		
DESCRIPTION (USE ADDITIONAL SHEETS IF NECESSARY)	FEET FROM	TO
Dirt	0	11
Soft Brown Mica	11	28
Soft Brown Mica	29	29
Soft Brown Mica	29	66
Hard Brown Sandstone	66	78
sandstone	78	79
Hard Brown Sandstone	79	92
Brown Sandstone	92	93
Blue Sandstone	93	130
Brown Sandstone	130	132
Blue Sandstone	132	175

**WELL DESCRIPTION**

**GROUTING RECORD**  
WELL HAS BEEN GROUTED (CIRCLE APPROPRIATE BOX) YES  NO   
TYPE OF GROUTING MATERIAL (CIRCLE BOX) CEMENT  BENTONITE CLAY   
NO. OF BAGS **33** NO. OF POUNDS **3,102**  
GALLONS OF WATER **198**  
DEPTH OF GROUT SEAL (TO NEAREST FOOT) FROM **0** FT. TO **70** FT.  
(ENTER 0 IF FROM SURFACE)

**CASING RECORD**  
CASING TYPES: INSERT APPROPRIATE CODE BELOW  
STEEL  CONCRETE   
PLASTIC  OTHER   
MAIN CASING TYPE:  S  T  
NOMINAL DIAMETER TOP (MAIN) CASING (NEAREST INCH) **6**  
TOTAL DEPTH OF MAIN CASING (NEAREST FOOT) **72**

**OTHER CASING (IF USED)**  
DIAMETER (INCH) FROM TO

**SCREEN RECORD**  
SCREEN TYPE OR OPEN HOLE: INSERT APPROPRIATE CODE BELOW  
STEEL  BRASS  OPEN HOLE   
PLASTIC  OTHER

**PUMPING TEST**  
HOURS PUMPED (TO NEAREST HOUR) **6**  
PUMPING RATE GALLONS PER MINUTE TO NEAREST GALLON **12**  
METHOD USED TO MEASURE PUMPING RATE **Flowmeter**  
WATER LEVEL (DISTANCE FROM LAND SURFACE) BEFORE PUMPING **54**  
WHEN PUMPING **130**  
TYPE OF PUMPED USE (CIRCLE APPROPRIATE BOX) (FOR PUMPING TEST)  
A AIR  P PISTON  T TURBINE   
C CENTRIFUGAL  R ROTARY  O OTHER (DESCRIBE BELOW)   
J JET  S SUBMERSIBLE

**PUMP INSTALLED**  
TYPE OF PUMP (WRITE APPROPRIATE LETTER IN BOX - SEE ABOVE: A, C, J, P, R, S, T, O)  
DRILLER WILL INSTALL PUMP (CIRCLE APPROPRIATE BOX) YES  NO   
CAPACITY: GALLONS PER MINUTE (TO NEAREST GALLON) **31** **39**  
PUMP HORSE POWER **37** **41**  
PUMP COLUMN LENGTH (NEAREST FOOT) **43** **47**  
CASING HEIGHT (CIRCLE APPROPRIATE BOX AND ENTER CASING HEIGHT)  
+ ABOVE  - BELOW   
LAND SURFACE **50** NEAREST FOOT **51**

**CIRCLE APPROPRIATE BOXES**  
A A WELL WAS ABANDONED AND SEALED WHEN THIS WELL WAS COMPLETED  
E ELECTRIC LOG OBTAINED  
P TEST WELL CONVERTED TO PRODUCTION WELL

I HEREBY CERTIFY THAT I HAVE COMPLIED WITH ALL CONDITIONS STATED ON THE ABOVE-CAPTIONED "PERMIT TO DRILL WELL", AND THAT INFORMATION CONTAINED IN THIS REPORT IS TRUE, ACCURATE, AND COMPLETE TO THE BEST OF MY KNOWLEDGE, INFORMATION AND BELIEF.

DRILLERS NAME  
PLEASE PRINT **Dana Kyker, Jr. II**  
SIGNATURE *Dana Kyker, Jr.*

**DEPTH (NEAREST WHOLE FOOT)**  
FROM **72** TO **175**

**DIAMETER OF SCREEN** **36** (NEAREST INCH) FROM TO

**GRAVEL PACK**

IF WELL DRILLED WAS A FLOWING WELL CIRCLE BOX  F


WRA USE ONLY (NOT TO BE FILLED IN BY DRILLER) (E.S.G.-1)  
LOG INDICATOR  TELESCOPE CASING

**LOCATION OF WELL ON LOT**  
SHOW PERMANENT STRUCTURE SUCH AS BUILDINGS, SEPTIC TANKS, AND/OR OTHER LAND MARKS AND INDICATE NOT LESS THAN TWO DISTANCES (MEASUREMENTS TO WELL).

*W211*  
*Cross Nest Rd.*

CFS

LOCATION OF HOUSE  
#11525 CROWS NEST ROAD  
PARCEL "D"  
CLARKSVILLE MEADOWS  
5TH ELECTION DISTRICT  
HOWARD COUNTY, MARYLAND


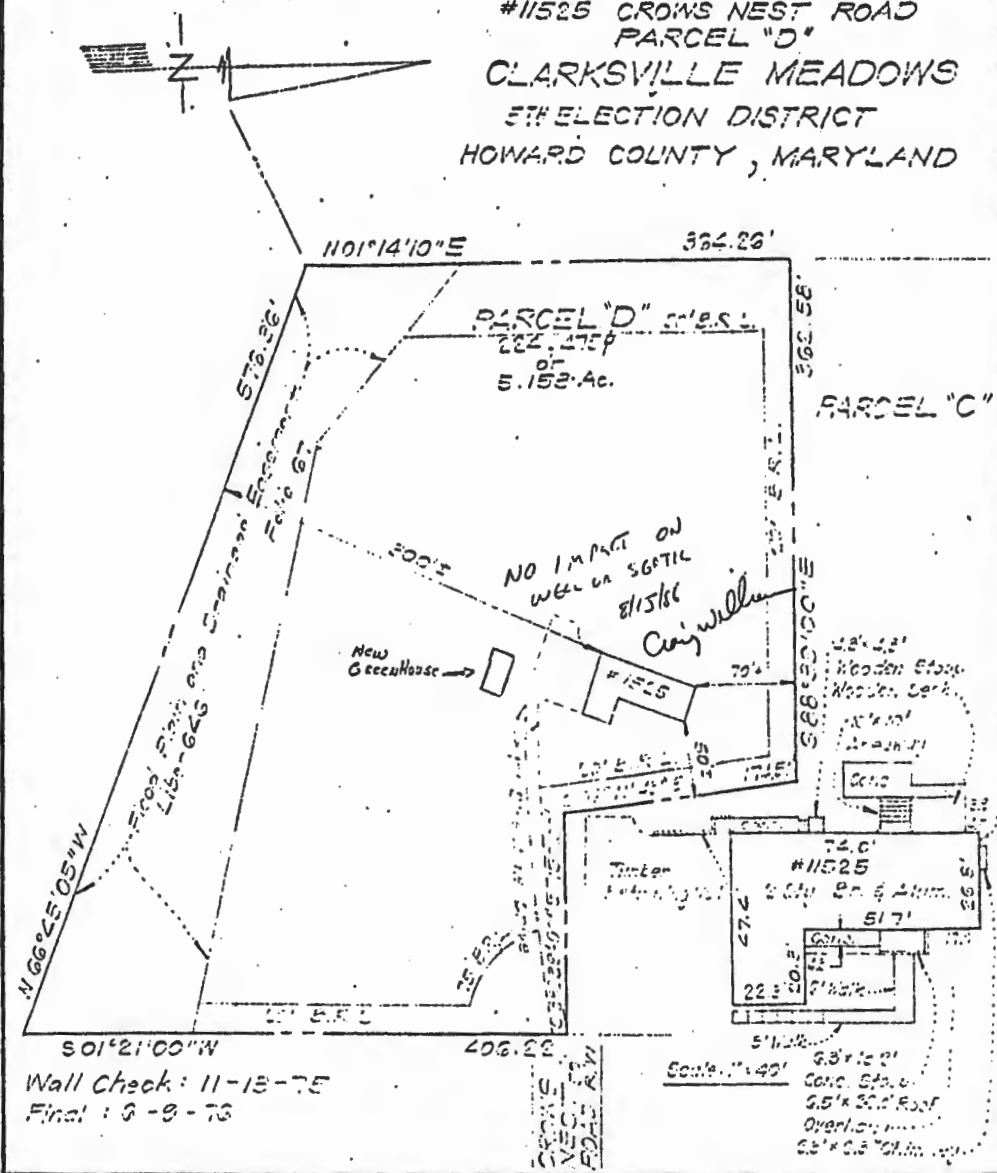


<p><b>SURVEYOR'S CERTIFICATE</b>          I hereby certify that the position of all existing improvements on the above described property have been carefully established by a transit-tape survey and that unless otherwise shown, there are no encroachments.</p> <p><i>Donald B. Sackett #6059</i></p>	<p><b>CLARK • FINEFROCK &amp; SACKETT</b>          ENGINEERS • PLANNERS • SURVEYORS          11315 LOCKWOOD DRIVE SILVER SPRING, MD. 20904          TEL. NO 593-3400</p>	
	<p>REFERENCE          Liber 646          Folio 67</p>	<p>DRAWN BY KWC          DATE 3-10-77          SCALE 1"=100'</p>

HOUSE LOCATION EXHIBIT  
**11525 W.CROWS NEST ROAD**  
 TAX MAP 41, GRID 2, PARCEL 394  
**CLARKSVILLE**  
 CLARKESVILLE (5th) ELECTION DISTRICT  
 HOWARD COUNTY, MARYLAND

SCALE: 1" = 40'

PLAT MERIDIAN  
 P.B.6 P.G.75

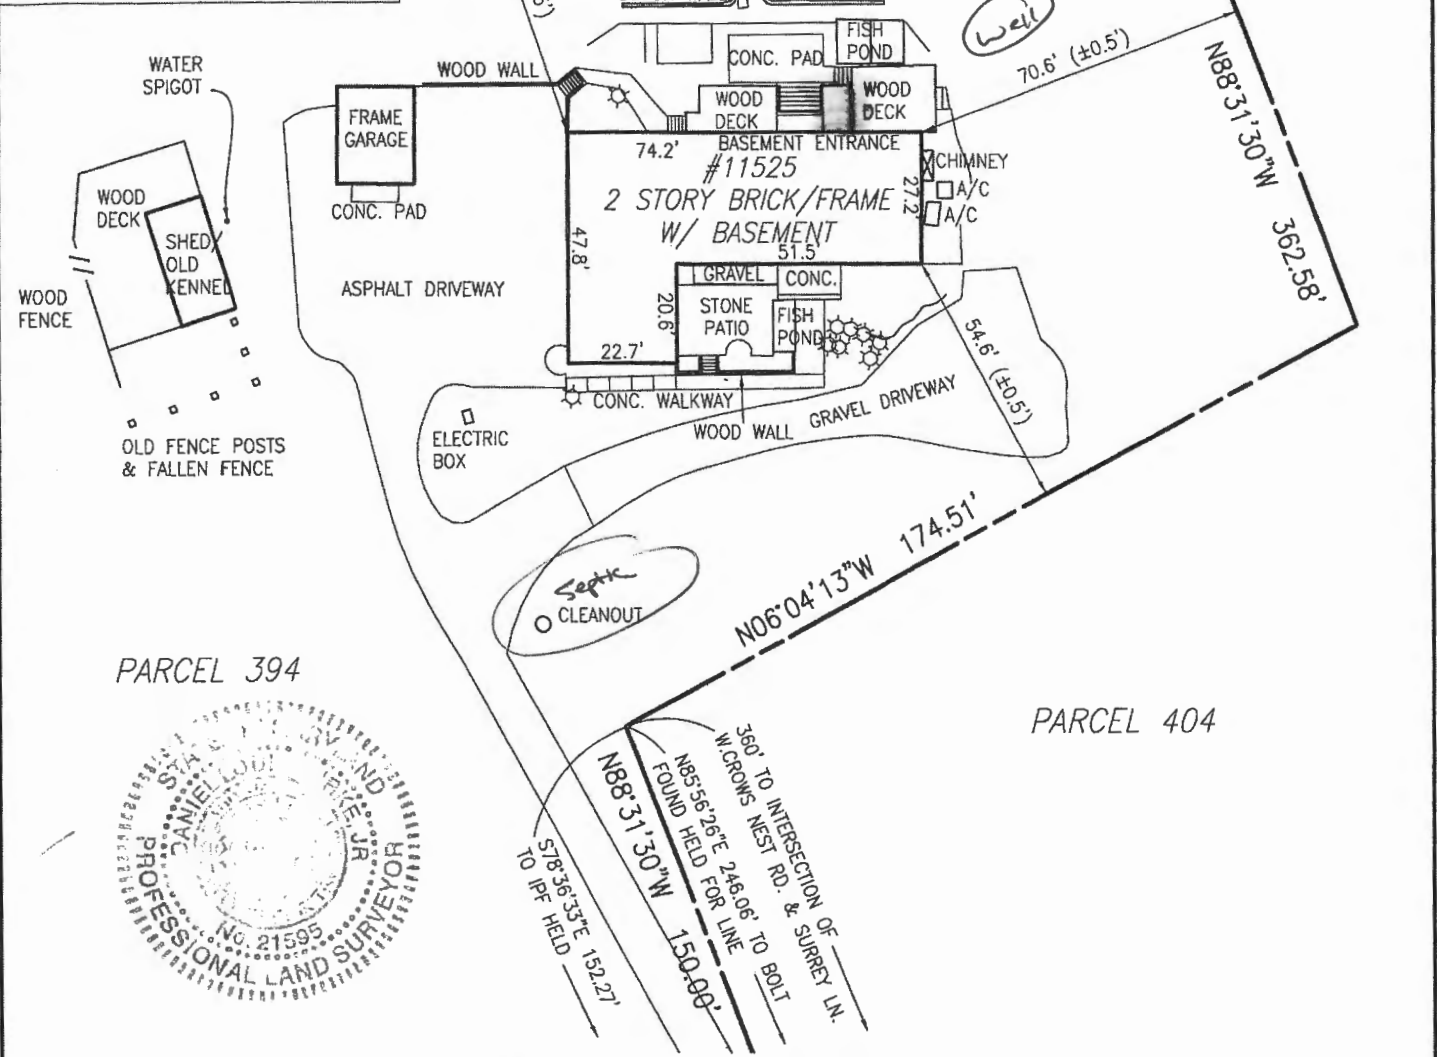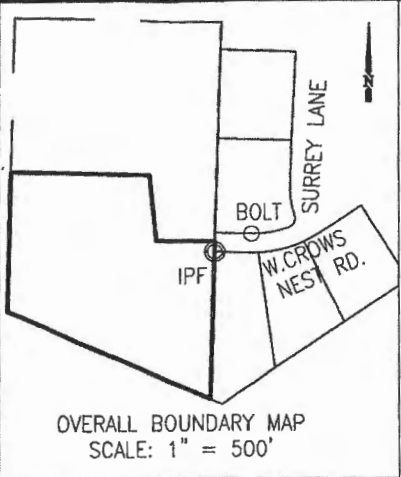

PARCEL 394

PARCEL 404



LOCATION SURVEY: 06/17/2019

**SURVEYOR'S CERTIFICATE:**

I HEREBY CERTIFY THAT THE INFORMATION SHOWN HEREON WAS OBTAINED USING ACCEPTED LAND SURVEYING PRACTICES; THAT THE BOUNDARY INFORMATION SHOWN HEREON IS TAKEN FROM AVAILABLE DEEDS AND RECORDS; THAT THIS PLAT AND THE SURVEY ON WHICH IT IS BASED WERE PREPARED UNDER MY RESPONSIBLE CHARGE AND ARE IN COMPLIANCE WITH COMAR REGULATION 09.13.06.12.

DATE: 07/01/2019

*DBJ*  
 DANIEL L. BURKE, JR.  
 PROFESSIONAL LAND SURVEYOR  
 MD LIC. # 21595 EXP. 01/17/2021

**CPJ Charles P. Johnson & Associates, Inc.**  
 Civil and Environmental Engineers • Planners • Landscape Architects • Surveyors  
 1751 Elton Rd., Ste. 300 Silver Spring, MD 20903 301-434-7000 Fax: 301-434-9394  
 www.cpj.com • Silver Spring, MD • Gaithersburg, MD • Annapolis, MD • College Park, MD • Frederick, MD • Fairfax, VA

REFERENCE	Drawn by ZT	Checked by DBJ
Plat Book	Date 07/01/2019	Record No.
Plat No.	Scale 1" = 40'	2019-1272-910