

Bureau of Environmental Health
8930 Stanford Boulevard, Columbia, MD 21045
Main: 410-313-2640 | Fax: 410-313-2648
TDD 410-313-2323 | Toll Free 1-866-313-6300
www.hchealth.org
Facebook: www.facebook.com/hocohealth
Twitter: HowardCoHealthDep

Maura J. Rossman, M.D., Health Officer

Handwritten signature/initials

APPLICATION
FOR PERCOLATION TESTING AND SITE EVALUATION

PROPERTY LOCATION

SUBDIVISION/PROPERTY NAME
PROPERTY ADDRESS 10620 Breezewood Drive Woodstock MD 21163
TAX ACCOUNT # 298590 TAX MAP 0010 GRID 0018 PARCEL 0183 LOT NO. 29 PROPOSED LOT SIZE (ACRES)
ZONING CATEGORY TIER

PROPERTY OWNER(S) Shirley White
DAYTIME PHONE CELL EMAIL
MAILING ADDRESS 10620 Breezewood Drive Woodstock MD 21163




APPLICANT Hatfields Equipment RELATIONSHIP TO OWNER: Contractor
DAYTIME PHONE 301 490 4289 CELL 410 989 4880 EMAIL khatfield@hatfieldsequipment.com
MAILING ADDRESS P O Box 519 Annapolis Junction MD 20701

I HEREBY APPLY FOR THE NECESSARY TESTING/EVALUATION PRIOR TO ISSUANCE OF SEWAGE DISPOSAL SYSTEM PERMIT(S):

- PROPERTY:
SUBDIVISION: NUMBER OF LOTS INCLUDING RESIDUE:
SUBDIVISION CLASSIFICATION (PER DEPT. OF PLANNING AND ZONING)
CONSTRUCT NEW OSDS ON UNDEVELOPED LOT
REPAIR OR REPLACE FAILING OSDS
UPGRADE EXISTING OSDS
BUILDING:
RESIDENTIAL WITH EXISTING OR PROPOSED BEDROOMS IN THE COMPLETED STRUCTURE
COMMERCIAL (PROVIDE DETAIL OF TYPE OF USE AND NUMBERS OF EMPLOYEES/CUSTOMERS ON ACCOMPANYING PLAN)
IS THE PROPERTY WITHIN 2500 FEET OF ANY RESERVOIR?
YES
NO

- AS APPLICANT, I UNDERSTAND THE FOLLOWING:
THIS APPLICATION IS VALID FOR TWO (2) YEARS FROM DATE OF FEE PAYMENT AND APPROVAL IS BASED UPON HEALTH OFFICER SIGNATURE OF A PERC CERTIFICATION PLAN PRIOR TO EXPIRATION OF THIS PERMIT.
THE APPLICATION FEE IS NON-REFUNDABLE
THIS APPLICATION MUST BE ACCOMPANIED BY ALL APPLICABLE FEES AND A SUITABLE SITE PLAN IN ORDER TO BE PROCESSED
THIS IS A PUBLIC DOCUMENT

I declare and affirm that to the best of my knowledge, the information contained herein is correct. I declare that I am the owner of the property or duly authorized to make this application on behalf of the owner. I agree to comply with all applicable state and county regulations.
By signature of this application, I hereby grant Howard County Health Department officials the right to enter onto the property for the purpose of inspecting the property as directly related to the requested permit/service.
Signature of Applicant: K. Hatfield
Date: 9-26-19

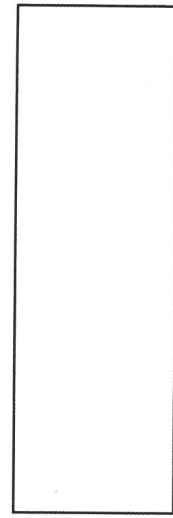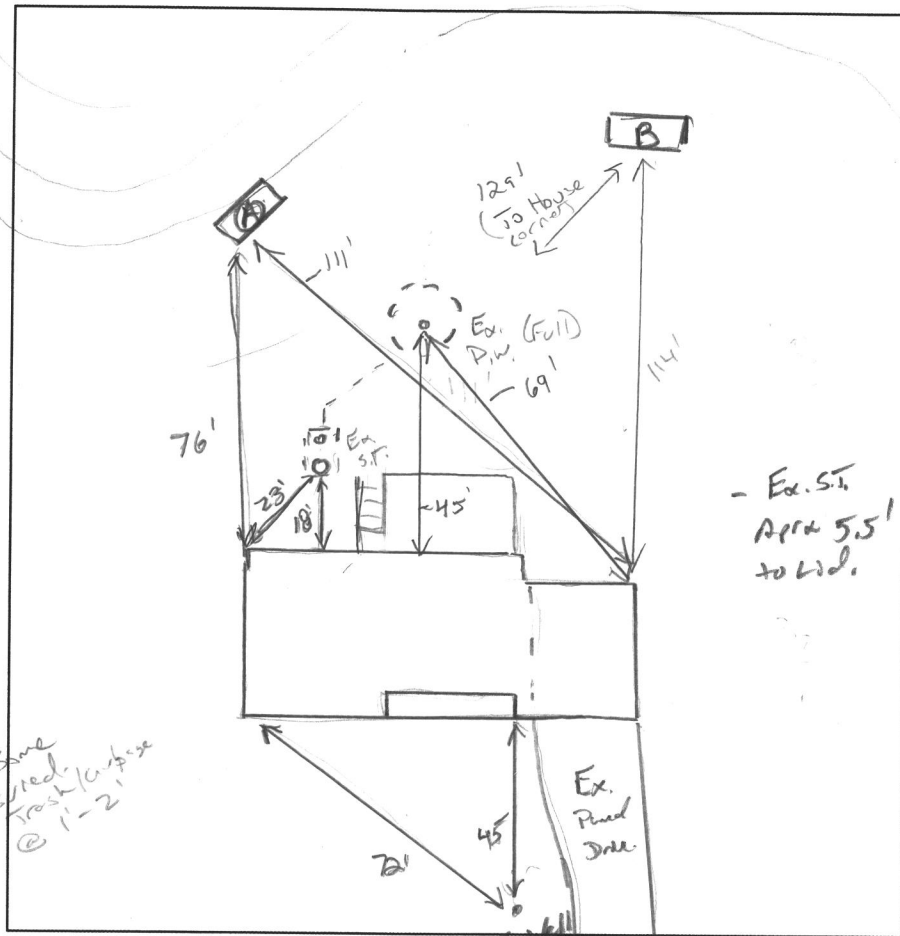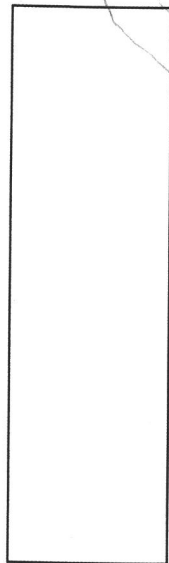

- (A)
- 16" Drk Br L MSOK, roots
 - Br CL WK Co. SAK Frable roots 15% Otachner
 - 4" Br/R L WK Co SAK Frable, 15% short chains 10% grass sprouts
 - 7" 1. Br/R SL WK Copl. (ascars)
 - 9" 11 Br/R/Y FSL
 - 11" WK FPL, 10% grass roots
 - 14" H₂O seep
- ← Same Pined. trash/curb @ 1'-2'
- ← water seep

- (B)
- 1: Br/CL WK Co SAK roots 2'
 - 1: Br/Y L WK Co SAK Frable, Dry roots, may 4'
 - 1: Br/Y/Rd SL, WK Copl. Frable, misc 7'
 - 1: Ar/Y FSL WK FPL, Frable, highly misc 14'

DATE	TEST #	DEPTH	START	BREAK 1" DROP	STOP 2" DROP	TIME OF 2ND INCH	P/F/H
10/3/19	(A)	6' 1/4"	00:17	00:19	00:21	2	P
		Re-Par	00:21	00:23	00:26	3	P
	(B)	visual		OK			P
		(Perc A) located in slud					
		sumb)					

REMARKS A = water seep @ 11' hole removed open 2 hrs located in sunde
 SANITARIAN K. Wolf BACKHOE Fannie OTHERS Helper

TEST HOLES USED IN SDA 2 AVG. PERC TIME 2:5 SQ. FT/BR 1.2 sq ft/ft²
 TRENCH WIDTH 3 INLET DEPTH 2 MAX. BOT DEPTH 6 EFFECTIVE SW 4

3BR Design = 450 JN

Perc A Design = $\frac{450}{1.2} = 375 \div 3 = 125$
 $125 \cdot (.62) = 77.5$

Perc B Design = $\frac{450}{1.2} = 375 \div 2 = 187.5$
 $4'-9" =$

(Perc A only)

Real Property Data Search (w4)

Search Result for HOWARD COUNTY

View Map		View GroundRent Redemption			View GroundRent Registration				
Tax Exempt: None		Special Tax Recapture: None							
Exempt Class: None									
Account Identifier:		District - 03 Account Number - 298590							
Owner Information									
Owner Name:		WHITE SHIRLEY M			Use:		RESIDENTIAL		
Mailing Address:		10620 BREEZEWOOD DR WOODSTOCK MD 21163-1318			Principal Residence:		YES		
					Deed Reference:		/01957/ 00491		
Location & Structure Information									
Premises Address:		10620 BREEZEWOOD DR WOODSTOCK 21163-0000			Legal Description:		LOT 29 1.16 A 10620 BREEZEWOOD DR BREEZEWOOD FARMS SEC TWO		
Map:	Grid:	Parcel:	Neighborhood:	Subdivision:	Section:	Block:	Lot:	Assessment Year:	Plat No:
0010	0018	0183	3010103.14	0003			29	2019	Plat Ref:
Special Tax Areas: None					Town:		None		
					Ad Valorem:		100		
					Tax Class:		None		
Primary Structure Built		Above Grade Living Area		Finished Basement Area		Property Land Area		County Use	
1968		1,483 SF		235 SF		1.1600 AC			
Stories	Basement	Type	Exterior	Quality	Full/Half Bath	Garage	Last Notice of Major Improvements		
1	YES	STANDARD UNIT	FRAME/	4	1 full/ 1 half	1 Attached			
Value Information									
		Base Value		Value		Phase-in Assessments			
				As of		As of		As of	
				01/01/2019		07/01/2019		07/01/2020	
Land:		157,800		206,600					
Improvements		194,200		188,400					
Total:		352,000		395,000		366,333		380,667	
Preferential Land:		0						0	
Transfer Information									
Seller: WHITE GERALD WAYNE & WF				Date: 02/09/1989			Price: \$0		
Type: NON-ARMS LENGTH OTHER				Deed1: /01957/ 00491			Deed2:		
Seller:				Date:			Price:		
Type:				Deed1:			Deed2:		
Seller:				Date:			Price:		
Type:				Deed1:			Deed2:		
Exemption Information									
Partial Exempt Assessments:		Class		07/01/2019		07/01/2020			
County:		000		0.00					
State:		000		0.00					
Municipal:		000		0.00 0.00		0.00 0.00			
Tax Exempt: None		Special Tax Recapture: None							
Exempt Class: None									
Homestead Application Information									
Homestead Application Status: Approved 01/19/2010									



HOWARD COUNTY HEALTH DEPARTMENT

66361

DATE 9/10/19

AS

Received From

Hathhelds Equip.

PHONE #

301 490-4259

For

Repair Perc/1020
Branford Ave.

CASH

CHECK

NO.

4226

One hundred and 45/100 Dollars

\$

105.00

Received By

Kemp