

Bureau of Environmental Health
 8930 Stanford Boulevard, Columbia, MD 21045
 Main: 410-313-2640 | Fax: 410-313-2648
 TDD 410-313-2323 | Toll Free 1-866-313-6300
www.hchealth.org
 Facebook: www.facebook.com/hocohealth

Maura J. Rossman, M.D., Health Officer

RECEIPT DATE: 12/2/19 **ONSITE SEWAGE DISPOSAL SYSTEM** P 566478

APPROVAL DATE: 12/19/19 ⁵³ **PERMIT: MINOR REPAIR** A _____

PROPERTY ADDRESS: 5039 Gaithers Chance Drive

SUBDIVISION: Gaither's Chance LOT: 16 TAX ID: 05-598962

CONTRACTOR: South Carroll Backhoe EMAIL: scbackhoe@comcast.net

CONTRACTOR ADDRESS: 4410 Salem Bottom Road, Westminster, MD 21157 PHONE: 410-596-3618

PROPERTY OWNER: Indra Asserfea EMAIL: _____

OWNER ADDRESS: 5039 Gaithers Chance Drive, Clarksville, MD 21029 PHONE: 203-461-1616

SEPTIC TANK SIZE (GALLONS): _____ PUMP CHAMBER CAPACITY (GALLONS): _____ PUMP SIZE: _____

NUMBER OF BEDROOMS: _____ HOUSE SQ. FT. _____ APPLICATION RATE: _____

DISTRIBUTION SYSTEM: GRAVITY FED LOW PRESSURE DOSED

TRENCHES:	LINEAR FEET REQUIRED: _____	INLET DEPTH: _____
	TRENCH WIDTH: _____	MAXIMUM BOTTOM DEPTH: _____
	MINIMUM SPACE BETWEEN TRENCHES: _____	EFFECTIVE AREA BEGINNING DEPTH: _____

LOCATION: **TO BE STAKED BY SANITARIAN DURING PRE-CONSTRUCTION INSPECTION.**


NOTES:
 1. Remove existing cleanout to 1-2 feet depth and give a cap onto the former cleanout's rising pipe.
 2. Install a new, two-way cleanout in SHC, ^{pre-12} at last bend before septic tank. Call for inspection before covering. *VB*

ISSUED BY: R Bricker ISSUE DATE: _____ EXPIRATION DATE: 12/2/20

- NOTE: CONTRACTOR MUST SCHEDULE A PRE-CONSTRUCTION INSPECTION PRIOR TO BEGINNING ANY INSTALLATION
- NOTE: CONTRACTOR MUST SCHEDULE AN INSPECTION AND GAIN APPROVAL OF ALL COMPONENTS PRIOR TO COVERING
- NOTE: STONE MUST BE APPROVED BY HEALTH DEPARTMENT AND GRAVEL TICKET MUST BE AVAILABLE FOR REVIEW.
- NOTE: WATERTIGHT SEPTIC TANKS REQUIRED
- NOTE: ALL PARTS OF SEPTIC SYSTEM SHALL BE AT LEAST 100 FEET DOWNGRADIENT FROM ANY WATER WELL
- NOTE: MANHOLE RISERS REQUIRED ON ALL SEPTIC TANKS AND PUMP CHAMBERS
- NOTE: AN ELECTRICAL PERMIT IS REQUIRED FOR INSTALLATION OF ANY ELECTRICAL COMPONENTS OF THE SYSTEM
 ELECTRICAL PERMIT ISSUED E N.A.
- NOTE: THE HCHD DOES NOT WARRANT ANY SYSTEM AND CANNOT GUARANTEE THE PERFORMANCE OF THIS SYSTEM AS DESIGNED. BY ACCEPTING THIS PERMIT, THE OWNER AND/OR APPLICANT ACKNOWLEDGE THAT THE SPECIFICATIONS DETAILED IN THIS DESIGN ARE ONE POSSIBLE OPTION AND THAT THE HCHD WILL REVIEW OTHER PROPOSALS. YOU HAVE THE OPTION TO SEEK THE ADVICE OF A QUALIFIED DESIGN CONSULTANT OR PROFESSIONAL ENGINEER FOR FURTHER GUIDANCE.
- NOTE: MDE RECOMMENDS SEPTIC TANKS, BAT, AND OTHER PRETREATMENT UNITS BE PUMPED AT A FREQUENCY ADEQUATE TO ENSURE THAT SOLIDS ARE NOT DISCHARGED TO THE DISPOSAL AREA

**NEITHER THE HOWARD COUNTY COUNCIL NOR THE HEALTH DEPARTMENT IS RESPONSIBLE FOR THE SUCCESSFUL OPERATION OF ANY SYSTEM.
 PERMITTEE RESPONSIBLE FOR OBTAINING FINAL APPROVAL ON THIS PERMIT.
 CALL 410-313-1771 TO SCHEDULE INSPECTIONS.**

NOT TO SCALE

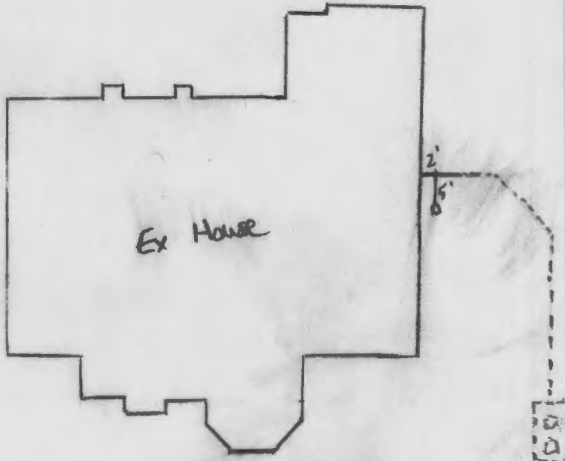

ROAD NAME

TRENCH/DRAINFIELD DATA

WIDTH	INLET	BOTTOM
_____	_____	_____
NUMBER OF TRENCHES _____		
TOTAL LENGTH _____		
ABSORPTION AREA _____		
DISTRIBUTION BOX LEVEL _____		
DISTRIBUTION BOX BAFFLE _____		
DISTRIBUTION BOX PORT _____		

SEPTIC TANK DATA

SEPTIC TANK 1 LEVEL _____

MANUFACTURER _____

CAPACITY _____ GAL

SEAM LOC _____

TANK LID DEPTH _____

BAFFLES _____

BAFFLE FILTER _____

MANHOLE LOC _____

6" PORT LOC _____

WATERTIGHT TEST _____

SLOTTED _____

DATE ON LID _____

PUMP/SEPTIC TANK LEVEL _____

MANUFACTURER _____

CAPACITY _____ GAL

SEAM LOC _____

TANK LID DEPTH _____

BAFFLES _____

BAFFLE FILTER _____

MANHOLE LOC _____

6" PORT LOC _____

WATERTIGHT TEST _____

SLOTTED _____

DATE ON LID _____

PRE-CONSTRUCTION:

INSTALLATION: 12/19/19 clean out moved 5' down from sewer line to make room for a walkway. OK to back fill. (SD)

FINAL INSPECTOR Susan Thomas

DATE OF APPROVAL 12/19/19

Bricker, Robert

From: Bricker, Robert
Sent: Monday, December 02, 2019 2:17 PM
To: Indra Asserfea
Subject: RE: septic system contractors

Dear Ms. Asserfea,

The existing cleanout will have to be cut off about 1-2 feet beneath the soil surface and a cap glued onto the rising pipe so that no soil can enter into your septic tank. Then, the cutoff cleanout must be replaced in another location on the SHC: a new two-way cleanout must be installed and the best place is probably at the last bend before the septic tank.
Robert Bricker, REHS/RS, L.E.H.S.

From: Indra Asserfea <indra_asserfea@yahoo.com>
Sent: Wednesday, November 27, 2019 12:22 PM
To: Bricker, Robert <RBricker@howardcountymd.gov>
Subject: Re: septic system contractors

[Note: This email originated from outside of the organization. Please only click on links or attachments if you know the sender.]

Thank you so much for the references. Would you also be posting the details of what specially needs to be done please as I would like to show the contractors when they come out next week. I have three bids lined up.

Thanks again and happy Thanksgiving!

Indra Asserfea
(203)461-1616
<http://www.illanabarran.com>
<http://www.aaronsethbooks.com>

On Wednesday, November 27, 2019, 08:50:29 AM EST, Bricker, Robert <rbricker@howardcountymd.gov> wrote:

See attached PDF

ROBERT BRICKER, REHS/R.S., L.E.H.S.

ENVIRONMENTAL SANITARIAN II

BUREAU OF ENVIRONMENTAL HEALTH, WELL AND SEPTIC PROGRAM

8930 STANFORD BLVD., COLUMBIA, MD 21045

Phone: Desk, 410-313-2691; Program, 410-313-1771; Bureau, 410-313-1774

Fax: 410-313-2648

E-mail: rbricker@howardcountymd.gov



CONFIDENTIALITY NOTICE

This message and the accompanying documents are intended only for the use of the individual or entity to which they are addressed and may contain information that is privileged, confidential, or exempt from disclosure under applicable law. If the reader of this email is not the intended recipient, you are hereby notified that you are strictly prohibited from reading, disseminating, distributing, or copying this communication. If you have received this email in error, please notify the sender immediately and destroy the original transmission.



Bureau of Environmental Health

8930 Stanford Boulevard, Columbia, MD 21045

Main: 410-313-2640 | Fax: 410-313-2648

TDD 410-313-2323 | Toll Free 1-866-313-6300

www.hchealth.org

Facebook: www.facebook.com/hocohealth

Twitter: HowardCoHealthDep

Dr. Maura J. Rossman, M.D., Health Officer

INFORMATION FORM - SEPTIC SYSTEM REPAIR/UPGRADE

Reason for Request:

- Reason for Request:
- [] Failing System
- [x] System relocation for proposed addition
- [] System upgrade for proposed addition
- [] Inadequate treatment zone
- [] Collapsed septic tank
- [] Collapsed drywell

Has the septic tank been pumped within the last month?

- Has the septic tank been pumped within the last month?
- [] Yes
- [x] No

Date pumped: New House as of 7/10/19

Was a visual inspection of the septic tank and/or drain fields conducted?

- Was a visual inspection of the septic tank and/or drain fields conducted?
- [x] Yes
- [] No

Explain observations: newly built house

Was a visual inspection of the sewage line conducted?

- Was a visual inspection of the sewage line conducted?
- [x] Yes

Blockage leading to the tank

- Blockage leading to the tank
- [] Yes. Explain:
- [x] No

Blockage leading to the field

- Blockage leading to the field
- [] Yes Explain:
- [x] No

Existing system design

- Existing system design
- [] Drywell
- [] Trench
- [] Mound
- [] Unknown
- [] Other:

Is discharge surfacing on the ground?

- Is discharge surfacing on the ground?
- [] Yes
- [x] No

- Additional Comments:

*For REPAIRS, are the owners proposing, or do they plan to add in the future, any additions or modifications to the property, i.e. pools, living space additions, garages, etc? This information must be disclosed at the time of this application. The Health Department will not be able to accommodate requests in the field for property modifications unrelated to the repair request. Such requests may require an additional fee, testing, and submittal of a Percolation Certification Plan, if the property does not meet current Code and Regulation.

Septic Contractor: South Carroll Bedchord Contractor's Phone: 410-875-4197
Contractor's Address: 4410 Salem Bottom Road, Westminister, MD 21057
Property Address: 5039 Gaitners Chase Drive, Clarksville, MD
Subdivision: Gaitners Chase Lot: 76 Year Built: 2019
Owner's Name: Indira Azgerfea Owner's Phone: 203-461-1616
Name of previous owners: N/A Existing bedrooms: 4
Proposed bedrooms: 2

Has this request been previously discussed with a Sanitarian? (Name):
Public Sewer available/nearby: No

*A Sanitarian will be in contact within three business days, depending upon the urgency of the situation, to coordinate the scheduling/review of the repair or upgrade.

Prior to scheduling inspections, sealed plans should be submitted to clarify the nature of the addition.

Print out a copy of Real Property Data via Dept. of Taxation website Indexed file found

If public sewer may be nearby, verify whether sewer is technically "available" through the Bureau of Engineering.

If sewer is available and the property is within the Metropolitan District, connection to sewer is required. If the owner believes reason for exemption exists, the owner should justify the request in writing.

If soil/site conditions are limited and sewer and/or Metro District status is not conducive to connection, the Sanitarian may recommend pursuit of Emergency Sewer Extension or Emergency Metro District Inclusion. The Owner should contact the Bureau of Utilities for details.

No permit is to be issued nor inspection to be scheduled without prior fee collection at the office unless an emergency situation exists.

The contractor is to notify office of the emergency situation as soon as possible.



HOWARD COUNTY HEALTH DEPARTMENT

66478

DATE
2/15/19

PS

Received From

Indira S. D'Souza

PHONE #

203 461-1616

For

Menor Repair -

5039 Carvers

Change

Fifty Five

Dollars

CASH

CHECK

NO.

1510

\$

55 00

Received By

J King