

APPLICATION

FOR PERCOLATION TESTING AND SITE EVALUATION

TEST DATE(S) _____ TEST TIME _____

AP 531370-M

AGENCY REVIEW: _____

DATE 6-28-12

DO NOT WRITE ABOVE THIS LINE

I HEREBY APPLY FOR THE NECESSARY TESTING/EVALUATION PRIOR TO ISSUANCE OF SEWAGE DISPOSAL SYSTEM PERMIT(S) TO:

CHECK AS NEEDED:

- CONSTRUCT NEW SEPTIC SYSTEM(S)
- REPAIR/ADD TO AN EXISTING SEPTIC SYSTEM
- REPLACE AN EXISTING SEPTIC SYSTEM

CHECK AS NEEDED:

- NEW STRUCTURE(S)
- ADDITION TO AN EXISTING STRUCTURE
- REPLACE AN EXISTING STRUCTURE

CHECK ONE:

- CREATE NEW LOT(S)
- BUILD ON AN EXISTING LOT IN A SUBDIVISION
- BUILD ON AN EXISTING PARCEL OF RECORD

IS THE PROPERTY WITHIN 2500' OF ANY RESERVOIR?

- YES
- NO

THE TYPE OF STRUCTURE IS:

- RESIDENTIAL WITH 5 PROPOSED BEDROOMS IN THE COMPLETED STRUCTURE (NOTE UNKNOWN IF APPROPRIATE)
- COMMERCIAL (PROVIDE DETAIL OF NUMBERS AND TYPES OF EMPLOYEES/ CUSTOMERS ON ACCOMPANYING PLAN)
- INSTITUTIONAL/GOVERNMENT (PROVIDE DETAIL OF NUMBERS AND TYPES OF EMPLOYEES/USERS ON ACCOMPANYING PLAN)

PROPERTY OWNER(S) JANET MARSHALL (CHM, LLC.)

DAYTIME PHONE (410) 531-1460 CELL N/A FAX N/A

MAILING ADDRESS 5027 TEN OAKS ROAD CLARKSVILLE MD 21029
STREET CITY/TOWN STATE ZIP

APPLICANT JEREMY RUTTER

DAYTIME PHONE N/A CELL (410) 982-2882 FAX N/A

MAILING ADDRESS P.O. Box 126 LISBON MARYLAND 21765
STREET CITY/TOWN STATE ZIP

APPLICANT'S ROLE: DEVELOPER BUILDER BUYER RELATIVE/FRIEND REALTOR CONSULTANT

PROPERTY LOCATION
SUBDIVISION/PROPERTY NAME 5027 TEN OAKS ROAD LOT NO. 14


PROPERTY ADDRESS CLARKSVILLE, MD 21029
STREET TOWN/POST OFFICE

TAX MAP PAGE(S) 28 GRID 9 PARCEL(S) 45 PROPOSED LOT SIZE 1

AS APPLICANT, I UNDERSTAND THE FOLLOWING: THE SYSTEM INSTALLED SUBSEQUENT TO THIS APPLICATION IS ACCEPTABLE ONLY UNTIL PUBLIC SEWERAGE IS AVAILABLE. THIS APPLICATION IS COMPLETE WHEN ALL APPLICABLE FEES AND A SUITABLE SITE PLAN HAVE BEEN RECEIVED. I ACCEPT THE RESPONSIBILITY FOR COMPLIANCE WITH ALL M.O.S.H.A. AND "MISS UTILITY" REQUIREMENTS. APPROVAL IS BASED UPON SATISFACTORY REVIEW OF A PERC CERTIFICATION PLAN.

TEST RESULTS WILL BE MAILED TO APPLICANT. Jeremy Rutter
SIGNATURE OF APPLICANT

HOWARD COUNTY HEALTH DEPARTMENT, BUREAU OF ENVIRONMENTAL HEALTH, WELL AND SEPTIC PROGRAM
7178 COLUMBIA GATEWAY DRIVE COLUMBIA, MARYLAND 21046 (410) 313-2640 FAX (410) 313-2648
TDD (410) 313-2323 TOLL FREE 1-877-4MD-DHMH

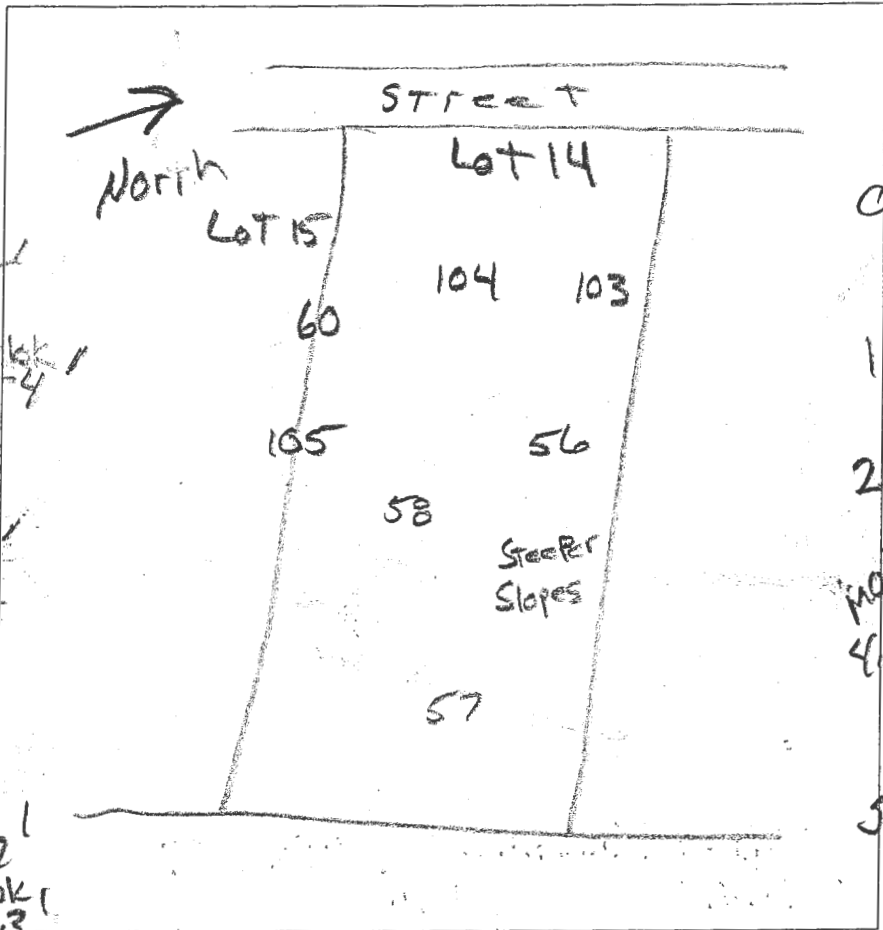

(58)
 dk grey-brn L
 dk brn L
 brn L
 1.5
 yel-red
 yel-red gl
 1.5
 6' red ls
 2.5' grey mica
 2.5' hard rock
 mica
 not yet soil

(57)
 dk grey-brn
 & brn loam
 0.5
 1.5
 brn ls
 0.5
 many mica
 1.9
 brn L
 2msbk
 few gravel
 2.7
 brn L
 few boulders
 4.3
 few mica
 brn L
 1msbk
 few mica
 brn L
 2msbk
 few mica
 6.5
 by loam
 75% rock
 R

(60)
 dk brn L
 to brn L
 brn sil, 2msbk
 brn loam
 3.3
 red & yel-brn
 sl, many mica
 6' red & yel-brn
 ls, many mica
 6' red & grey-brn
 ls, many mica
 2 v. boundary lens
 9' red & grey-brn
 ch ls, many mica
 few flag
 11' red & grey
 fls
 micaceous
 11.5

DATE	TEST #	DEPTH	START	BREAK 1" DROP	STOP 2" DROP	TIME OF 2ND INCH	P/F/H
12/14/12	58	3.1'	10:48	11:04	11:34	>30	F
12/14/12	57	Fill 0 to 12'	Visual	Rock at 6.5'	50%		F
12/14	60	11'	Visual	Sidewall	1.2 gpd	1.8-7'	P
12/14	56	4' / 11.3'	12:00	12:12	12:33	21	P

(56)
 dk grey-brn L
 dk brn L
 yel-red L
 com. mica
 yel-red
 ch sl, many mica
 2.5
 red & yel-brn
 ch sl, many mica
 red & grey-brn ls
 11.3
 red & grey-brn
 ch ls micaceous
 12'

RECEIVED
 JUN 18 2012
 HOWARD COUNTY HEALTH DEPT.
 BUREAU OF ENVIRONMENTAL HEALTH

REMARKS #57 'old' roadbed, #56 11.2 gpd @ 2 ft below 7' pt
 SANITARIAN R Bricker BACKHOE Chuck Zepf OTHERS Jeremy Rutter
 TEST HOLES USED IN SDA _____ AVG PEB @ TIME _____ SQ. FT/BR _____
 TRENCH WIDTH _____ INLET DEPTH _____ MAX. BOT DEPTH _____ EFFECTIVE SW _____

Lot 14

A/P

103

Lot 15

105

0.4' dk brn L
brn L
1.5' brn L, 2msbk
clay skins
2.5' brn sl, 1fsbk
many mica
brn, red
& ye-brn ls.
1mpl, micaceous
7.5' red & brn ls
micaceous
11.5'

104

103

Grain field

1.4'

dk brn L
brn ch
2fsbk slightly
sticky
few stones
brn sl
1 v fpl, mica

105
wooded

56

2' red & ye-brn
1 v fpl, mica
4' red & brn
ls, micaceous

58

11.5'

brn ls
micaceous

12'

STEEPER
SLOPES



104

0.6' dk brn L
brn L
1.6' brn L
2msbk
2.7' brn L, 2fsbk
brn sl, 1 v fpl
many mica
3.5' red, brn & ye-brn
ls, micaceous
1mpl
8.5' red & brn
chls, micaceous
12' 2 v fpl

DATE	TEST #	DEPTH	START	BREAK 1" DROP	STOP 2" DROP	TIME OF 2ND INCH	P/F/H
5/29/13	103	3.8' 11.5'	10:29	10:29:30	10:31:30	2	P
5/29/13	104	4.2' 12'	10:41	10:43	10:45	3	P
5/29/13	105	3.7' 12'	10:54	10:57	11:01	4	P

REMARKS

SANITARIAN R Bricker BACKHOE Chuck Zapp OTHERS Jeremy Kutter

TEST HOLES USED IN SDA _____ AVG. PERC TIME _____ SQ. FT/BR _____

TRENCH WIDTH _____ INLET DEPTH _____ MAX. BOT DEPTH _____ EFFECTIVE SW _____

Real Property Data Search

Search Result for HOWARD COUNTY

View Map		View GroundRent Redemption			View GroundRent Registration				
Tax Exempt:		Special Tax Recapture:							
Exempt Class:		NONE							
Account Identifier:		District - 05 Account Number - 598960							
Owner Information									
Owner Name:		MB GAITHERS CHANCE LLC			Use:		RESIDENTIAL		
Mailing Address:		1686 E GUDE DR ROCKVILLE MD 20850-			Principal Residence:		NO		
					Deed Reference:				
Location & Structure Information									
Premises Address:		5047 GAITHERS CHANCE DR CLARKSVILLE 21029-0000			Legal Description:		LOT 14 1.3762 A. 5047 GAITHERS CHANCE DR GAITHERS CHANCE		
Map:	Grid:	Parcel:	Sub District:	Subdivision:	Section:	Block:	Lot:	Assessment Year:	Plat No:
0028	0009	0045		3698			14	2017	Plat Ref: 23698-702
Special Tax Areas:					Town:		NONE		
					Ad Valorem:				
					Tax Class:				
Primary Structure Built		Above Grade Living Area		Finished Basement Area		Property Land Area		County Use	
						1.3762 AC			
Stories	Basement	Type	Exterior	Full/Half Bath	Garage	Last Major Renovation			
Value Information									
			Base Value	Value	Phase-in Assessments				
				As of	As of		As of		
				01/01/2017	07/01/2018		07/01/2019		
Land:			166,200	166,200					
Improvements			0	0					
Total:			166,200	166,200	166,200		166,200		
Preferential Land:			0				0		
Transfer Information									
Seller:		Date:			Price:				
Type:		Deed1:			Deed2:				
Seller:		Date:			Price:				
Type:		Deed1:			Deed2:				
Seller:		Date:			Price:				
Type:		Deed1:			Deed2:				
Exemption Information									
Partial Exempt Assessments:		Class			07/01/2018		07/01/2019		
County:		000			0.00				
State:		000			0.00				
Municipal:		000			0.00 0.00		0.00 0.00		
Tax Exempt:		Special Tax Recapture:							
Exempt Class:		NONE							
Homestead Application Information									
Homestead Application Status: No Application									
Homeowners' Tax Credit Application Information									