

PERMIT

SEWAGE DISPOSAL SYSTEM

MARYLAND STATE DEPARTMENT OF HEALTH*

HOWARD COUNTY

ELLICOTT CITY

DISTRICT 4th

DATE May 26, 1981

INDEXED

Mr. A. P. Snow IS PERMITTED TO INSTALL _____ ALTER X

ADDRESS 22610 Georgia Ave PHONE 854-6190

SUBDIVISION _____ ROAD 4470 4402 Route 97 LOT _____

PROPERTY OWNER Samual J. Weiss Jr.

ADDRESS 4470 4402 Route 97, Brookville Md. 20729

SPECIFICATIONS

SEPTIC TANK CAPACITY _____ GALLONS

DRAIN FIELD _____ DEPTH _____ FEET, BOTTOM AREA _____ SQ. FT.

DEEP TRENCH _____ DEPTH _____ FEET, BOTTOM AREA _____ SQ. FT.

SEEPAGE PITS _____ ABSORBENT SIDE-WALL AREA _____ SQ. FT.

INLET PIPE _____ FT. BELOW ORIGINAL GRADE. MAXIMUM DEPTH _____ FT. BELOW ORIGINAL GRADE

EFFECTIVE DEPTH AT _____ FT. BELOW ORIGINAL GRADE.

LOCATE DISPOSAL AREA _____ FT. FROM _____ LOT LINE AND _____ FT. FROM _____ LOT LINE AS SEEN WHEN FACING LOT FROM

REPAIR - Call for an appointment when ground is opened up and Sanitarian will

recommend the repair system. New septic tank, 70 ft
trench. Inlets 4 ft, max depth 11 ft. with 7 ft of
stone. Fill in old concrete block pits.

PLANS APPROVED BY Palmer F. Wine DATE May 26, 1981

COVER NO WORK UNTIL INSPECTED AND APPROVED.

NEITHER THE HOWARD COUNTY COUNCIL NOR THE HEALTH DEPARTMENT IS RESPONSIBLE FOR THE SUCCESSFUL OPERATION OF ANY SYSTEM.

NOTE: IF TRENCH IS USED CALL FOR INSPECTION BEFORE PLACING GRAVEL IN TRENCH.

NOTE: NO DRY WELL SHALL EXCEED 15 FOOT IN DIAMETER.

NOTE: ALL PIPE FROM HOUSE TO DISPOSAL AREA MUST BE CAST IRON.

PERMIT VOID AFTER THREE YEARS.

NOTE: INSTALL STAND PIPE ON SEPTIC TANK AND DRY WELL. STAND PIPES MUST BE 6 INCHES IN DIAMETER. CAST IRON, CONCRETE OR TERRA COTTA ACCEPTED.

*INSTALLER IS RESPONSIBLE FOR OBTAINING FINAL APPROVAL ON THIS PERMIT.

BLDG. PERMIT. SIGNED
 AND RETURNED 4/11/81
Serial # 46584
Pool.

89139P


1/8
30
6/2/81 AM Please
6/10/81 AM Please

approved 6/10/81
Stayen
P 31398
A repair

Property known as #4402 ROUTE 97
 MAUREEN T. CLARKE-DEED 904/02B
 4TH ELECTION DIST. HOWARD CO. MD

THIS PLAT CAN NOT BE USED TO ESTABLISH PROPERTY LINES OR CORNERS.

COPY

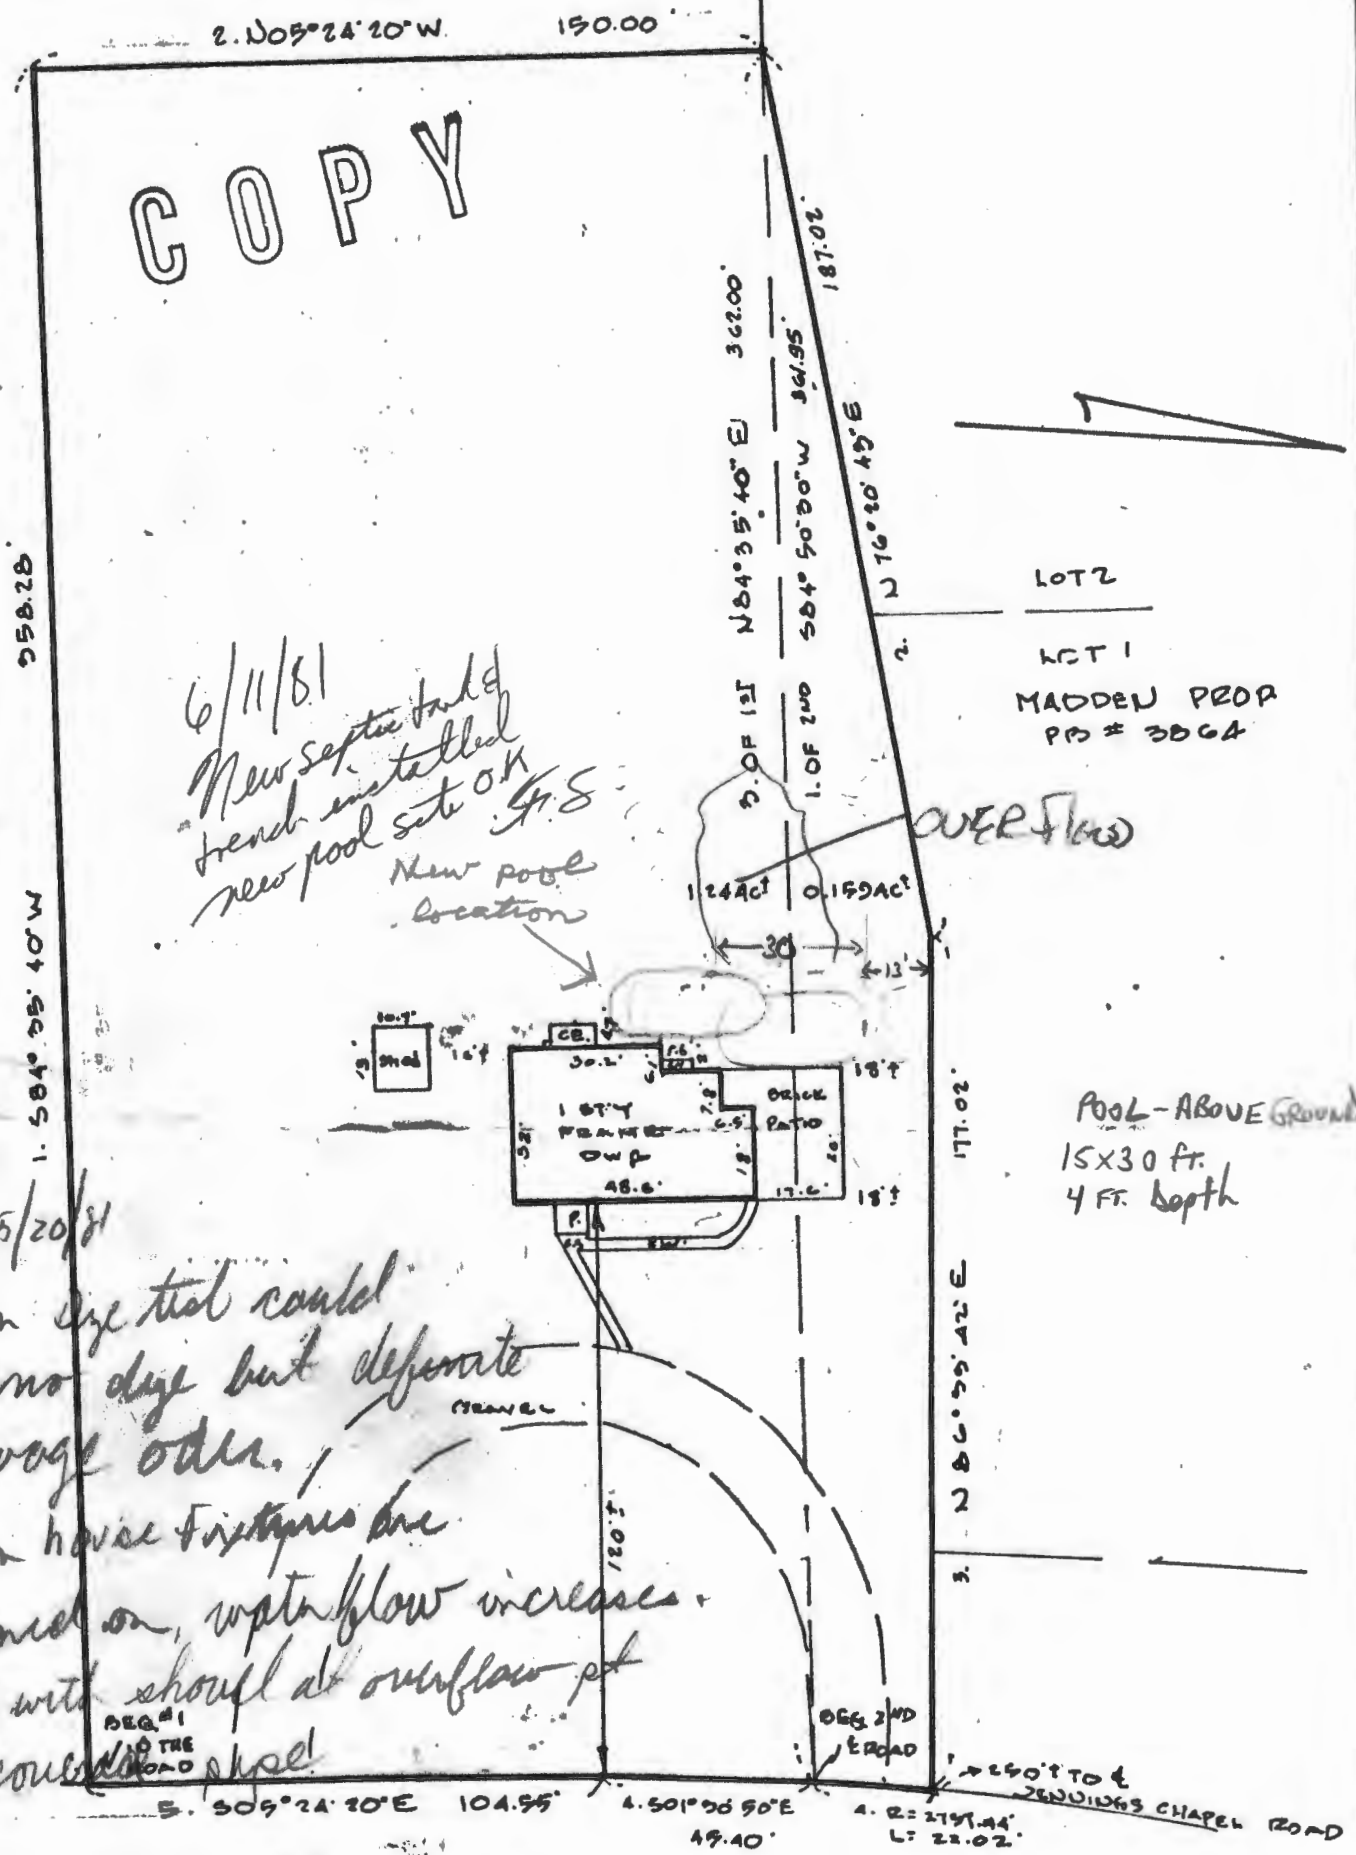

6/11/81
 New septic tank
 trench installed
 new pool site OK
 New pool location

SE 5/20/81
 Run eye trial could
 see no dye but definite
 sewage odor.
 when house fixtures are
 turned on, water flow increases.
 Dig with shovel at overflow pt
 discovered pipe!

CERTIFICATION

This is to certify that I have surveyed
 the property known as:
 4402 ROUTE 97

for the purpose of locating the im-
 provements thereon, and the improvements
 are located as shown.

SEAL



SCALE 1" = 40'

DATE 1/24/80

AXEL F. LOEN

PROFESSIONAL LAND SURVEYOR
 730 - 0967
 10372 CURRYCOMB COURT
 COLUMBIA, MD. 21044

Handwritten signature of Axel F. Loen