

Name of Requestor: Chester M. Oliver  
 Street Address: 448 Queenstown Rd  
 City, State, Zip: Severna Park MD 21144  
 Date: 1/28/20 1/31/2020  
 Amendment, Permit # B18003446

Ms. Debbie Whalen  
 Division of Plan Review  
 Department of Inspections, Licenses and Permits  
 Howard County Government  
 3430 Court House Dr  
 Ellicott City, MD 21043

2/1-20  
 OK  
 DB

Dear Ms. Whalen:

I am requesting to amend Permit # B18003446 at  
4792 Beechwood Rd to  
 (Site Address)

Changed direction of stairs for basement  
Revised Plot PLAN - to show stairs

Enclosed:  
 Fee: \$50.00 - Cash  
 ~~Plot Plans~~ REVISED PLOT PLANS (SHOWING STAIRS)  
 Sets of Construction Drawings  
 Other: Revisions for area way in basement and I-beam connection

If there is anything we can do to assist you, please let me know.

Sincerely,


Name: Chester M. Oliver  
 Title: Owner (Property)  
 Phone and/or Email: C-Oliver5@comcast.net

CC: DPZ  
 Health



Approved Septic System Plan  
 Howard County Health Department  
*Benard*  
 Signature

2-11-19  
 Date

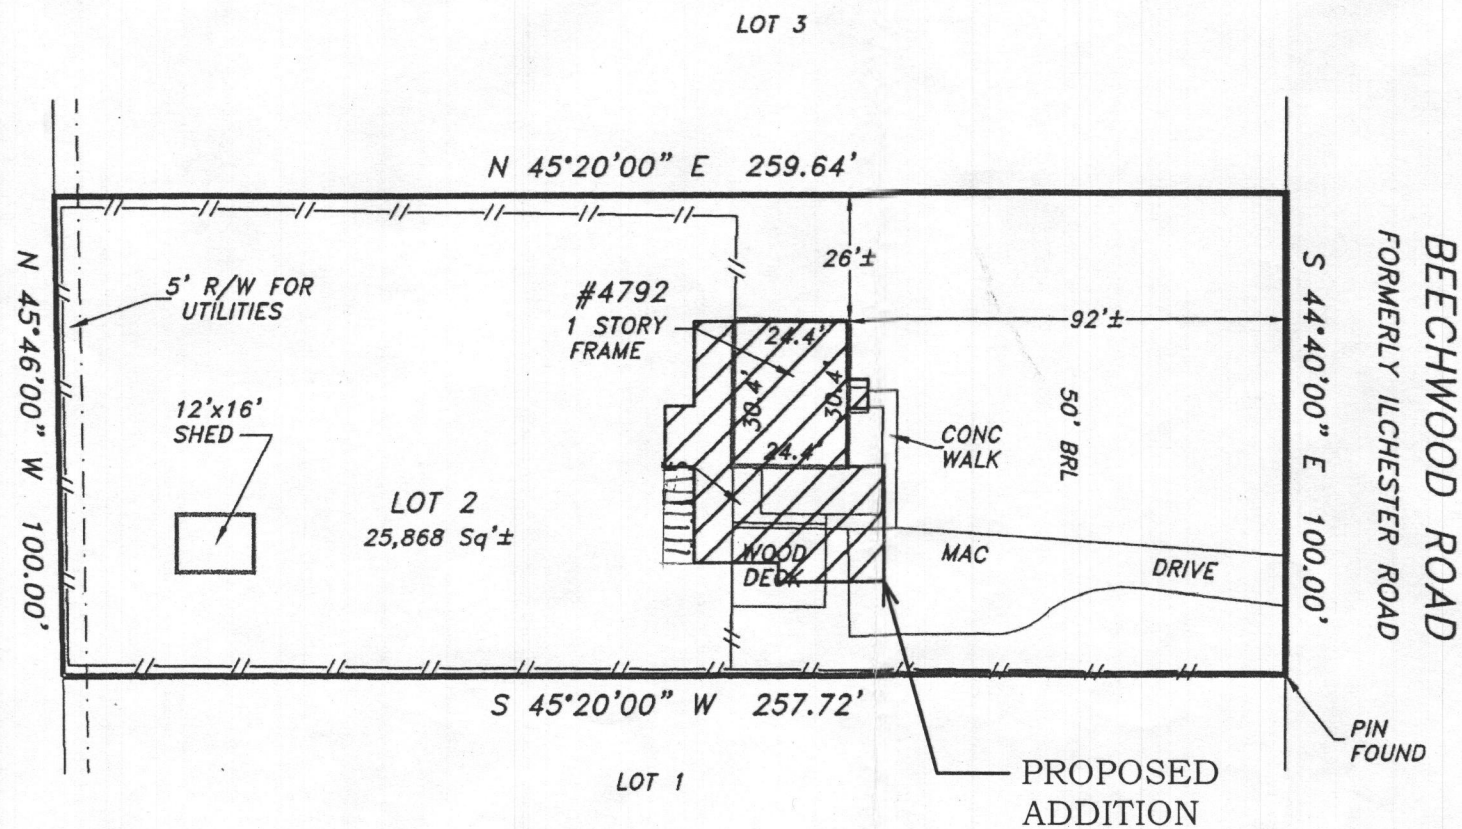

REVISED  
 Date: 11/31/2020  
 18003446  
 Comments: Revised to show stairs.

Approved Septic System Plan  
 Howard County Health Department  
*Benard*  
 Signature  
 2-11-20  
 Date

The purpose of this drawing is to locate, describe, and represent the positions of buildings and substantial improvements affecting the property shown hereon, being known as:  
 LOT 2 as shown on the plat entitled  
 "PLAN OF A DEVELOPMENT FOR JOHN L. THOMAS"  
 recorded among the land records of Howard County, Maryland in  
 Plat Book 6, folio 73

PREPARED FOR:

**SAGE TITLE GROUP**  
 THE WISE CHOICE

This is page one of a two page document. The advice found on the affixed page is an integral part of this drawing, and is not valid without all pages.

James Carl Hudgins  
 Property Line Surveyor #96  
 Expiration Date: 3/11/2020

**LOCATION DRAWING**  
 4792 BEECHWOOD ROAD  
 1st ELECTION DISTRICT  
 HOWARD COUNTY, MARYLAND

**NTT Associates, Inc.**  
 16205 Old Frederick Rd.  
 Mt. Airy, Maryland 21771  
 Phone: (410) 442-2031  
 Fax: (410) 442-1315  
 www.nttsurveyors.com

Scale: 1" = 40'  
 Date: 7/25/2018  
 Field By: RMS/EBS  
 Drawn By: SCK  
 File No.: 238514HIRS  
 Page No.: 1 of 2

content	SITE PLAN
scale: 1"=4' (94222) 1"=8' (17211)	file: 2.2 SITE PLAN
drawn:	date:
<b>CHESTER OLIVER</b>	
OLIVER RESIDENCE	
title	

date	revision	by

SHEET #
2.2