

Menu Save Reset Cancel Help

Record Detail * (This section is required.)

Permit Type	Permit Number	Opened Date
Building/Residential/Misc/Deck	B20000732	03/04/2020
Description of Work		
SFD / CONSTRUCT 10X34 OPEN DECK W/ STEPS		

[check spelling](#)

Online Permit
Approved 3/5/2020
R Buckner

Address * (This section is required.)

Search Reset Clear Get Parcel & Owner

Street #	Street Name	Street Type
7053	MINK HOLLOW	RD
Unit Type	Unit #	X Coordinate
-Select-		-76.98602
		Y Coordinate
		39.17148
City	State	Zip Code
HIGHLAND	MD	20777
	Primary	
	Yes	

Parcel * (This section is required.)

Search Reset Clear Get Address & Owner

GIS ID *	Parcel	Parcel Area	Land Value	Improved Value	Exemption Value	Plan Area
914183	352	5.43	275700	418400	142700	RURAL

Legal Description

IMPSPAR 7 5.433 AR[]7053 MINK HOLLOW RD[]HIGHLAND

[check spelling](#)

Block	Lot	Census Tract	Council Dist	Inspection Dist	Supervisor Dist	Map #	DAP Zone
	PAR 7	605101	5				
Plan Area	State Tax Id	Subdivision Name					
	1405353246						
Section	Area	Tax Map					
		40					
Grid	Zoning District	ADC Map					
40-8	RR-DEO	5051-C3					
SDP No.	Final Plan No.	WP File No.					
Record Plat No.	WS Contract No.	FDP No.					
Owner Occupied	Year Built	Historic District					
☐ Yes ☐ No	1977	☐ Yes ☒ No					
Historic District Registry No.	Stat Area	Flood Plain					
	5-04A	☐ Yes ☒ No					
Building No							

Owner * (This section is required.)

Search Reset Clear

Name *
JOSH MONTGOMERY

Address Line 1
7053 MINK HOLLOW RD

Address Line 2

Address Line 3

Mail City **Mail State** **Mail Zip Code**
HIGHLAND MD 20777

Phone **Primary**
240-286-3194 Yes

E-mail
JOSH@PLATINUMBUILDERSMD.COM

Cell Number **Fax Number**

B 20000723
7053 MinkHollowRd.

Professionals (This section is not required.)

Search Reset Clear

License # * **Business Name**
08010102180 PLATINUM BUILDERS LLC

License Type * **First Name** **Middle Name** **Last Name**
MHIC Ind JOSHUA MONTGOMERY

Primary **Address Line 1**
Yes 7037 MINK HOLLOW ROAD

Address Line 2

City **State** **ZIP Code**
HIGHLAND MD 20777-0000

Phone 1 **Phone 2** **Fax**
2402863194 3018540654

E-mail
JOSH@PLATINUMBUILDERSMD.COM

Applicant (This section is not required.)

Search As Owner As Lic. Prof As Contact

Type * **First Name** **MI** **Last Name**
Applicant Josh Montgomery

Relationship **Full Name**
Applicant Josh Montgomery

Primary **Organization Name**
Yes

Street Address
7037 Mink Hollow Rd

Address Line 2

City **State** **Zip Code**
Highland MD 20777

Phone **Cell** **Fax**
240-286-3194

E-mail *
josh@platinumbuildersmd.com

Addtl Info

Est Construction Cost * **Housing Units *** **Number of Buildings *** **Public Owned**
5000 0 0 No

Construction Type
--Select--

MISC PERMIT INFO

MISCELLANEOUS PERMIT INFORMATION

Capital Project-No Fee *	Capital Project Number	Fee Exempt *	Roadside Tree Project Permit *	Roadside Tree Project Permit #
☐ Yes ☒ No		☐ Yes ☒ No	☐ Yes ☒ No	
Existing Use *	Water	Sewage	Expiration Date	
SFD	Private	Private	9/1/2020	

PAYMENT INFORMATION

Check 1	Payee 1	Check 2	Payee 2	SAP Doc No	SAP Entered

Submit

Cancel

B20000723
7053 Mink Hollow Rd.

OWNER: John Lampstra

Builder: Gordon Walker
286-2366

7053 Mink Hollow Road

Lot 7

5.433 Ac.

Scale 1"=100'

Approved Septic System Plan
Howard County Health Department

10' X 34' Open Deck
w/Steps TO Grade


B20000732

R. Buick
Signature

3/5/2020
Date

I CERTIFY these Dimensions
AND RELATIVE ELEVATIONS.

Gordon Walker

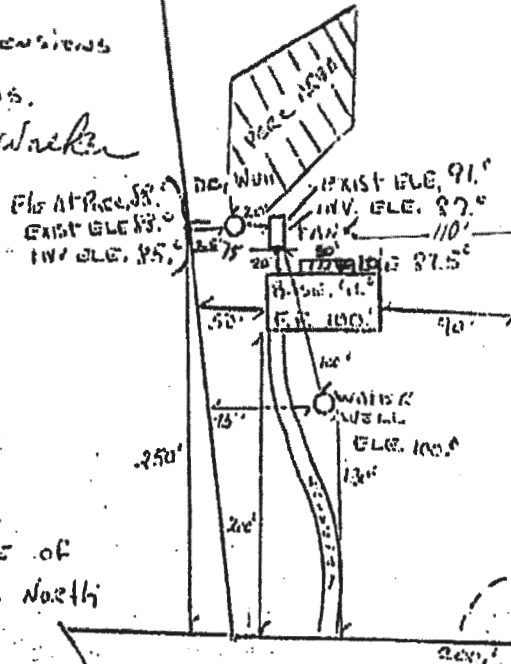

ENTRANCE ON EAST SIDE OF
Mink Hollow RD. 400 FT. NORTH
OF GARDNER LANE.