

\*\*\*\*\*  
 WATER WELL ABANDONMENT-SEALING REPORT FORM  
 \*\*\*\*\*

SUBMIT COPIES OF COMPLETED FORM TO:

- \* COUNTY ENVIRONMENTAL AGENCY (contact MDE, WMA if address needed)
- \* WELL OWNER
- \* MDE, WATER MANAGEMENT ADMINISTRATION, WELL PROGRAM

APPROVED  
 9/18/2019

DATE WELL ABANDONED: 1-3-18 (month/day/year)

\* PERMIT NUMBER OF ABANDONED WELL (if any) N/A

\* PERMIT NUMBER OF REPLACEMENT WELL: N/A


\* PERSON ABANDONING WELL: Andrew Houseman WELL DRILLER'S LICENSE NUMBER: 224

CIRCLE: MWD ~~MSD~~ ~~MGD~~

\* OWNER'S NAME: Khan Zuali

SITE LOCATION MAP

\* WELL LOCATION  
 COUNTY: Howard  
 NEAREST TOWN: Marriottsville  
 TAX MAP 0010 BLOCK 0022 PARCEL 0190  
 SUBDIVISION: \_\_\_\_\_  
 SECTION: \_\_\_\_\_  
 STREET ADDRESS: 11245 Old Frederick Rd LOT: 11

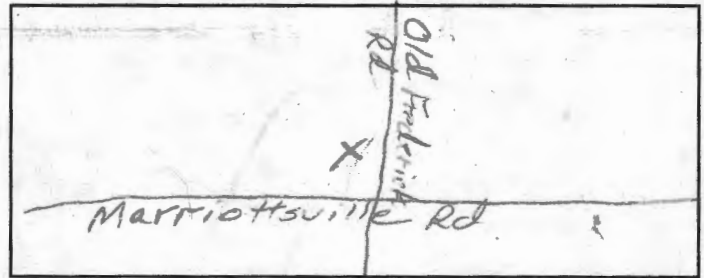

LATITUDE 3 9.316249

LONGITUDE 7 6.901676

LOG OF SEALING MATERIAL

\* TYPE OF WELL BEING ABANDONED:  
 DRILLED  JETTED  
 BORED  HAND DUG  
 OTHER (specify) \_\_\_\_\_

MATERIAL	FEET	
	FROM	TO
Bentonite	185	0

\* USE CODE:  
 DOMESTIC  MUNICIPAL/PUBLIC  
 IRRIGATION  INDUSTRIAL  
 TEST/OBSERVATION  GEOTHERMAL

VOLUME OF MATERIAL USED

\* TYPE OF CASING:  
 STEEL  PLASTIC  
 CONCRETE  OTHER (specify) \_\_\_\_\_

Bentonite 1000 lb.

SIZE OF CASING: 6" INCHES IN DIAMETER

DEPTH OF WELL: 185 FEET DEEP

WAS ANY CASING REMOVED? YES  NO   
 If yes, length removed, in feet: \_\_\_\_\_

WAS CASING RIPPED OR PERFORATED? YES  NO

SIGNATURE MASTER WELL DRILLER OR SUPERVISING SANITARIAN LICENSE#

224

MWD / MSD / MGS

1-2-18

CIRCLE ONE

DATE

COUNTY

