

Bureau of Environmental Health
 8930 Stanford Boulevard, Columbia, MD 21045
 Main: 410-313-2640 | Fax: 410-313-2648
 TDD 410-313-2323 | Toll Free 1-866-313-6300
 www.hchealth.org
 Facebook: www.facebook.com/hocohealth
 Twitter: HowardCoHealthDep

Maura J. Rossman, M.D., Health Officer

APPLICATION

FOR PERCOLATION TESTING AND SITE EVALUATION

PROPERTY LOCATION

SUBDIVISION/PROPERTY NAME Flamewood
 PROPERTY ADDRESS 11345 Old Hopkins Rd Clarksville 21029
STREET TOWN ZIP
 TAX ACCOUNT # 377293 TAX MAP 41 GRID 15 PARCEL 399 LOT NO. 9 PROPOSED LOT SIZE (ACRES) _____
 ZONING CATEGORY _____ TIER _____

PROPERTY OWNER(S) Greg Husted
 DAYTIME PHONE 443-506-7298 CELL _____ EMAIL _____
 MAILING ADDRESS 11345 Old Hopkins Rd Clarksville 21029
STREET CITY, STATE ZIP

APPLICANT Fogle's Septic Clean RELATIONSHIP TO OWNER: Contractor
 DAYTIME PHONE 410-995-5670 CELL _____ EMAIL _____
 MAILING ADDRESS 580 Oorecht Rd Seylesville 21784
STREET CITY, STATE ZIP

I HEREBY APPLY FOR THE NECESSARY TESTING/EVALUATION PRIOR TO ISSUANCE OF SEWAGE DISPOSAL SYSTEM PERMIT(S):

- PROPERTY:
- SUBDIVISION: NUMBER OF LOTS INCLUDING RESIDUE: _____
 SUBDIVISION CLASSIFICATION (PER DEPT. OF PLANNING AND ZONING) MAJOR MINOR
 - CONSTRUCT NEW OSDS ON UNDEVELOPED LOT
 - REPAIR OR REPLACE FAILING OSDS
 - UPGRADE EXISTING OSDS
- BUILDING:
- RESIDENTIAL WITH 3 EXISTING OR PROPOSED BEDROOMS IN THE COMPLETED STRUCTURE
 - COMMERCIAL (PROVIDE DETAIL OF TYPE OF USE AND NUMBERS OF EMPLOYEES/CUSTOMERS ON ACCOMPANYING PLAN)
- IS THE PROPERTY WITHIN 2500 FEET OF ANY RESERVOIR?
 YES
 NO





AS APPLICANT, I UNDERSTAND THE FOLLOWING:

- THIS APPLICATION IS VALID FOR TWO (2) YEARS FROM DATE OF FEE PAYMENT AND APPROVAL IS BASED UPON HEALTH OFFICER SIGNATURE OF A PERC CERTIFICATION PLAN PRIOR TO EXPIRATION OF THIS PERMIT.
- THE APPLICATION FEE IS NON-REFUNDABLE
- THIS APPLICATION MUST BE ACCOMPANIED BY ALL APPLICABLE FEES AND A SUITABLE SITE PLAN IN ORDER TO BE PROCESSED
- THIS IS A PUBLIC DOCUMENT

I declare and affirm that to the best of my knowledge, the information contained herein is correct. I declare that I am the owner of the property or duly authorized to make this application on behalf of the owner. I agree to comply with all applicable state and county regulations.
 By signature of this application, I hereby grant Howard County Health Department officials the right to enter onto the property for the purpose of inspecting the property as directly related to the requested permit/service.

 SIGNATURE OF APPLICANT

 DATE

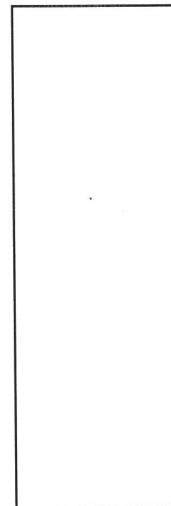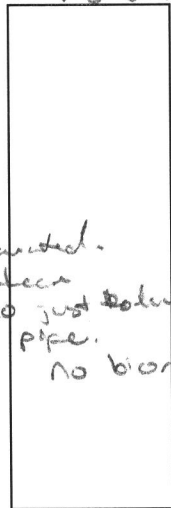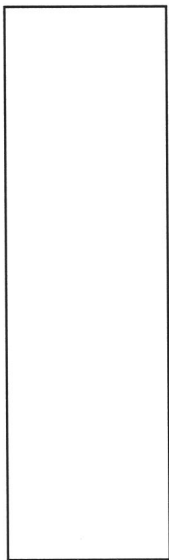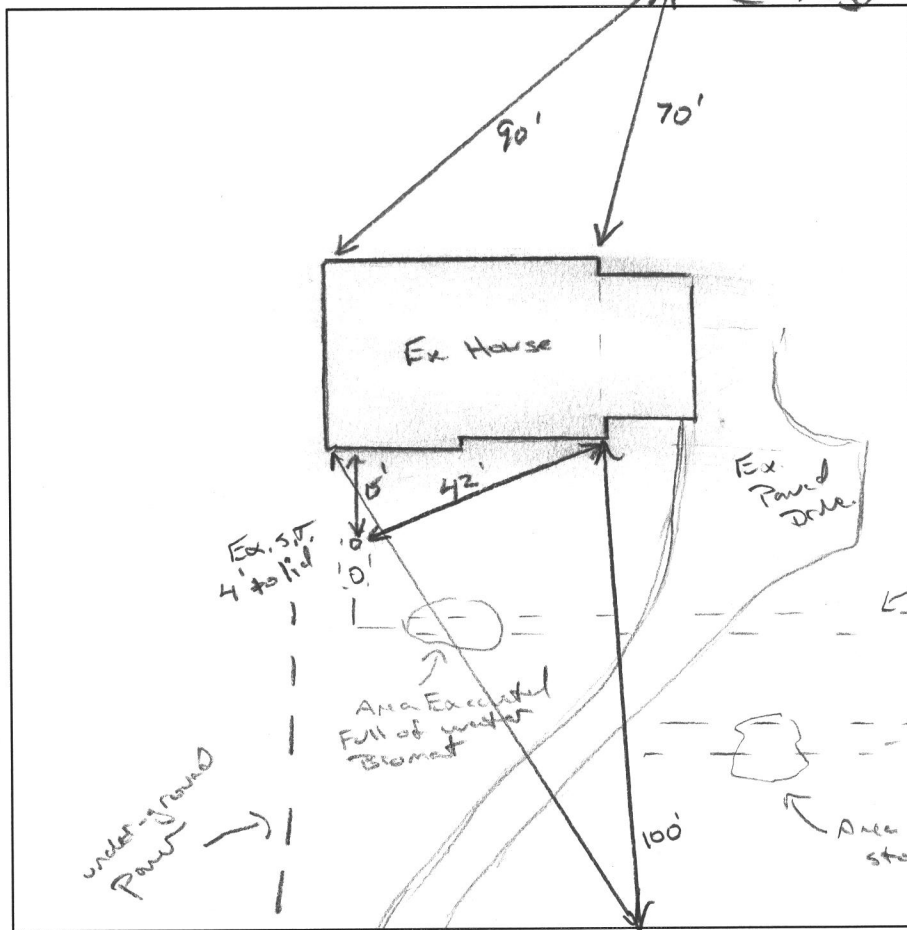

(A)

11 Br L,
MSBK, Friable
CW, roots
10% Rx.

3'

Br/Rd CL
MFSBK, CW
Smearly,
Roots, 15% Sap.

5-6'

11 Br/Y SL
WKL0SBK
Miscellaneous
Friable

9'

11 Br/Y/R FSL
WKF PL
12% Sap
Miscellaneous

4'

DATE	TEST #	DEPTH	START	BREAK 1" DROP	STOP 2" DROP	TIME OF 2ND INCH	P/F/H
11/22/19	(A)	6' / 14'	00:59	01:01	01:05	4	P

REMARKS _____

SANITARIAN K. Wolf BACKHOE Ricky Colver OTHERS Helper

TEST HOLES USED IN SDA 1 AVG. PERC TIME 4 SQ. FT/BR 1.2 sqd/ft²

TRENCH WIDTH 2 INLET DEPTH 4-4.5' MAX. BOT DEPTH 9-9.5' EFFECTIVE S/W 3.5'

$$3BR = \frac{450 \text{ sqd}}{1.2 \text{ sqd/ft}^2} = 375 \text{ ft}^2 \div 2' = 187.5 \text{ (40)} = 75'$$

Real Property Data Search (w1)

Search Result for HOWARD COUNTY

View Map View GroundRent Redemption View GroundRent Registration

Tax Exempt: None Special Tax Recapture: None
 Exempt Class: None

Account Identifier: District - 05 Account Number - 377293

Owner Information

Owner Name: HUSTEAD GREGORY C Use: RESIDENTIAL
 Principal Residence: YES
 Mailing Address: 11345 OLD HOPKINS RD Deed Reference: /17179/ 00415
 CLARKSVILLE MD 21029-1840

Location & Structure Information

Premises Address: 11345 OLD HOPKINS RD Legal Description: LOT 9 .918AR S 1
 CLARKSVILLE 21029-0000 FLAMEWOOD

Map:	Grid:	Parcel:	Neighborhood:	Subdivision:	Section:	Block:	Lot:	Assessment Year:	Plat No:
0041	0015	0399	5020202.14	2002			9	2020	Plat Ref:

Special Tax Areas: None Town: None
 Ad Valorem: 100
 Tax Class: None

Primary Structure Built Above Grade Living Area Finished Basement Area Property Land Area County Use
 1976 2,112 SF 39,988 SF

Stories	Basement	Type	Exterior	Quality	Full/Half Bath	Garage	Last Notice of Major Improvements
2	NO	SPLIT LEVEL	FRAME/	4	2 full		

Value Information

	Base Value	Value As of 01/01/2017	Phase-in Assessments	
			As of 07/01/2019	As of 07/01/2020
Land:	215,500	215,500		
Improvements	186,000	186,000		
Total:	401,500	401,500	401,500	
Preferential Land:	0			

Transfer Information

Seller: HUSTEAD GREGORY C Date: 10/12/2016 Price: \$0
 Type: NON-ARMS LENGTH OTHER Deed1: /17179/ 00415 Deed2:
 Seller: COE DAVID M Date: 05/25/2005 Price: \$469,500
 Type: ARMS LENGTH IMPROVED Deed1: /09197/ 00448 Deed2:
 Seller: Date: Price:
 Type: Deed1: Deed2:

Exemption Information

Partial Exempt Assessments:	Class	07/01/2019	07/01/2020
County:	000	0.00	
State:	000	0.00	
Municipal:	000	0.00	0.00

Tax Exempt: None Special Tax Recapture: None
 Exempt Class: None

Homestead Application Information

Homestead Application Status: Approved 02/15/2011

Homeowners' Tax Credit Application Information

Homeowners' Tax Credit Application Status: No Application Date:



HOWARD COUNTY HEALTH DEPARTMENT

66453

DATE 11/12/19

P/S/15
410 795-3000

Received From

Fogles Septic Clean PHONE #

For

Parcel Repair 11345 Old
Hopkins Rd.

CASH

CHECK

NO.

06278 three hundred thirty

Dollars

\$ 330.00

Received By

J King