

APPLICATION

12/14/93
2PM

PERCOLATION TESTING

A 49762

P _____

HOWARD COUNTY HEALTH DEPARTMENT
BUREAU OF ENVIRONMENTAL HEALTH
3525-H ELLICOTT MILLS DRIVE/ELLICOTT CITY, MARYLAND 21043
TELEPHONE: 313-2640

PERMITTED OK (CW)

DISTRICT _____

DATE 11/23/93

TO: THE COUNTY HEALTH OFFICER
ELLICOTT CITY, MARYLAND

I HEREBY APPLY FOR THE NECESSARY TEST PRIOR TO APPLICATION FOR PERMIT TO CONSTRUCT (OR RECONSTRUCT) A SEWAGE DISPOSAL SYSTEM.

PROPERTY OWNER Donald Berilla

ADDRESS 12562 Folly Quarter Rd 21042 PHONE 531-5648

AGENT OR PROSPECTIVE BUYER William M. Stone

ADDRESS 5409 Broadwater Ln Clarksville MD 21029 PHONE 531-2996

PROPERTY LOCATION:

SUBDIVISION Broadwater LOT NO. Lot 3

ROAD AND DESCRIPTION Broadwater Lane Clarksville MD

TAX MAP 28 PARCEL # 69

SIZE OF LOT 5.016 AC.± TYPE BLDG. S.F.D.
(SINGLE FAMILY DWELLING OR COMMERCIAL)

THE SYSTEM INSTALLED UNDER THIS APPLICATION IS ACCEPTABLE ONLY UNTIL PUBLIC FACILITIES BECOME AVAILABLE. I FULLY UNDERSTAND THE FEE CONNECTED WITH THE FILING OF THIS PERC TEST APPLICATION IS NON-REFUNDABLE UNDER ANY CIRCUMSTANCES. I ALSO AGREE TO COMPLY WITH ALL M.O.S.H.A. REQUIREMENTS IN TESTING THIS LOT.

will. m. stone (mark)
(SIGNATURE OF APPLICANT)

APPROVED BY _____ FOR _____ DATE _____

DISAPPROVED BY _____ FOR _____ DATE _____

HOLD PENDING FURTHER TESTS _____

REASONS FOR REJECTION OR HOLDING PERC OR - HOLD FOR PLAT MR 12/14/93

PERCOLATION TEST PLAT/PRELIMINARY PLAT - TITLE OR I.D. # _____ DATE _____

SITE DEVELOPMENT PLAN/FINAL PLAT - TITLE OR I.D. # _____ DATE _____

THIS IS NOT A PERMIT

49762


SEX WELL LOT 2 HO-92-0389

COUNTY #


SOIL PROFILE

0'
brn org sil cl lm
4 1/2 - 5
brn si sand lm
hi mica 15% ↑ w/depth
1 1/2

(7)
brn sa cl lm
3 - 3 1/2
brn sa lm
20-30% frags ↑ w/depth
10
HARD BOT

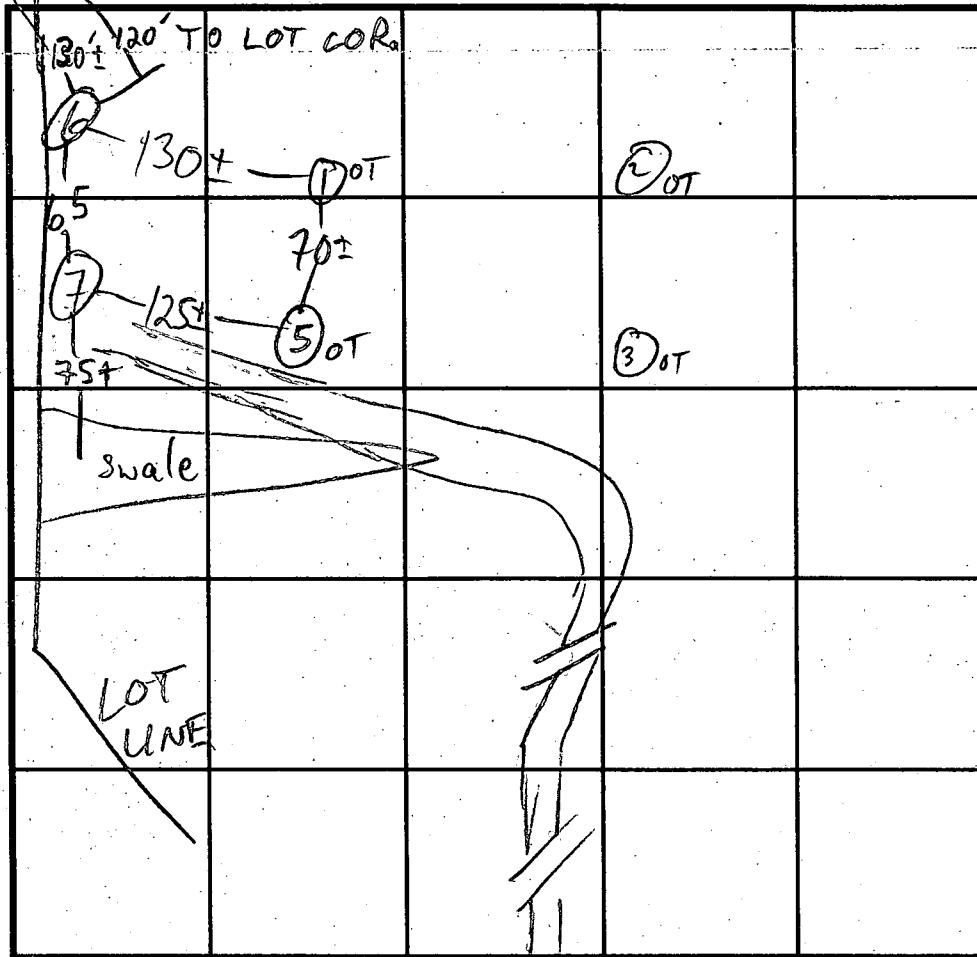

SOIL PROFILE

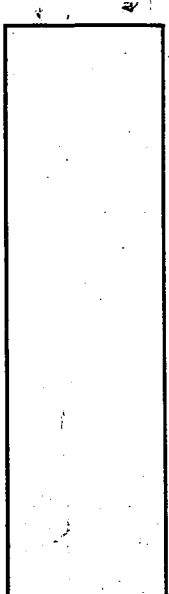

BROADWATER LA INDICATE NORTH - NAME ADJOINING ROADWAY AS BASE LINE.

DATE	TEST NO.	DEPTH	PRE-WET		TEST - 1" DROP		TIME
			START	STOP	START	STOP	
12/14/93	6	4 3/4" 5'	2:53 3:10:00	3:04 3:11:30	A LITTLE SLOW	34"	4
	6	11 1/2'	OK	see profile			
	7	4 1/2'	3:22	3:24	3:24	3:28	4
	7	10'	HARD BOT	see profile			

REMARKS HOLE (6) PER PLAN; HOLE (7) ~30' UPHILL FROM PLAN LOC.
 TYPE OF SOIL USE (1)-(5)-(6)-(7)
 TESTED BY M. Ripkin ALSO PRESENT Mr. Stone, Sam (hoel)
 TRENCH DESIGN DATA: AVERAGE PERCOLATION TIME 6 TRENCH WIDTH 3'
 INLET DEPTH 4 MAXIMUM BOTTOM DEPTH 6 SQ. FT./BEDROOM 480