

**COMPLETE THIS FORM WHEN DROPPING OFF ANY
CORRESPONDENCE AND/OR PLANS TO THE HOWARD COUNTY
DEPARTMENT OF INSPECTIONS, LICENSES AND PERMITS COUNTER:**

Date: 3-3-2020

To: Sonye Funnire
(Person's Name and Division)

From: Americas (410) 465-0800
(Your Name, Company Name and Telephone Number)

Subject: Project name Ida Berg Residence
Project site address 5345 Greenbridge Rd
Permit # B19004293 SDP # N/A
Other information pertinent to this project _____

RECEIVED
MAR 03 2020
PERMITS

✓ Please check the attachments below that you are submitting with this transmittal:

- Letter of response to address plan review comment letter
- Revised plans and/or revised details: When submitting for a complete re-review, **duplicate sets shall be submitted.**
- Letter Summarizing Changes
- Energy conservation calculations
- Copies of plot plan (be specific).
 - Health Department Request
 - DPZ/ DED Request
 - Applicant's Request
- Two sets of single family dwelling model plans to be placed on permanent file: Model name and/or # _____
- Other _____

Contact Person Information: (Required)

Please Print Name _____ Telephone No: _____
E-Mail Address: _____

PLEASE ASSURE ALL DOCUMENTS AND/OR REVISIONS ARE APPROPRIATELY SIGNED AND SEALED, IF NECESSARY, BY A LICENSED ARCHITECT OR ENGINEER. PLEASE BE ADVISED THAT INSUFFICIENT INFORMATION MAY RESULT IN THE DELAY OF REVIEW BY THE PLANS EXAMINER. THE DEPARTMENT OF INSPECTIONS, LICENSES AND PERMITS WILL CONTACT YOU IF THERE IS A PROBLEM. IN ADDITION, ONCE THE BUILDING PERMIT IS APPROVED BY THE PLAN REVIEW DIVISION AND ALL OTHER REQUIRED SIGNATORY AGENCIES, AND THE BUILDING PERMIT IS READY FOR ISSUANCE, THE PERMIT DIVISION WILL NOTIFY THE APPROPRIATE CONTACT PERSON FOR PERMIT PICK UP. ALL PERMIT STATUS INQUIRIES SHALL BE DIRECTED TO THE PERMIT DIVISION AT 410-313-2455. CODE RELATED QUESTIONS AND PLAN REVIEW INQUIRIES SHALL BE DIRECTED TO THE PLAN REVIEW DIVISION AT 410-313-2436. PLEASE ALLOW A MINIMUM OF FIVE (5) WORKING DAYS FOR ANY PLAN SUBMITTALS TO BE REVIEWED. THANK YOU.

Received by _____

CC: P+Z
HEALTH # [Signature] 3/10/20

REVISED

Date: 3-3-2020

Comments: Relocate Tank



B19004293

Approved for APT

B19004293

3/10/2011 Feet from property line

GREEN BRIDGE ROAD

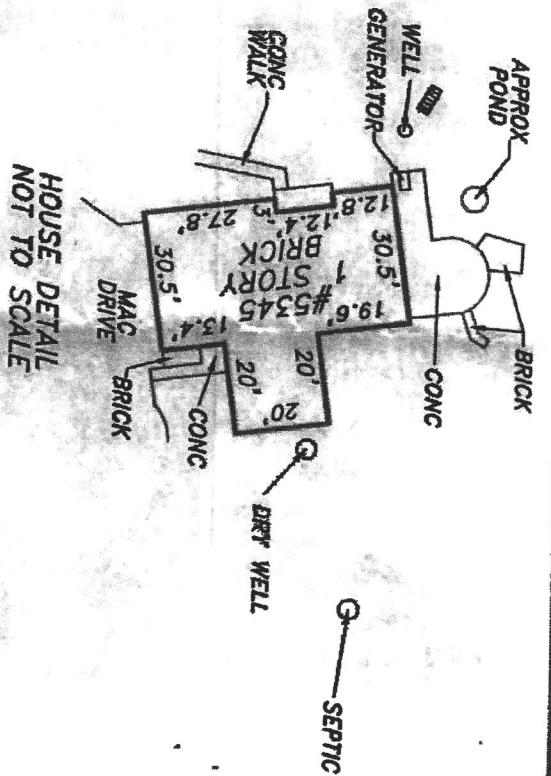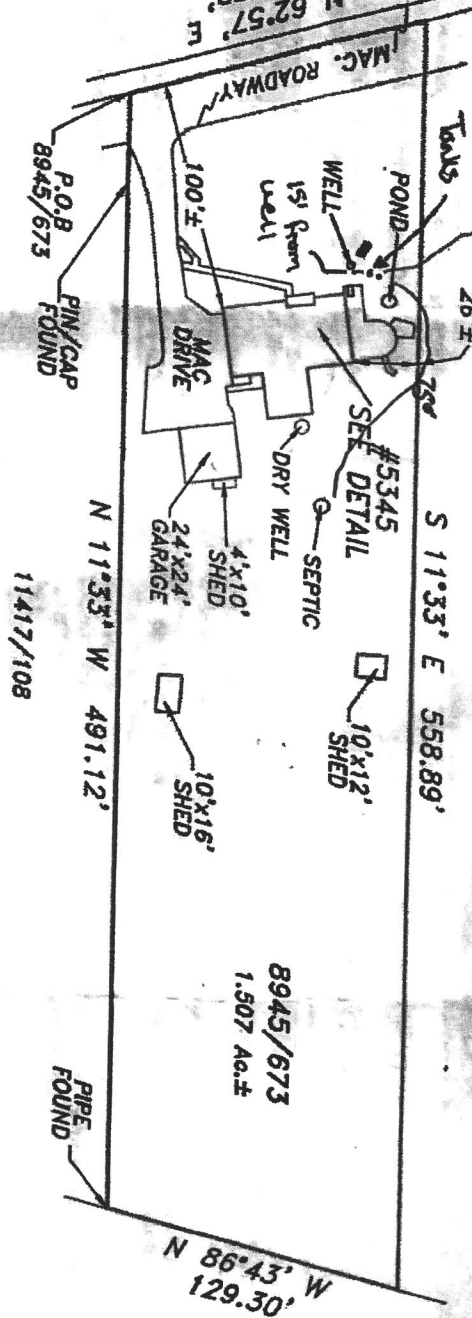


The purpose of this drawing is to locate, describe, and represent the positions of buildings and substantial improvements affecting the property shown hereon, being known as:

5345 Green Bridge Road
as described in a deed recorded among the land records of Howard County, Maryland in Liber 8945 folio 673

This is to certify that I either personally prepared or was in responsible charge over the preparation of this drawing and the surveying work reflected in it, all set forth in Regulation .12 of Chapter 09.15.06 of the Code of Maryland Annotated Regulations.

This is page one of a two page document. The advice found on the affixed page is an integral part of this drawing, and is not valid without all pages.

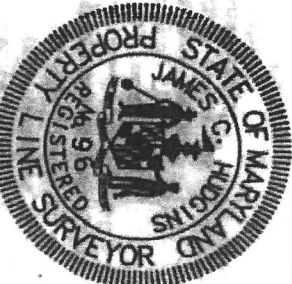

James Carl Hudgins
Registered Professional Surveyor, #96
Expiration Date: 3/11/2020

LOCATION DRAWING
5345 GREEN BRIDGE ROAD
5th ELECTION DISTRICT
HOWARD COUNTY, MARYLAND

NTT Associates, Inc.

16205 Old Frederick Rd.

Mt. Airy, Maryland 21771

Phone: (410) 442-2031

Fax: (410) 442-1315

www.nttsurveyors.com

Scales: 1" = 80'

Date: 1/24/2020

Field By: RMS/SB

Drawn By: DAM

File No.: MISC 13708

Page No.: 1 of 2

GENERAL NOTES:

- 1) The accuracy of the distances shown from any structure to any apparent property line is 1".
- 2) This drawing does not represent a Boundary Survey. Any property markers labeled hereon are not guaranteed by NNT Associates, Inc.
- 3) This plat is of benefit to a consumer only insofar as it is required by a lender, a title insurance company or its agent in connection with contemplated transfer, financing, or refinancing.
- 4) This plat does not provide for the accurate identification of property boundary lines, but such identification may not be required, for the transfer of title or securing financing or refinancing.
- 5) This plat is not to be relied upon for the establishment or location of fences, garages, buildings, or other existing or future improvements.
- 6) Unless noted on the drawing, no title report was provided. This drawing was prepared by examining the current title deed or record plat. Any easements, restrictions, rights of way, or any other property alterations not referred to in the current title deed may not be shown.
- 7) Unless otherwise noted, the bearings and north arrow shown hereon are in the meridian of the current title deed or record plat.
- 8) Building Restriction Line Information, if shown, was obtained from existing records only and is not guaranteed by NNT Associates, Inc.
- 9) Flood Zone Information shown on FIRM maps is subject to interpretation.
- 10) Improvements which in the surveyor's opinion appear to be in a state of disrepair or considered "temporary" may not be shown.
- 11) If it appears encroachments may exist, a Boundary Survey is recommended to determine the exact location of the property boundary lines and improvements.
- 12) The locations of fence lines, if shown, are approximate.

APPARENT ENCROACHMENT NOTES:

- 1) There are no apparent encroachments.

JOB SPECIFIC NOTES:



5345 GREEN BRIDGE ROAD
DAYTON, MARYLAND 21036

PRINTING INSTRUCTIONS:

- 1) With the drawing open in Adobe Reader, select "Print..." in the "File" menu
- 2) Select the desired printer
- 3) Choose the "All" option under "Pages to Print"
- 4) Choose the "Actual size" option under "Page Sizing & Handling"
- 5) To print in COLOR click "Print", for BLACK & WHITE continue to step 6
- 6) Click the "Properties" button
- 7) Choose the "Imaging" tab
- 8) Check the "Print text as black" & "Print graphics as black" boxes (this will remain the default until unchecked)
- 9) Click "OK"
- 10) Click "Print"

SURVEYOR LEGEND:

Property Lines: _____	Fence Line (Metal, Wire): _____	X
Buildings: _____	Fence Line (Wood, Plastic): _____	/-/
Improvements: _____	Right of Way: _____	----
Building Restriction Line: _____	100 Year Flood Plain: _____	----
Easement Lines: _____	Forest Conservation: _____	----
Old Lot Lines: _____	Septic Reserve Areas: _____	----
	Overhangs: _____	----

NNT Associates, Inc.
16205 Old Frederick Rd.
Mt. Airy, Maryland 21771
Phone: (410) 442-2031
Fax: (410) 442-1315
www.nntsurveyors.com

Subject property is shown in Zone X on the FIRM Map of Howard County, Maryland on Community Panel Number 24027C0110D, effective 11/06/2013

File No.: MISC 13708

Page No.: 2 of 2