

APPLICATION

A 21298

P _____

SEWAGE DISPOSAL TESTING

STATE OF MARYLAND - DEPARTMENT OF HEALTH AND MENTAL HYGIENE

HOWARD COUNTY HEALTH DEPARTMENT
ENVIRONMENTAL HEALTH SERVICESP. O. BOX 476, ELLICOTT CITY, MARYLAND 21043
TELEPHONE: 465-5000, EXT. 356DISTRICT 5DATE 3/31/75TO: THE COUNTY HEALTH OFFICER
ELLICOTT CITY, MARYLAND

I, HEREBY, APPLY FOR THE NECESSARY TEST IN ORDER TO CONSTRUCT (OR RECONSTRUCT) A SEWAGE DISPOSAL SYSTEM.

PROPERTY OWNER Allan Prevost (J. Jerome Blaney)ADDRESS 10548 Frederick Road, Ellicott City, Md. PHONE _____

PROPERTY LOCATION:

SUBDIVISION _____ LOT NO. _____

ROAD AND DESCRIPTION Route 108 - Clarksville PikeSIZE OF LOT almost 1 3/4 acre TYPE BLDG. Existing house
3
NUMBER OF BEDROOMS

IF NOT SINGLE RESIDENCE DESCRIBE _____

THE SYSTEM INSTALLED UNDER THIS APPLICATION IS ACCEPTABLE ONLY UNTIL PUBLIC FACILITIES BECOME AVAILABLE.

SIGNATURE OF APPLICANT /s/ Allan PrevostAPPROVED BY _____ FOR _____ DATE _____
(KIND OF SYSTEM)REJECTED BY _____ FOR _____ DATE _____
(KIND OF SYSTEM)

HOLD PENDING FURTHER TESTS _____ DATE _____

REASONS FOR REJECTION OR HOLDING _____

THIS IS NOT A PERMIT

INDICATE NORTH. - NAME ADJOINING ROADWAY AS BASE LINE

DATE	TEST NO.	DEPTH	PRE-WET		TEST - 1" DROP		TIME
			START	STOP	START	STOP	

REMARKS _____

TYPE OF SOIL _____

TESTED BY: _____ ALSO PRESENT: _____

See paid plot for notes

APPLICATION

A 21298

*4/9/75
9:30*

SEWAGE DISPOSAL TESTING

P _____

STATE OF MARYLAND - DEPARTMENT OF HEALTH AND MENTAL HYGIENE

HOWARD COUNTY HEALTH DEPARTMENT
ENVIRONMENTAL HEALTH SERVICES
P. O. BOX 476, ELlicOTT CITY, MARYLAND 21043
TELEPHONE 465-5000, EXT. 356

DISTRICT 5

DATE 3/31/75

Existing house

168 sq ft effective absorbent sidewall area per bedroom below the first 5 1/2 ft of non-absorbent soil at original grade. Maximum depth of system to be 11 1/2 ft. Local system approximately 95 ft from right side lot line and 30 ft back from existing fence at rear of present yard (which is about 20 ft toward front of lot from back edge of school yard black top) as seen from Rt 108.

I. HEREBY, APPLY FOR THE NECESSARY TEST IN ORDER TO CONSTRUCT (OR RECONSTRUCT) A SEWAGE DISPOSAL SYSTEM.

PROPERTY OWNER Allan Prevost (J. Jerome Blaney)

ADDRESS 10548 Frederick Road, Ellicott City, Md. PHONE _____

PROPERTY LOCATION:

SUBDIVISION _____ LOT NO. 1

ROAD AND DESCRIPTION Route 108 - Clarksville Pike - beside Clarksville School

SIZE OF LOT almost 1 3/4 acre TYPE BLDG. Existing house
NUMBER OF BEDROOMS 3

IF NOT SINGLE RESIDENCE DESCRIBE _____

THE SYSTEM INSTALLED UNDER THIS APPLICATION IS ACCEPTABLE ONLY UNTIL PUBLIC FACILITIES BECOME AVAILABLE.

SIGNATURE OF APPLICANT /s/ Allan Prevost

APPROVED BY A. H. Zepp FOR Dry well & trench or deep trenches DATE 4/9/75
(KIND OF SYSTEM)

REJECTED BY _____ FOR _____ DATE _____
(KIND OF SYSTEM)

HOLD PENDING FURTHER TESTS none DATE 4/9/75

REASONS FOR REJECTION OR HOLDING flat plot

THIS IS NOT A PERMIT

① 0 - Top soil
1/2 - clay type

6 -

Sandy loam


12 1/2 -

② 0 - Top soil
1/2 - clay type

6 -

sandy loam

13 -

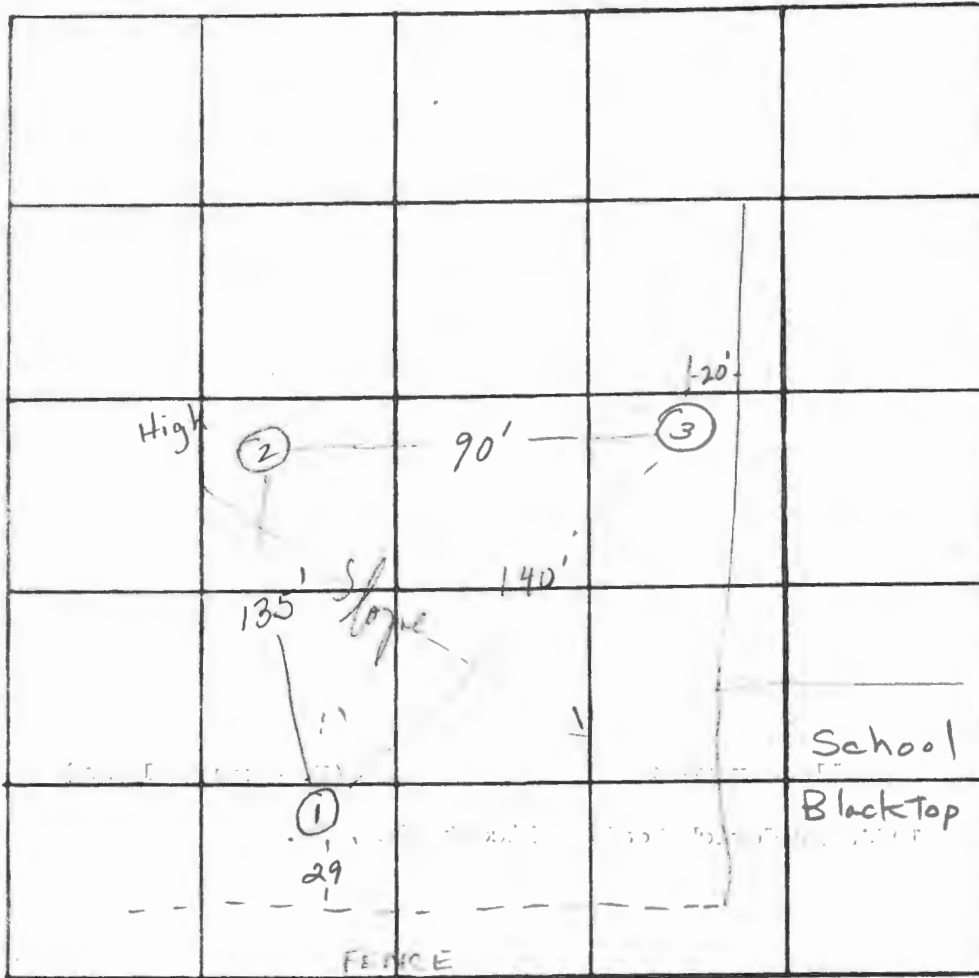

INDICATE NORTH - NAME ADJOINING ROADWAY AS BASE LINE

RT 108

③ 0 - Top soil
1/2 - clay type

6 -

sandy loam

13 -

DATE	TEST NO.	DEPTH	PRE-WET		TEST - 1" DROP		TIME
			START	STOP	START	STOP	
9/75	1	6	9:50	10:03	10:03	10:22	19
	1-A	12 1/2	9:53	9:56	9:56	10:03	7
	2	5 1/2	10:05	10:20	10:20	10:40	20
	2-A	13	10:00	10:03	10:03	10:09	6
	3	6	10:12	10:26	10:26	10:52	26
	3-A	13	10:28	10:30	10:30	10:35	5

$\bar{t} = 14 \text{ min}$
 140 A/BR
 $+ 20\% = 28 \text{ A}$
 \Downarrow
 168 A/BR

REMARKS

TYPE OF SOIL

sandy loam

TESTED BY

WWZ #JZ


ALSO PRESENT:

Prevost, Leadman


100-100-100-100



CORMAN MOUNTAIN
521/65

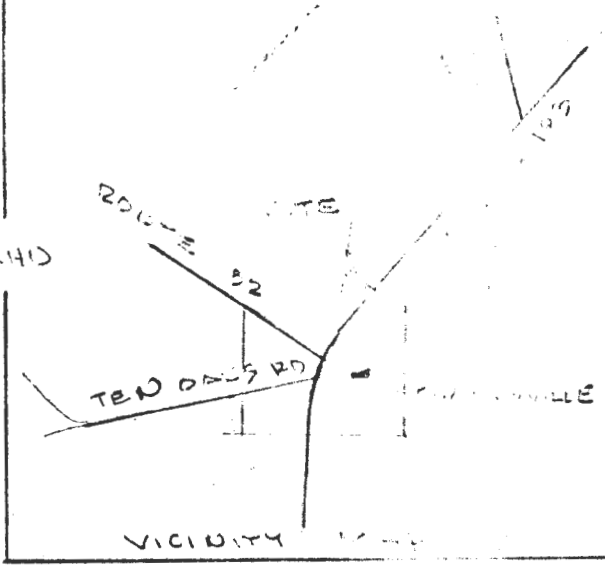

TAX MAP 24 PARCEL 24
TITLE REF. 275

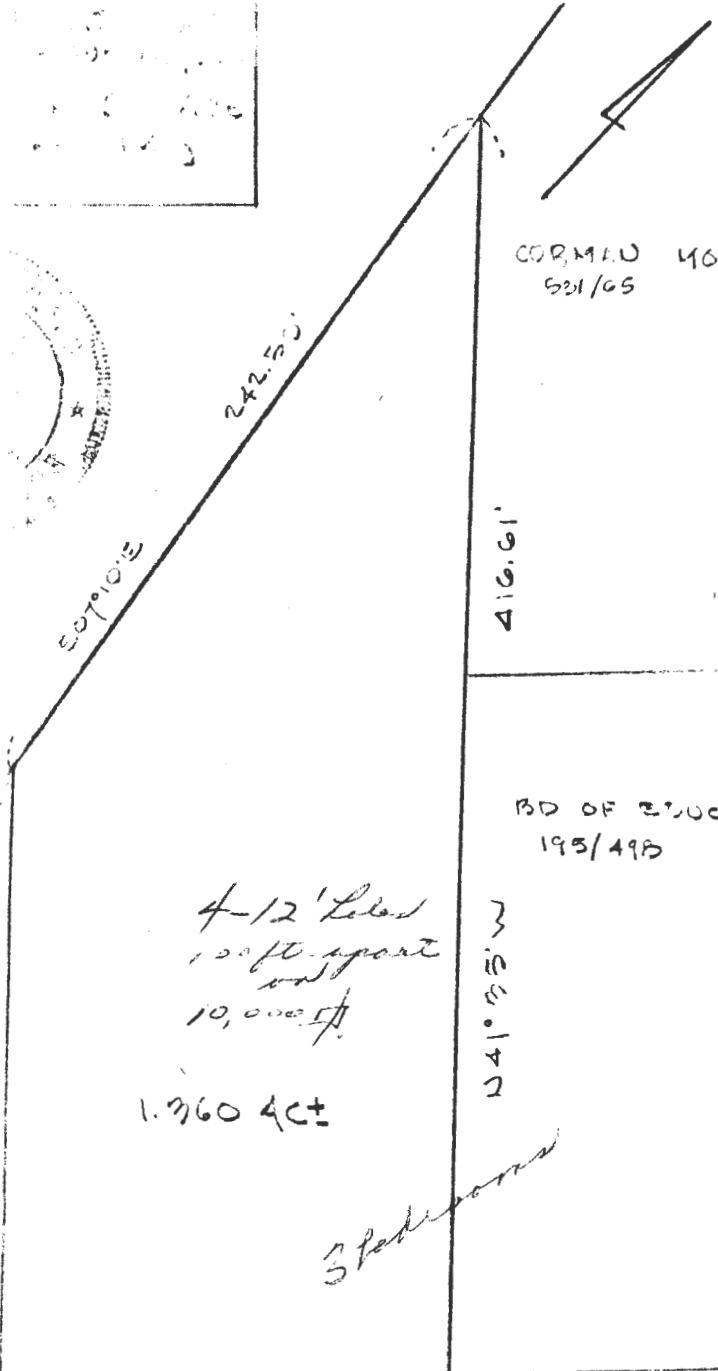


BD OF EDUCATION
195/498

4-12' Lot
120 ft. apart
10,000 sq ft
1.760 Acre

3 bedrooms

NOTE: THE LOT AND HERKON COMPLY WITH MINIMUM REQUIREMENTS WIDTH AND LOT AREA AS REQUIRED BY MARYLAND DEPT. OF HEALTH REGULATIONS.

54.20 E

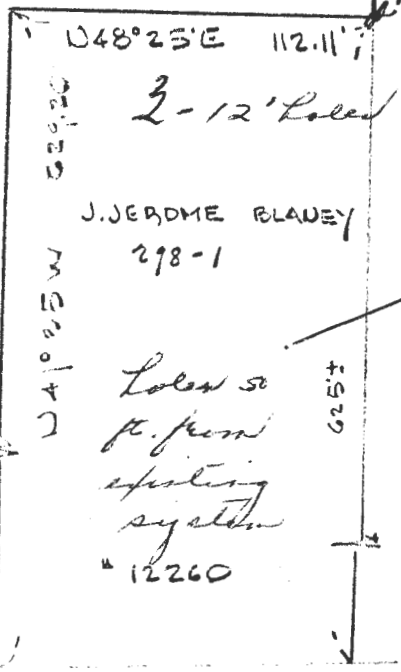

CLARKSVILLE SCHOOL
BD OF EDUCATION
161/484

J. JEROME BLANEY
298-1

Lot 50
ft. from
existing
system
12260

3 bedrooms

APPROVED:
PRIVATE WATER & SEWER
COUNTY HEALTH OFFICE DATE

100-100-100-100
100 - CLARKSVILLE PIKE

PROPERTY OF
ALLAN PREVOST
CLARKSVILLE
5TH EL. DIST. HOWARD CO. MD
SCALE 1" = 60'
DATE: MAR 20, 1975

10548 Med. Rd.
E.C. 71043