

PERMIT NUMBER: B

20002475

DATE ACCEPTED:

RECEIVED



RESIDENTIAL BUILDING PERMIT APPLICATION

JUL 28 2020

HOWARD COUNTY DEPARTMENT OF INSPECTIONS, LICENSES, AND PERMITS
 3430 COURT HOUSE DRIVE, ELLICOTT CITY, MD 21043 - PHONE: (410) 313-2455
 WWW.HOWARDCOUNTYMD.GOV

BUILDING SITE ADDRESS REQUIRED

Street Address: 12233 HAYLAND FARM WAY Unit:
 City: ELLICOTT CITY State: MD Zip Code: 21042
 Subdivision/Village/Complex Name: WALNUT CREEK SDP/WP/BA #:
 Lot: 83 Tax Map: Parcel: Grading Permit #:

DESCRIPTION OF WORK REQUIRED

Existing Use: 1ST AND 2ND FLOOR HOME Proposed Use: FINISH THE BASEMENT Estimated Cost: \$65,000.00
 Trade Work to Be Completed (Separate Permits Required): Mechanical (HVACR) Electrical Plumbing None
 BASEMENT LEVEL TO BE FINISHED. THE WHOLE BASEMENT TO BE FINISHED AS FOLLOWS - 1 RECREATION ROOM, 1 MEDIA ROOM, 1 BED ROOM WITH ATTACHED BATHROOM, 1 POWDER ROOM, FINISHED AREA FOR GYM AND STORAGE ROOM WITH AN ADDITIONAL BATHROOM.

PROPERTY OWNER INFORMATION REQUIRED

Owner(s) Name(s) (As it appears on tax records): MADHU VENKATA NADIMPALLI Primary Residence: Yes No
 Owner's Street Address: 12233 HAYLAND FARM WAY
 City: ELLICOTT CITY State: MARYLAND Zip Code: 21042
 Phone: (201) 257-7095 Email: hdllc3114@gmail.com

APPLICANT NAME REQUIRED - INDIVIDUAL WHO SIGNS THIS APPLICATION

Business Name: Contact Name: MADHU VENKATA NADIMPALLI
 Street Address: 12233 HAYLAND FARM WAY
 City: ELLICOTT CITY State: MARYLAND Zip Code: 21042
 Phone: (201) 257-7095 Email: hdllc3114@gmail.com

CONTRACTOR INFORMATION REQUIRED

Business Name: MADHU VENKATA NADIMPALLI (SELF) License #:
 Licensee's Name:
 Street Address: 12233 HAYLAND FARM WAY
 City: ELLICOTT CITY State: MARYLAND Zip Code: 21042
 Phone: (201) 257-7095 Email: hdllc3114@gmail.com

ARCHITECT/ENGINEER INFORMATION INDIVIDUAL WHO SIGNED PLANS, IF APPLICABLE

Business Name: DW TAYLOR ASSOCIATES ARCHITECT Name: EVA CASTILLO
 Street Address: 5024 DORSEY HALL DRIVE, SUITE 203
 City: ELLICOTT CITY State: MARYLAND Zip Code: 21042
 Phone: Email:

BUILDING CHARACTERISTICS REQUIRED

Primary Structure: SF Dwelling SF Townhouse SF Duplex Mobile Home Multi-Family Dwelling (MF*) Condo: Yes No
 Utilities: Electric Gas Water Supply: Public Private (Well) Sewage Disposal: Public Private (Septic)
 Heating System: Electric Natural Gas Propane Other: Roadside Tree Project: No Yes: #
 Sprinkler System: NFPA 13 NFPA 13R NFPA 13D None Fire Alarm System: Yes No Voice Evac

ADDITIONAL RESIDENTIAL INFORMATION (PLEASE SELECT/COMPLETE ALL THAT APPLY)

Model Name & Options: CUSTOM HOME
 # of Bedrooms (SF): 4 # of efficiency units (MF*): # of 1 BR (MF*): # of 2 BR (MF*): # of 3 BR (MF*):
 # Rooms: # Full Baths: 4 # Half Baths: 1 # Fireplaces: 1
 Garage/Carport Info: Attached Garage Detached Garage Integral Garage Carport None
 Basement/Foundation Info: Slab on Grade Post & Pier Unfinished Basement Finished Basement: Full or Partial
 1st Fl Width: 1st Fl Depth: 2nd Fl Width: 2nd Fl Depth: Bsmt Width: Bsmt Depth:
 Energy Method: Prescriptive Performance UA Alternative ERI Gross Area: sq ft Occupiable Area: 4,859 sq ft

AGREEMENT/ DISCALIMER REQUIRED

THE UNDERSIGNED HEREBY CERTIFIES AND AGREES AS FOLLOWS: (1) THAT HE/SHE IS AUTHORIZED TO MAKE THIS APPLICATION; (2) THAT THE INFORMATION IS CORRECT; (3) THAT HE/SHE WILL COMPLY WITH ALL REGULATIONS OF HOWARD COUNTY WHICH ARE APPLICABLE THERETO; (4) THAT HE/SHE WILL PERFORM NO WORK ON THE ABOVE REFERENCED PROPERTY NOT SPECIFICALLY DESCRIBED IN THIS APPLICATION; (5) THAT HE/SHE GRANTS COUNTY OFFICIALS THE RIGHT TO ENTER ONTO THIS PROPERTY FOR THE PURPOSE OF INSPECTING THE WORK PERMITTED AND POSTING NOTICES.

APPLICANT'S ORIGINAL SIGNATURE: DATE SIGNED: 07/23/2020


FOR OFFICE USE ONLY

CHECKS PAYABLE TO: DIRECTOR OF FINANCE OF HOWARD COUNTY

AGENCIES REQUIRED/APPROVALS:
 PR DPZ DED Health SHA CID
 SUBMITTAL FEES: 135- PAYMENT: 399 ACCEPTED BY: DROP BOY

Proposed Basement Plan

Basements

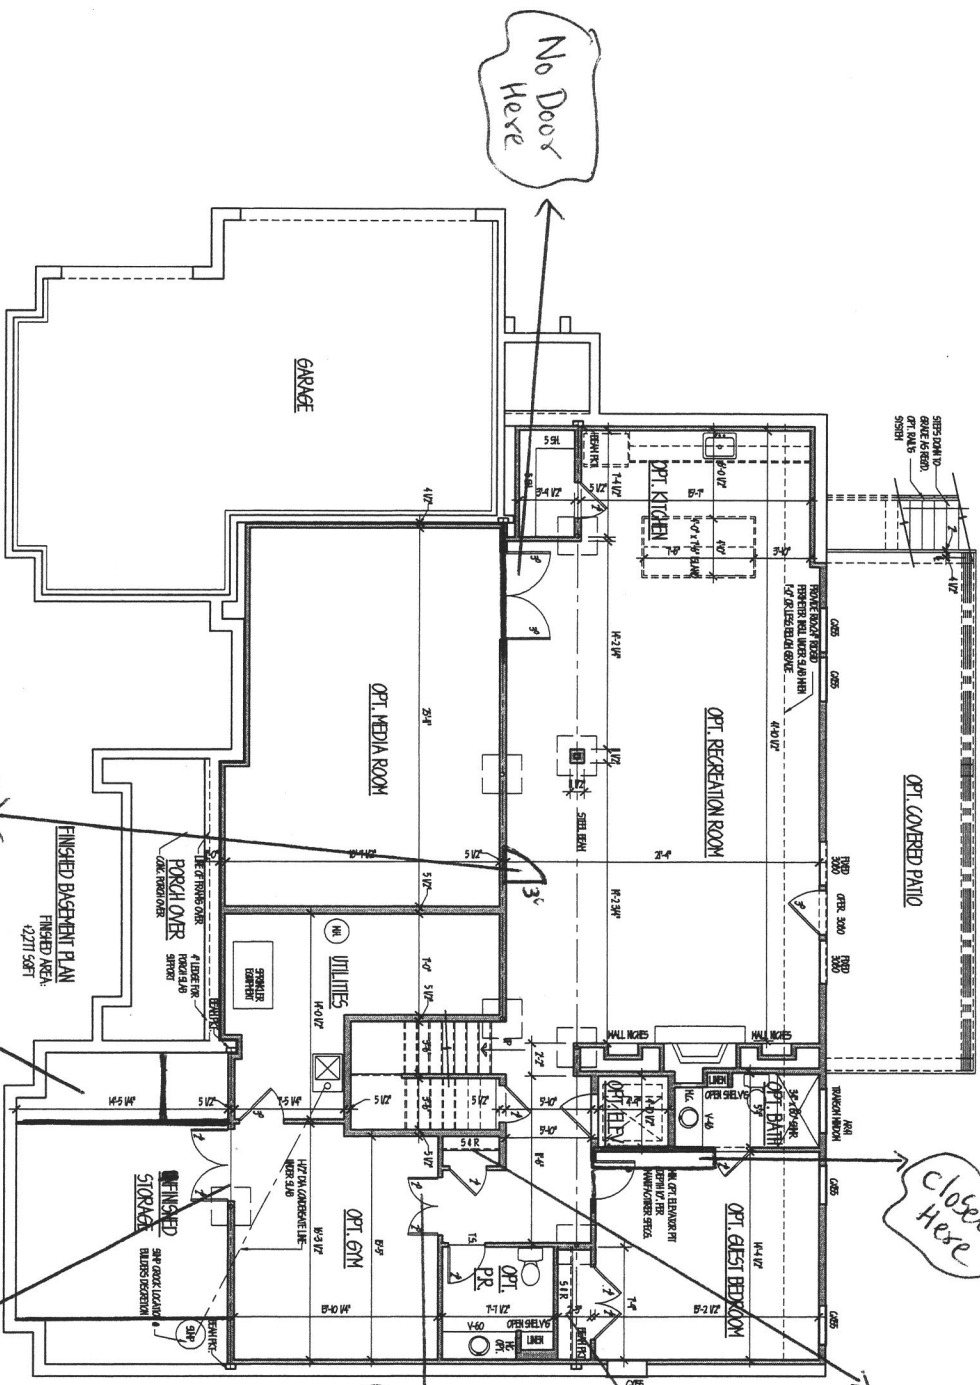

No Doors Here

Media Room Doors Here

Additional Bathroom

Not 2 Doors only 1 Door

NO Doors Here, open

No closet Here

No closet Here

closet Here

PROJECT NUMBER		2625	
DRAWING NUMBER		A22	
PROJECT TITLE			
CAIRN CUSTOM HOMES			
MADONPALLI RESIDENCE			
CONTENT			
FINISHED BASEMENT			

dw Taylor
 OSOCCO ARCHITECT
 ARCHITECT

BID & PERMIT SET

DATE: 04-01-2018

PROJECT: CAIRN CUSTOM HOMES

PROJECT TITLE: MADONPALLI RESIDENCE

CONTENT: FINISHED BASEMENT

EXAMINER: [Signature]

DATE: [Date]

SCALE: AS SHOWN

NOTE:
 1. ALL DIMENSIONS ARE TO FACE UNLESS OTHERWISE NOTED.
 2. FINISHES AND MATERIALS TO BE DETERMINED BY THE ARCHITECT.
 3. DIMENSIONS SHOWN ON THIS SET ARE SPAN AT HALF OF THE GRID-TO-GRID.

dw taylor
 ASSOCIATES, LLC
 ARCHITECT


BID & PERMIT SET

PROJECT TITLE
 CARRY CUSTOM HOMES
 MADRIDPALLI RESIDENCE

CONTENT
 FIRST FLOOR PLAN

PROJECT NUMBER
 2625

DRAWING NUMBER
 A3

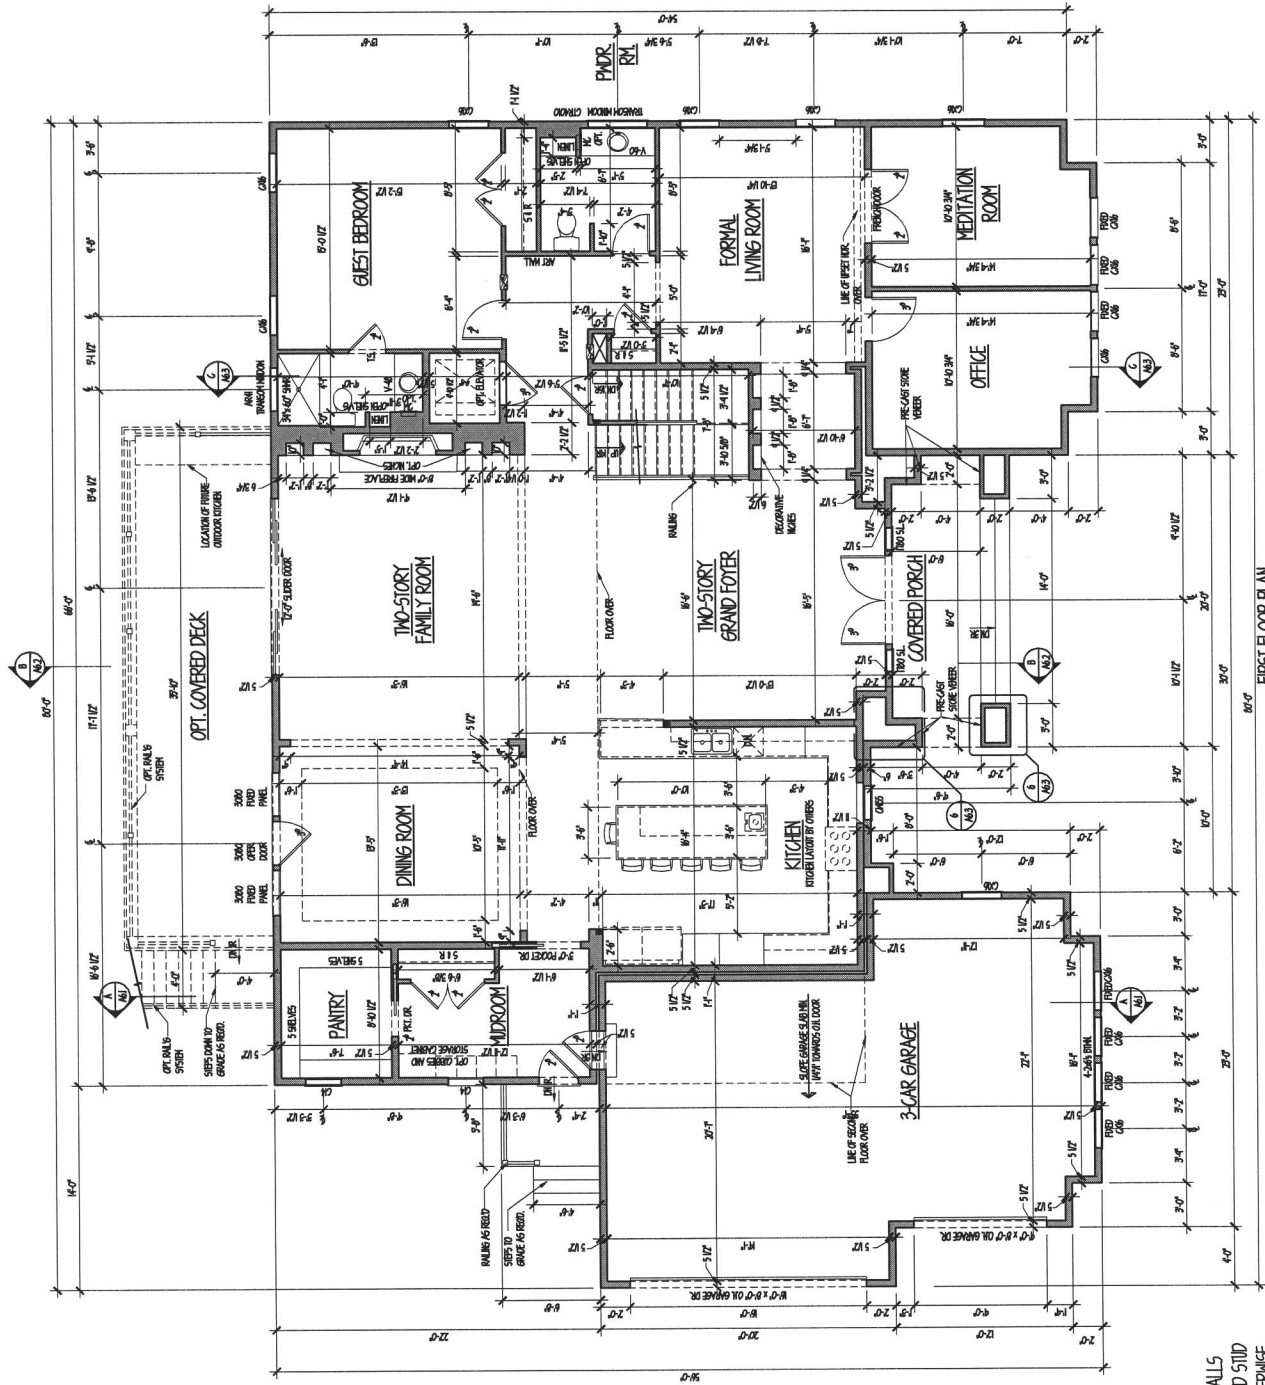

FIRST FLOOR PLAN
 2/26/2021

*** ALL EXTERIOR WALLS
 CONSIST OF 2X6 WOOD STUD
 FRAMING UNLESS OTHERWISE
 NOTED