

RECEIVED

PERMIT NUMBER: B 20001478

DATE ACCEPTED:

MAY 12 2020



RESIDENTIAL BUILDING PERMIT APPLICATION

HOWARD COUNTY DEPARTMENT OF INSPECTIONS, LICENSES, AND PERMITS
3430 COURT HOUSE DRIVE, ELLICOTT CITY, MD 21043 - PHONE: (410) 313-2455 OPTION #4
www.howardcountymd.gov

LICENSES & PERMITS DIVISION

BUILDING SITE ADDRESS
Street Address: 7335 Mink Hollow Rd
City: Highland
State: MD
Zip Code: 20777

DESCRIPTION OF WORK
Existing Use: Single Family Dwelling
Proposed Use: Addition Screen Porch
Estimated Cost: \$ 160,000
Extend unfinished basement & 1st floor family room
Small deck & Patio w/ Screen Porch - 2 levels

PROPERTY OWNER INFORMATION
Owner(s) Name(s): Heather & Marc Borowski
Owner's Street Address: 7335 Mink Hollow Rd
City: Highland
State: MD
Zip Code: 20777

APPLICANT NAME
Business Name: John D. Miller Builders Inc
Contact Name: Dan Miller
Street Address: 12075 Old Frederick Rd
City: Marriottsville
State: MD
Zip Code: 21104

CONTRACTOR INFORMATION
Business Name: John D. Miller Builders Inc.
Licensee's Name: Dan Miller
License #: 67861
Street Address: 12075 Old Frederick Rd
City: Marriottsville
State: MD
Zip Code: 21104

ARCHITECT/ENGINEER INFORMATION
Business Name: Andre G. Fontaine Architect
Name: Andre Fontaine
Street Address: 70 Box 357 3925 Old Killim Rd
City: Glenelg
State: MD
Zip Code: 21737

BUILDING CHARACTERISTICS
Primary Structure: SF Dwelling
Utilities: Electric
Heating System: Electric
Sprinkler System: NFPA 13


ADDITIONAL RESIDENTIAL INFORMATION
of Bedrooms (SF):
of efficiency units (MF*):
of 1 BR (MF*):
of 2 BR (MF*):
of 3 BR (MF*):

AGREEMENT DISCALIMER
THE UNDERSIGNED HEREBY CERTIFIES AND AGREES AS FOLLOWS: (1) THAT HE/SHE IS AUTHORIZED TO MAKE THIS APPLICATION; (2) THAT THE INFORMATION IS CORRECT; (3) THAT HE/SHE WILL COMPLY WITH ALL REGULATIONS OF HOWARD COUNTY WHICH ARE APPLICABLE THERETO; (4) THAT HE/SHE WILL PERFORM NO WORK ON THE ABOVE REFERENCED PROPERTY NOT SPECIFICALLY DESCRIBED IN THIS APPLICATION; (5) THAT HE/SHE GRANTS COUNTY OFFICIALS THE RIGHT TO ENTER CONTO THIS PROPERTY FOR THE PURPOSE OF INSPECTING THE WORK PERMITTED AND POSTING NOTICES.

APPLICANT'S ORIGINAL SIGNATURE: [Signature] DATE SIGNED: May 11 2020

FOR OFFICE USE ONLY
AGENCIES REQUIRED/APPROVALS:
SUBMITTAL FEES: PAYMENT: ACCEPTED BY:

No payment - x dropbox x

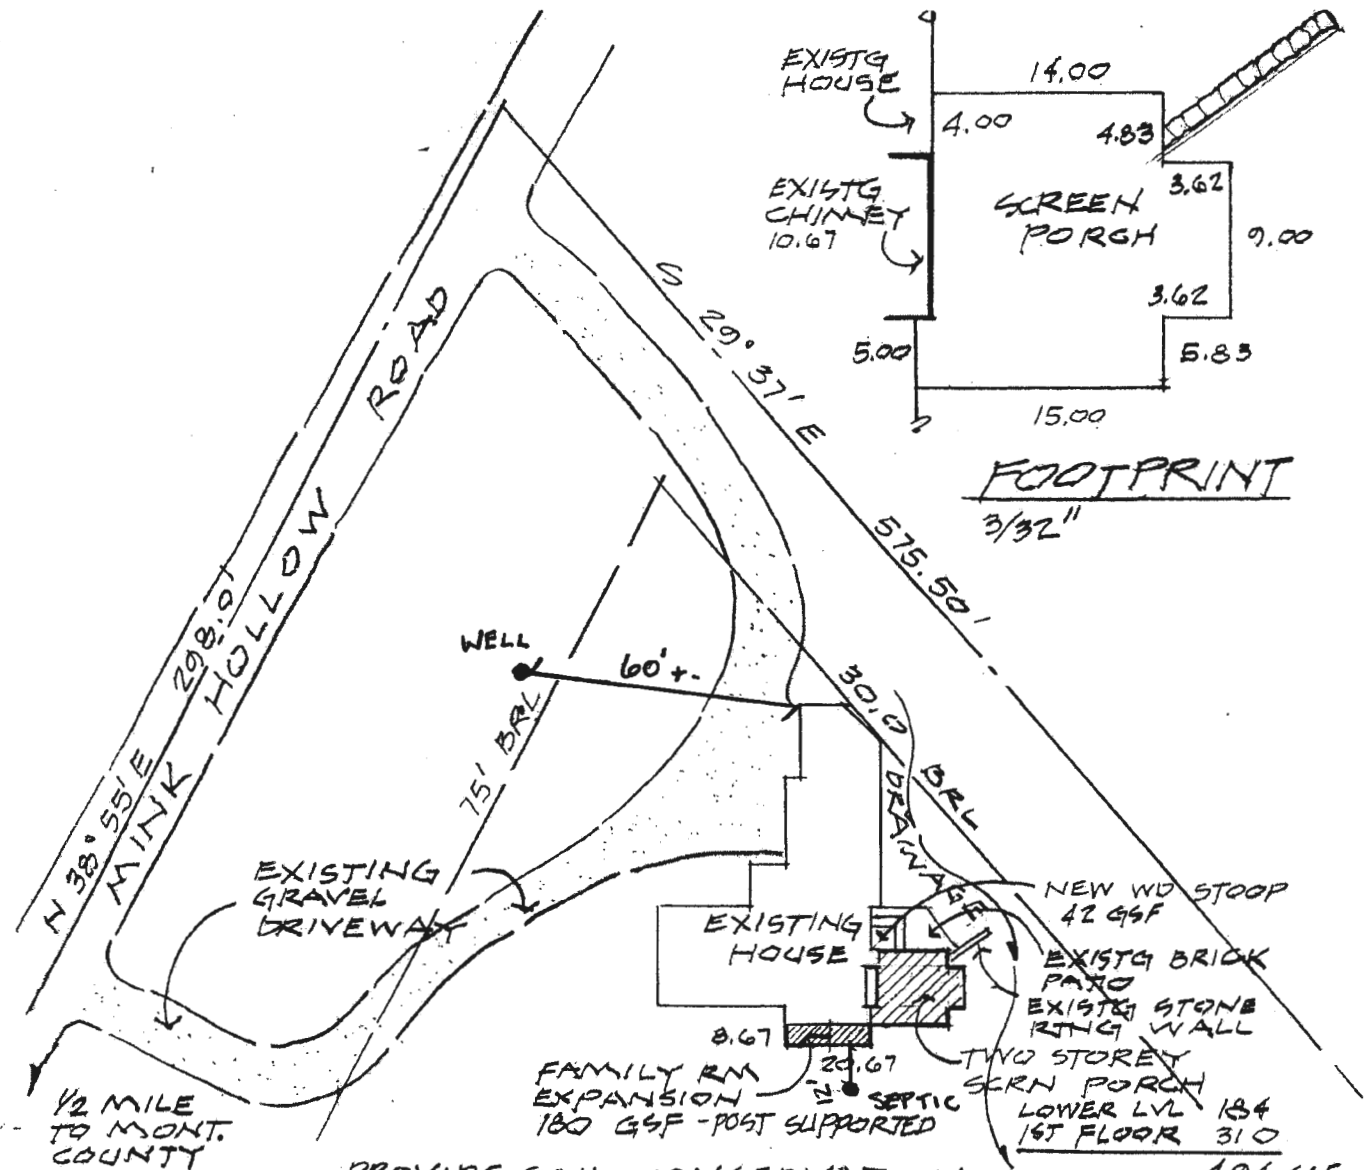

PROVIDE SOIL CONSERVATION MEASURES AS REQUIRED

PARTIAL SITE PLAN

1" EQUALS 40'-0"
 MAP 0040 GRID 0007 PARCEL 55
 ZONED RR 4.200 ACRES
 7335 MINK HOLLOW RD,
 HIGHLAND
 HOWARD COUNTY
 MARYLAND 20777-9777

Approved Septic System Plan
Howard County Health Department

Devar
 Signature Date 5-19-20
 B20001478

3-8-17
 SHEET
 1
 OF ONE
 1504-4L

ADDITIONS & ALTERATIONS FOR
HEATHER & MARC BOROWSKI
 7335 MINK HOLLOW RD, HIGHLAND, MD 20777-9777
 ANDRE G. FONTAINE ARCHITECT
 (410) 531-3025