

OCT 29 2020

PERMIT NUMBER: B 2000392

DATE ACCEPTED:



RESIDENTIAL BUILDING PERMIT APPLICATION

HOWARD COUNTY DEPARTMENT OF INSPECTIONS, LICENSES, AND PERMITS

3430 COURT HOUSE DRIVE, ELLICOTT CITY, MD 21043 - PHONE: (410) 313-2455 OPTION #4 www.howardcountymd.gov

BUILDING SITE ADDRESS REQUIRED

Street Address: 14701 Burntwoods Rd Unit: /
City: Glenely State: MD Zip Code: 21730
Subdivision/Village/Complex Name: Fairfield Estates SDP/WP/BA #:
Lot: 3 Tax Map: 0021 Parcel: 0159 Grading Permit #:

DESCRIPTION OF WORK REQUIRED

Existing Use: SFD Proposed Use: SFD w/ single story breakfast nook Estimated Cost: \$25,000
Trade Work to Be Completed (Separate Permits Required): [x] Mechanical (HVAC) [x] Electrical [ ] Plumbing [ ] None
Contract 10' x 15' single-story addition on crawl space (Breakfast Nook)

PROPERTY OWNER INFORMATION REQUIRED

Owner(s) Name(s) (As it appears on tax records): Matthew Kutz and Scoville Primary Residence: [x] Yes [ ] No
Owner's Street Address: 14701 Burntwoods Rd Brooks
City: Glenely State: MD Zip Code: 21730
Phone: Mr Kutz - 410-567-6436 Email:

APPLICANT NAME REQUIRED - INDIVIDUAL WHO SIGNS THIS APPLICATION

Business Name: W.R. Becker LLC Contact Name: Bill Becker 443-829-6686
Street Address: 15300 Carrs Hill Rd
City: Woodbine State: MD Zip Code: 21797
Phone: 410-442-5737 Email: JMBBecker@AUC.com

CONTRACTOR INFORMATION REQUIRED

Business Name: W.R. Becker LLC
Licensee's Name: William R. Becker License #: 33072
Street Address: 15300 Carrs Hill Rd
City: Woodbine State: MD Zip Code: 21797
Phone: 410-442-5737 Email: Jmbbecker@AUC.com

ARCHITECT/ENGINEER INFORMATION INDIVIDUAL WHO SIGNED PLANS, IF APPLICABLE

Business Name: Name:
Street Address: NONE
City: State: Zip Code:
Phone: Email:

BUILDING CHARACTERISTICS REQUIRED

Primary Structure: [x] SF Dwelling [ ] SF Townhouse [ ] SF Duplex [ ] Mobile Home [ ] Multi-Family Dwelling (MF\*) Condo: [ ] Yes [x] No
Utilities: [x] Electric [ ] Gas Water Supply: [ ] Public [x] Private (Well) Sewage Disposal: [ ] Public [x] Private (Septic)
Heating System: [x] Electric [ ] Natural Gas [ ] Propane [ ] Other: Roadside Tree Project: [x] No [ ] Yes: #
Sprinkler System: [ ] NFPA 13 [ ] NFPA 13R [ ] NFPA 13D [x] None Fire Alarm System: [ ] Yes [x] No [ ] Voice Evac

ADDITIONAL RESIDENTIAL INFORMATION (PLEASE SELECT/COMPLETE ALL THAT APPLY)

Model Name & Options:
# of Bedrooms (SF): # of efficiency units (MF\*): # of 1 BR (MF\*): # of 2 BR (MF\*): # of 3 BR (MF\*):
# Rooms: # Full Baths: # Half Baths: # Fireplaces:
Garage/Carport Info: [ ] Attached Garage [ ] Detached Garage [ ] Integral Garage [ ] Carport [ ] None
Basement/Foundation Info: [ ] Slab on Grade [ ] Post & Pier [ ] Unfinished Basement [ ] Finished Basement: [ ] Full or [ ] Partial
1st Fl Width: 1st Fl Depth: 2nd Fl Width: 2nd Fl Depth: Bsmt Width: Bsmt Depth:
Energy Method: [ ] Prescriptive [x] Performance [x] UA Alternative [ ] ERI Gross Area: sq ft Occupiable Area: sq ft

AGREEMENT/ DISCALIMER REQUIRED

THE UNDERSIGNED HEREBY CERTIFIES AND AGREES AS FOLLOWS: (1) THAT HE/SHE IS AUTHORIZED TO MAKE THIS APPLICATION; (2) THAT THE INFORMATION IS CORRECT; (3) THAT HE/SHE WILL COMPLY WITH ALL REGULATIONS OF HOWARD COUNTY WHICH ARE APPLICABLE THERETO; (4) THAT HE/SHE WILL PERFORM NO WORK ON THE ABOVE REFERENCED PROPERTY NOT SPECIFICALLY DESCRIBED IN THIS APPLICATION; (5) THAT HE/SHE GRANTS COUNTY OFFICIALS THE RIGHT TO ENTER ONTO THIS PROPERTY FOR THE PURPOSE OF INSPECTING THE WORK PERMITTED AND POSTING NOTICES.

APPLICANT'S ORIGINAL SIGNATURE DATE SIGNED 10/29/20

FOR OFFICE USE ONLY

CHECKS PAYABLE TO: DIRECTOR OF FINANCE OF HOWARD COUNTY


AGENCIES REQUIRED/APPROVALS:
[ ] PR [ ] DPZ [x] DED [ ] Health [ ] SHA [ ] CID
SUBMITTAL FEES: \$25.00 PAYMENT: \*NONE SUBMITTED ACCEPTED BY: D-KOPR

# Landtech Associates Inc.

10260 Old Columbia Road Rivers Center-Suite J

Columbia, MD 21046

Phone: 410-290-8099 Fax: 410-290-8299

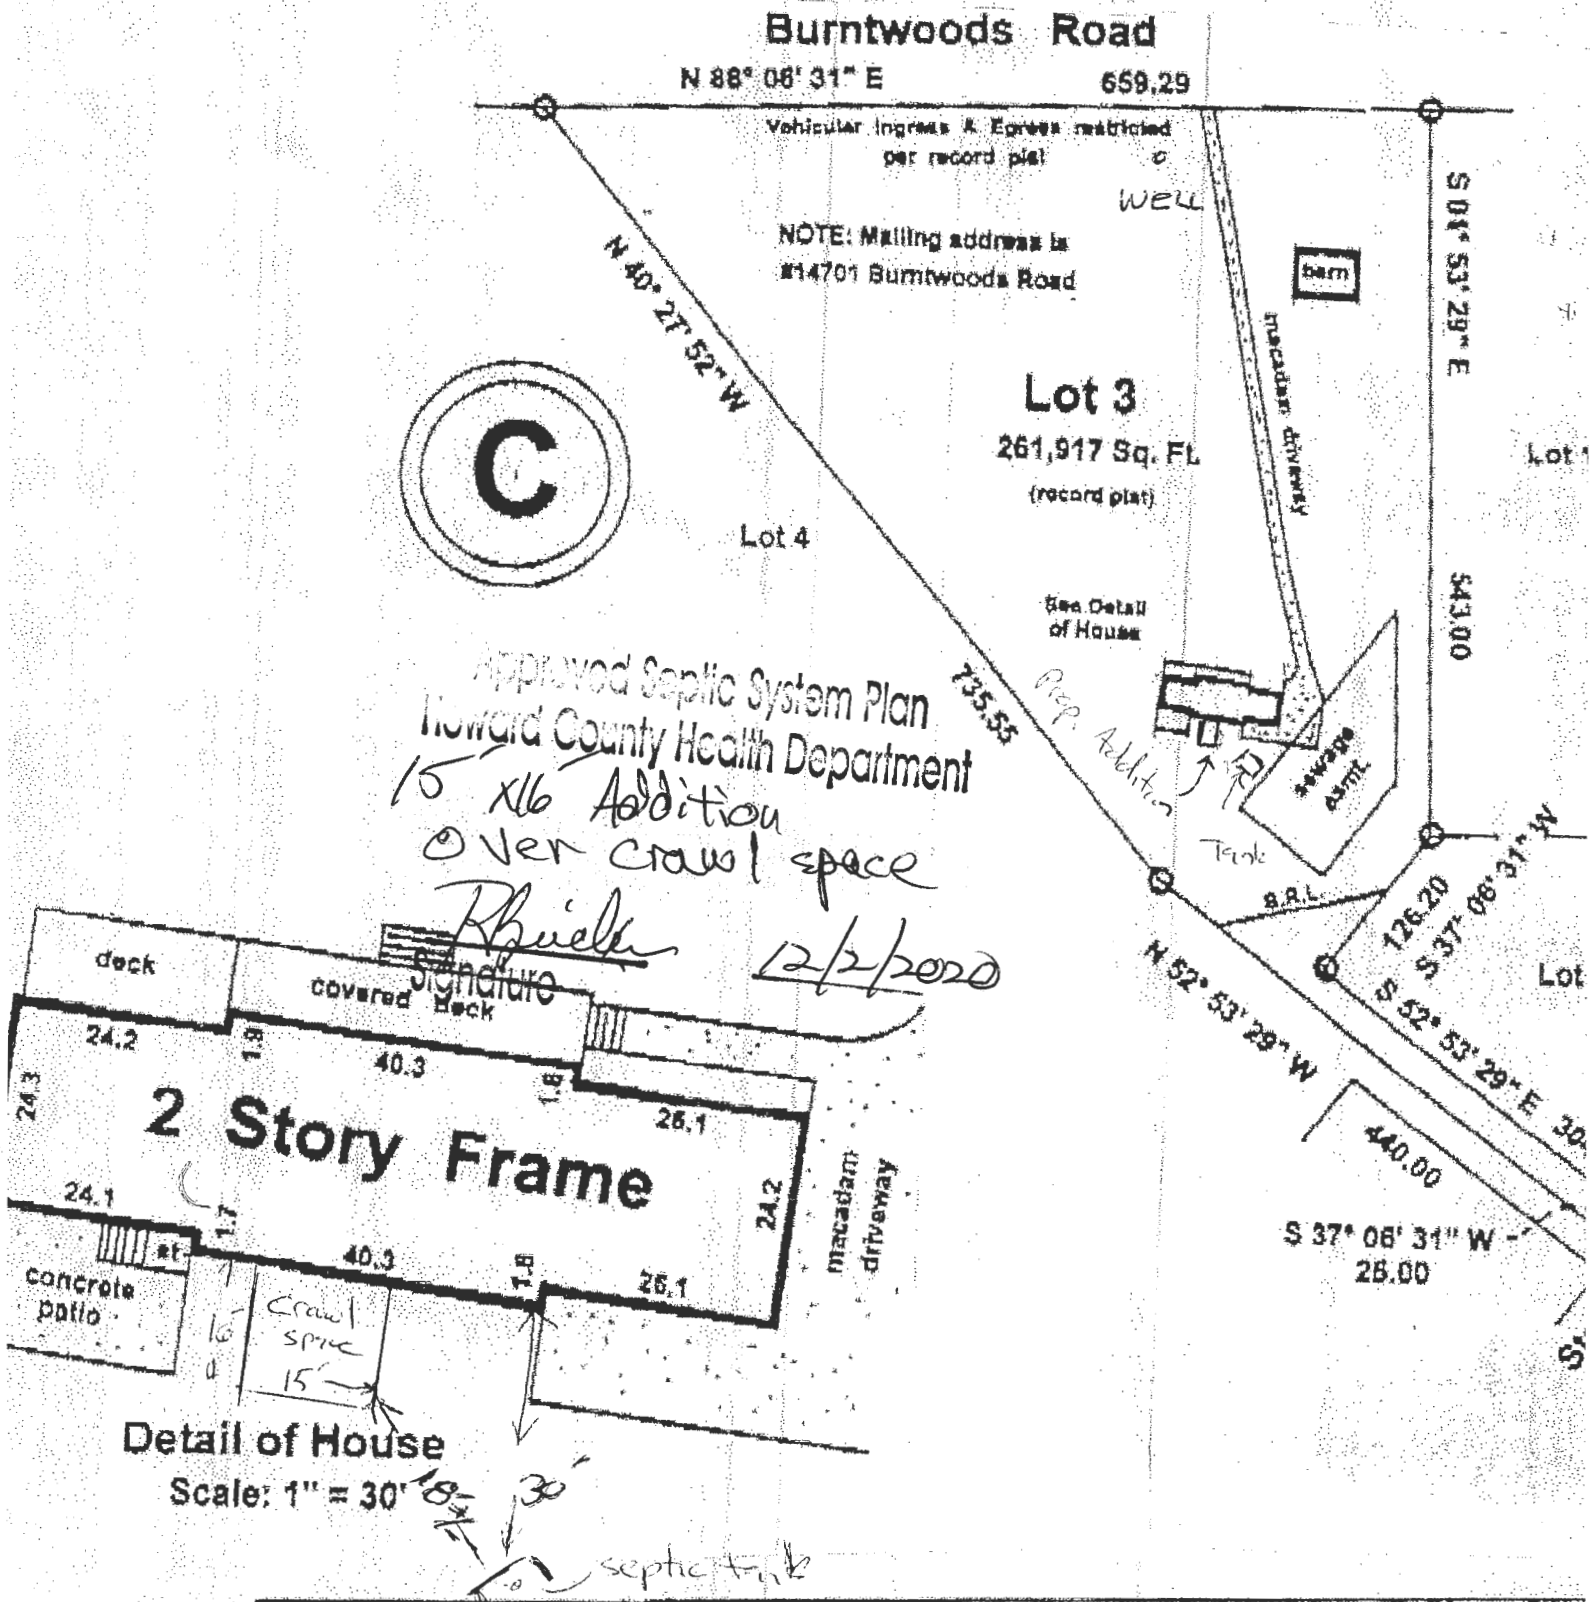

Location Survey of:	LOT: 3	BLOC
14701 Burntwoods Rd.	PLAT BK: 29	PLAT
Section Six	DATE: 01-21-13	SCALE
<b>Warfield Estates</b>	CASE NUMBER:	5

KUTZ ADDITION 1421 BURNWOOD RD GLENELG MD

EXISTING HOUSE

Wx-Af-20 100 NW

