

Menu Save Reset Cancel Help

Record Detail * (This section is required.)

Permit Type	Permit Number	Opened Date
Building/Residential/Alteration/SFD	B19004147	12/09/2019
Description of Work		
SFD/ ENLARGE (2) OPENINGS IN LOAD-BEARING WALL BETWEEN LIVING ROOM AND HALL & LIVING ROOM & DINING ROOM, APPROXIMATELY 20 SQ FT		

check spelling

approved
12/23/19
JPP

Address * (This section is required.)

Search Reset Clear Get Parcel & Owner

Street #	Street Name	Street Type	
7015	DEER VALLEY	RD	
Unit Type	Unit #	X Coordinate	Y Coordinate
--Select--		-76.97585	39.17944
City	State	Zip Code	Primary
HIGHLAND	MD	20777	Yes

Parcel * (This section is required.)

Search Reset Clear Get Address & Owner

GIS ID *	Parcel	Parcel Area	Land Value	Improved Value	Exemption Value	Plan Area
850792	480	2.05	248000	459700	211700	RURAL
Legal Description						
IMPS2.050 AR S3 7015 DEER VALLEY RD CISSELL FARM						

check spelling

Block	Lot	Census Tract	Council Dist	Inspection Dist	Supervisor Dist	Map #	DAP Zone
	37-A	605101	5				
Plan Area	State Tax Id	Subdivision Name					
	1405378028	CISSELL FARM					
Section	Area	Tax Map					
		40					
Grid	Zoning District	ADC Map					
40-3	RR-DEO	5051-D2					
SDP No.	Final Plan No.	WP File No.					
Record Plat No.	WS Contract No.	FDP No.	Primary				
			Yes				
Owner Occupied	Year Built	Historic District					
<input type="radio"/> Yes <input type="radio"/> No	1979	<input type="radio"/> Yes <input checked="" type="radio"/> No					
Historic District Registry No.	Stat Area	Flood Plain					
	5-04A	<input type="radio"/> Yes <input checked="" type="radio"/> No					
Building No							

Owner (This section is not required.)

Search Reset Clear

Name *		
TAYLOR KURT L		
Address Line 1		
7015 DEERVALLEY RD		
Address Line 2		
Address Line 3		
Mail City	Mail State	Mail Zip Code
HIGHLAND	MD	20777
Phone	Primary	
410-499-1020	Yes	
E-mail		
Cell Number	Fax Number	

Professionals (This section is not required.)

Search Reset Clear

License # *	Business Name		
08050135861	BLACKSTONE KITCHEN AND BATH LLC		
License Type *	First Name	Middle Name	Last Name
MHIC Co	JAOUAD		ZOUINE
Primary	Address Line 1		
Yes	3317 STAPLETON DRIVE		
	Address Line 2		
	City	State	ZIP Code
	GLENWOOD	MD	21738-0000
	Phone 1	Phone 2	Fax
	4437799961		0000000000
	E-mail		
	JOE@BLACKSTONEKITCHENANDBATH.COM		

Applicant (This section is not required.)

Search As Owner As Lic. Prof As Contact

Type *	First Name	MI	Last Name
Applicant	ALP		AYDIN
Relationship	Full Name		
Applicant	ALP AYDIN		
Primary	Organization Name		
No	BLACKSTONE KITCHEN AND BATH		
	Street Address		
	2480 ROUTE 97 SUITE 8		
	Address Line 2		
	City	State	Zip Code
	GLENWOOD	MD	21738
	Phone	Cell	Fax
	410-449-1020		
	E-mail *		
	alp@blackstonekb.com		

Contact (This section is not required.)

Search As Owner As Lic. Prof As Contact

Type	First Name	MI	Last Name
Contact	ALP		AYDIN
Relationship	Full Name		
Applicant	ALP AYDIN		
Primary	Organization Name		
Yes	BLACKSTONE KITCHEN AND BATH		
	Street Address		
	2480 ROUTE 97 SUITE 8		
	Address Line 2		
	City	State	Zip Code
	GLENWOOD	MD	21738
	Phone	Cell	Fax
	410-449-1020		
	E-mail		
	alp@blackstonekb.com		

Addl Info

Est Construction Cost *	Housing Units *	Number of Buildings *	Public Owned
7000	0	0	No
Construction Type			
434 - Additions, Alterations and Conversions - Residential			

RESIDENTIAL ALTERATION INFO

RESIDENTIAL ALTERATION INFORMATION


Total Square Footage *	Bedrooms	Full Baths	Half Baths	Water *	Sewage *	Existing Utilities *
20 SQFT				Private	Private	Gas & Electric
Existing Heating System *	Existing Sprinkler System *	Type of New Fireplace	Expiration Date	Fee Exempt *		
Electric	None	--Select--	8/20/2020	<input type="radio"/> Yes <input checked="" type="radio"/> No		

PAYMENT INFORMATION


Check 1	Payee 1	Check 2	Payee 2	SAP Doc No	SAP Entered
<input type="text"/>	<input type="text"/>	<input type="text"/>	<input type="text"/>	<input type="text"/>	<input type="text"/>

Submit Cancel

New Plan

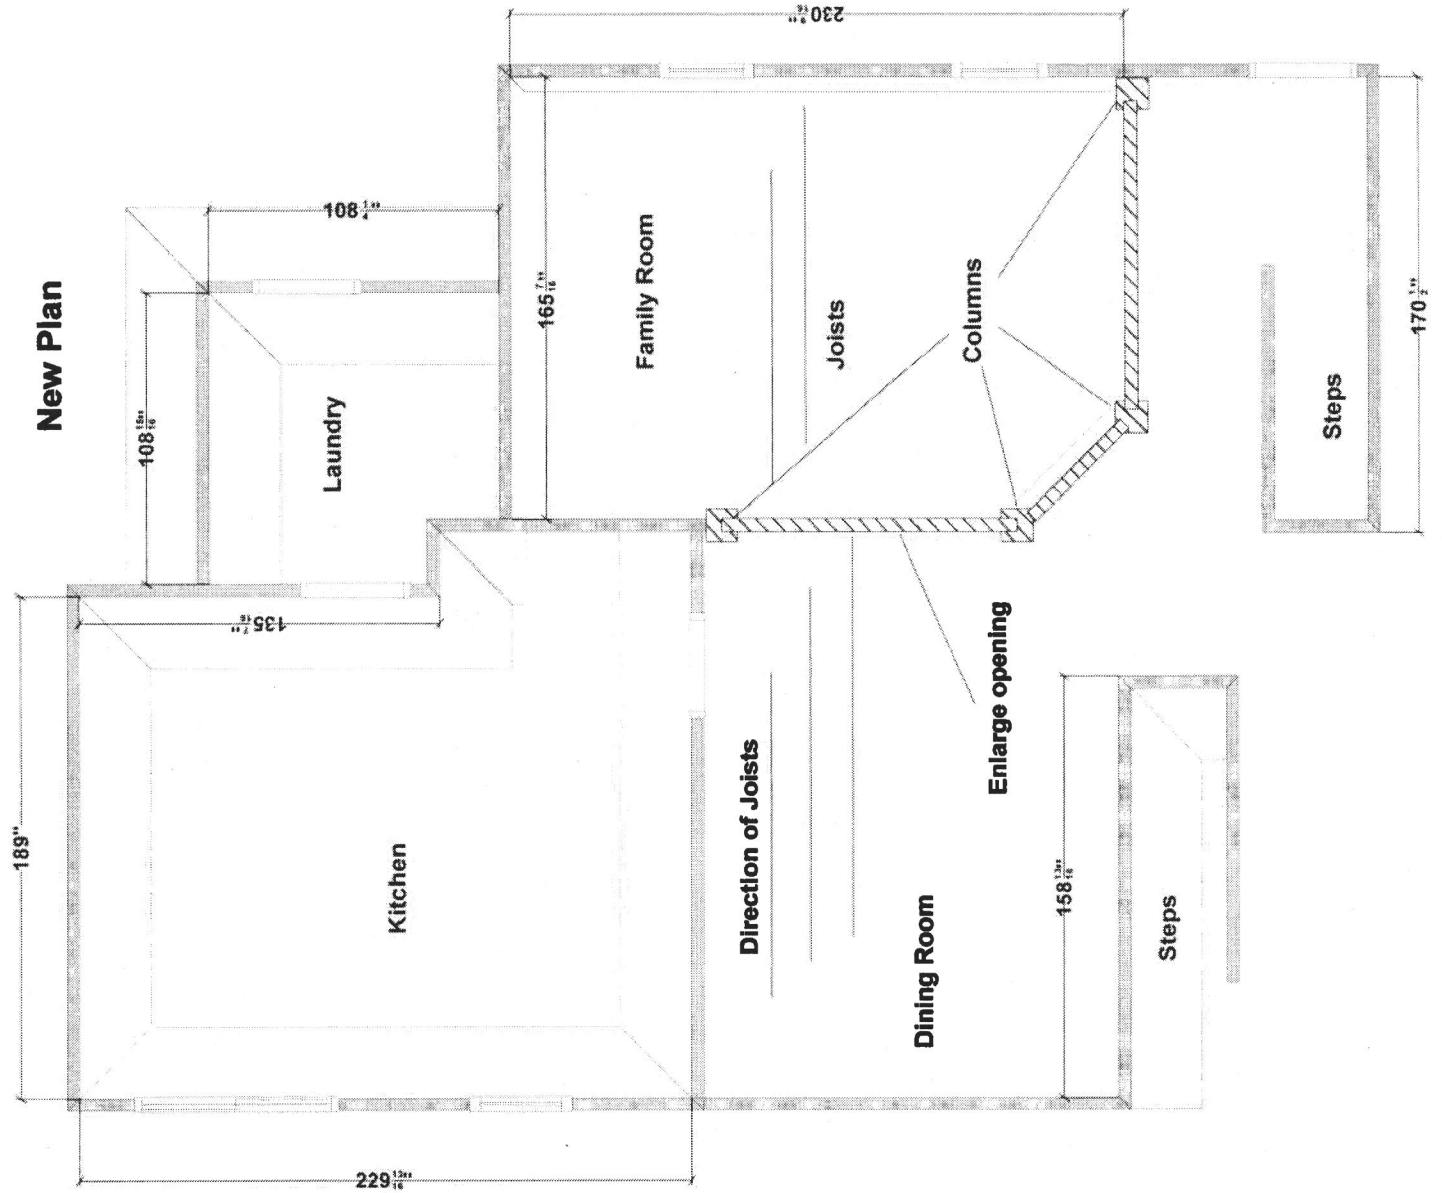

Existing Plan

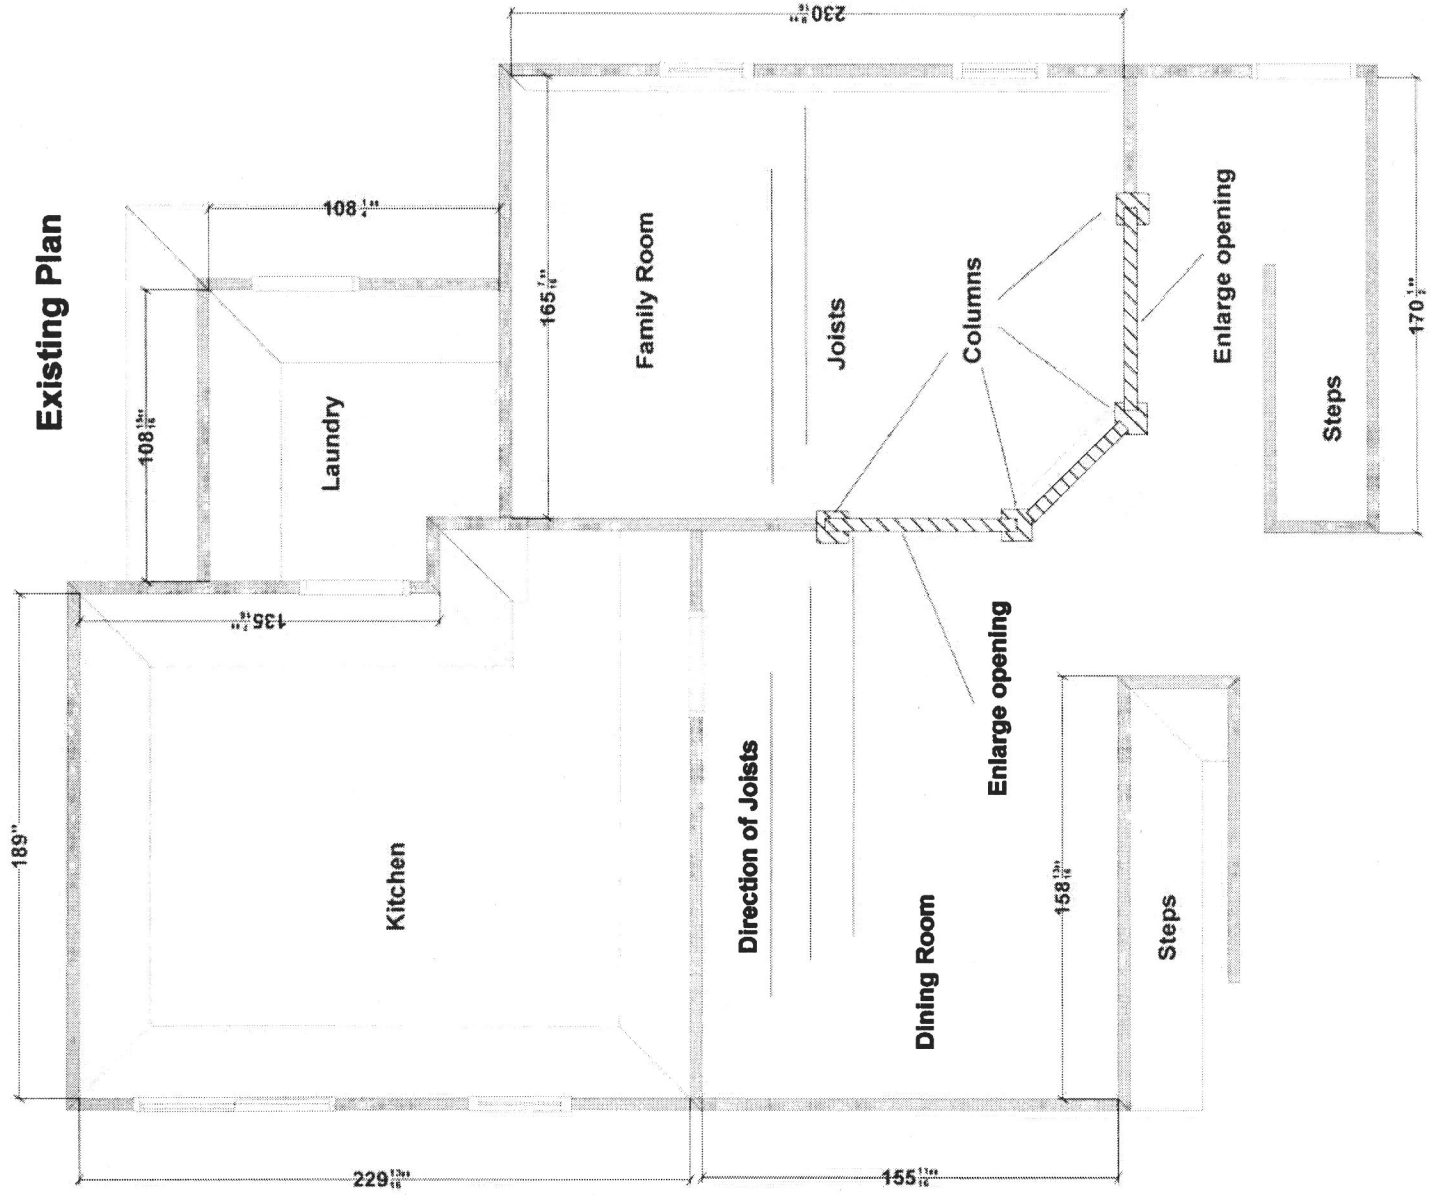

Real Property Data Search

Search Result for HOWARD COUNTY

[View Map](#) [View GroundRent Redemption](#) [View GroundRent Registration](#)

Tax Exempt: None **Special Tax Recapture:** None
Exempt Class: None

Account Identifier: **District - 05 Account Number - 378028**

Owner Information

Owner Name: TAYLOR KURT L **Use:** RESIDENTIAL
 TAYLOR MICHELLE K **Principal Residence:** YES
Mailing Address: 7015 DEER VALLEY RD **Deed Reference:** /16588/ 00441
 HIGHLAND MD 20777-9511

Location & Structure Information

Premises Address: 7015 DEER VALLEY RD **Legal Description:** 2.050 AR S 3
 HIGHLAND 20777-0000 7015 DEER VALLEY RD
 CISSELL FARM

Map:	Grid:	Parcel:	Neighborhood:	Subdivision:	Section:	Block:	Lot:	Assessment Year:	Plat No:
0040	0003	0480	5010102.14	1002				2020	Plat Ref:

Special Tax Areas: None **Town:** None
Ad Valorem: 100
Tax Class: None

Primary Structure Built	Above Grade Living Area	Finished Basement Area	Property Land Area	County Use
1979	1,826 SF		2.0500 AC	

Stories	Basement	Type	Exterior	Quality	Full/Half Bath	Garage	Last Notice of Major Improvements
1	YES	STANDARD UNIT	FRAME/	4	3 full	1 Attached	

Value Information

	Base Value	Value	Phase-in Assessments	
		As of	As of	As of
		01/01/2017	07/01/2019	07/01/2020
Land:	242,000	242,000		
Improvements	261,400	261,400		
Total:	503,400	503,400	503,400	
Preferential Land:	0			

Transfer Information

Seller: TAYLOR KURT L	Date: 12/09/2015	Price: \$0
Type: NON-ARMS LENGTH OTHER	Deed1: /16588/ 00441	Deed2:
Seller: STUPPY MICHAEL J	Date: 06/24/2015	Price: \$525,000
Type: ARMS LENGTH IMPROVED	Deed1: /16285/ 00053	Deed2:
Seller: ARNER JOHN C	Date: 10/30/2009	Price: \$462,400
Type: ARMS LENGTH IMPROVED	Deed1: /12125/ 00171	Deed2:

Exemption Information

Partial Exempt Assessments:	Class	07/01/2019	07/01/2020
County:	000	0.00	
State:	000	0.00	
Municipal:	000	0.00	0.00

Tax Exempt: None **Special Tax Recapture:** None
Exempt Class: None

Homestead Application Information

Homestead Application Status: Approved 12/19/2017

Homeowners' Tax Credit Application Information