


DETAIL: 1" = 30'

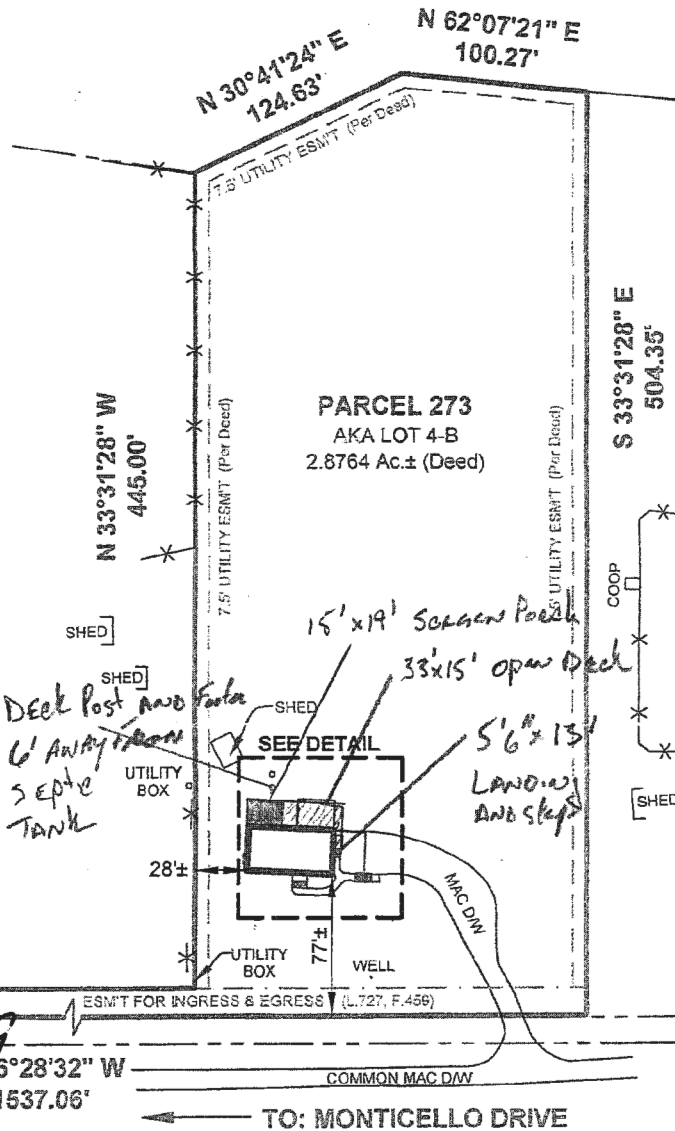

PARCEL 273
AKA LOT 4-B
2.8764 Ac.± (Deed)

Approved Septic System Plan
Howard County Health Department

Online BP
Signature _____ Date *1-20-19*

19084225

LOCATION DRAWING OF:
#14530 MONTICELLO DRIVE
PARCEL 273 TAX MAP 8
AKA LOT 4-B
N/F KELLY G. HARMS
LIBER 17577, FOLIO 236
HOWARD COUNTY, MARYLAND
SCALE: 1"=100' DATE: 10-22-2019
DRAWN BY: CP FILE #: 198733-200

- LEGEND:**
- X- - FENCE
 - B/E - BASEMENT ENTRANCE
 - BAW - BAY WINDOW
 - BR - BRICK
 - BRL - BLDG. RESTRICTION LINE
 - BSMT - BASEMENT
 - C/S - CONCRETE STOOP
 - CONC - CONCRETE
 - D/W - DRIVEWAY
 - EX - EXISTING
 - FR - FRAME
 - MAC - MACADAM
 - G - GATE
 - O/H - OVERHANG
 - PUE - PUBLIC UTILITY ESMT.
 - PIE - PUBLIC IMPROVEMENT ESMT.
- COLOR KEY:**
- (RED) - RECORD INFORMATION
 - (BLUE) - IMPROVEMENTS
 - (GREEN) - ESMTS & RESTRICTION LINES

A Land Surveying Company

DULEY
and
Associates, Inc.

Serving D.C. and MD.

14604 Elm Street, Upper Marlboro, MD 20772

Phone: 301-888-1111 Fax: 301-888-1114
Email: orders@duley.biz On the web: www.duley.biz



SURVEYOR'S CERTIFICATE

I HEREBY STATE THAT I WAS IN RESPONSIBLE CHARGE OVER THE PREPARATION OF THIS DRAWING AND THE SURVEY WORK REFLECTED HEREIN AND IT IS IN COMPLIANCE WITH THE REQUIREMENTS SET FORTH IN REGULATION 12 CHAPTER 09.13.06 OF THE CODE OF MARYLAND ANNOTATED REGULATIONS. THIS SURVEY IS NOT TO BE USED OR RELIED UPON FOR THE ESTABLISHMENT OF FENCES, BUILDING, OR OTHER IMPROVEMENTS. THIS PLAN DOES NOT PROVIDE FOR THE ACCURATE IDENTIFICATION OF PROPERTY BOUNDARY LINES, BUT SUCH IDENTIFICATION MAY NOT BE REQUIRED FOR THE TRANSFER OF TITLE OR SECURING FINANCING OR REFINANCING. THIS PLAN IS OF BENEFIT TO A CONSUMER ONLY INsofar AS IT IS REQUIRED BY A LENDER OR A TITLE INSURANCE COMPANY OR ITS AGENTS IN CONNECTION WITH THE CONTEMPLATED TRANSFER, FINANCING OR REFINANCING. THE LEVEL OF ACCURACY FOR THIS DRAWING IS 1". NO TITLE REPORT WAS FURNISHED TO NOR DONE BY THIS COMPANY. SAID PROPERTY SUBJECT TO ALL NOTES, RESTRICTIONS AND EASEMENTS OF RECORD. BUILDING RESTRICTION LINES AND EASEMENTS MAY NOT BE SHOWN ON THIS SURVEY. IMPROVEMENTS WHICH IN THE SURVEYOR'S OPINION APPEAR TO BE IN A STATE OF DISREPAIR OR MAY BE CONSIDERED "TEMPORARY" MAY NOT BE SHOWN. IF IT APPEARS ENCROACHMENTS MAY EXIST, A BOUNDARY SURVEY IS RECOMMENDED.

DULEY & ASSOC.

WILL GIVE YOU A 100% FULL CREDIT TOWARDS UPGRADING THIS SURVEY TO A "BOUNDARY/STAKE" SURVEY FOR ONE YEAR FROM THE DATE OF THIS SURVEY.

(EXCLUDING D.C. & BALT. CITY)