

Hd

RECEIVED

JUL 07 2020

LICENSES & PERMITS
DIVISION

CK#1214

Modification to Building Permit

Parsley House at 1515 Old Annapolis Road, Woodbine, MD, 21797
Permit number B20000339

After beginning the reconstruction of our house we have decided to finish the basement, attached is the updated plan for the basement.

Work Description: The basement has been partitioned into an unfinished utility/mechanical room for the furnace, air handler, sprinkler tank, hot water heater, water pressure tank, sump pump and sewage macerator/injector pump. We have also partitioned off an unfinished storage room next to the utility room. The main part of the basement in the existing foundation will be finished off to a recreation room with a bathroom, wet bar, and fireplace. The basement addition will be finished off to be a music room for my wife's piano and harp.

Randy Parsley

7.21.2020 . Approved
b.p. revision . -H.O.

CC: P+Z
Heath

Oswald, Hank

From: Oswald, Hank
Sent: Tuesday, July 21, 2020 11:55 AM
To: Wilson Contreras
Subject: RE: B20000339_1515 Old Annapolis Road

Thanks. I will approve the building permit.

Hank

From: Wilson Contreras <wcontreras07@yahoo.com>
Sent: Tuesday, July 21, 2020 11:52 AM
To: Oswald, Hank <hoswald@howardcountymd.gov>
Subject: Re: B20000339_1515 Old Annapolis Road

[Note: This email originated from outside of the organization. Please only click on links or attachments if you know the sender.]

No

Sent from my iPhone

On Jul 21, 2020, at 11:45 AM, Oswald, Hank <hoswald@howardcountymd.gov> wrote:

I'm not sure what you mean. Does the entrance into the music room have a sliding door?

Thanks,

Hank

From: Wilson Contreras <wcontreras07@yahoo.com>
Sent: Tuesday, July 21, 2020 11:34 AM
To: Oswald, Hank <hoswald@howardcountymd.gov>
Subject: Re: B20000339_1515 Old Annapolis Road

[Note: This email originated from outside of the organization. Please only click on links or attachments if you know the sender.]

There is slider doors going out no door from inside into music room is all open basement

Sent from my iPhone

On Jul 21, 2020, at 11:21 AM, Oswald, Hank <hoswald@howardcountymd.gov> wrote:

Mr. Contreras:


Does the "music room" have a door?

Thanks,

Hank

Hank Oswald
Howard County Health Department
Well and Septic Program

11 00 53

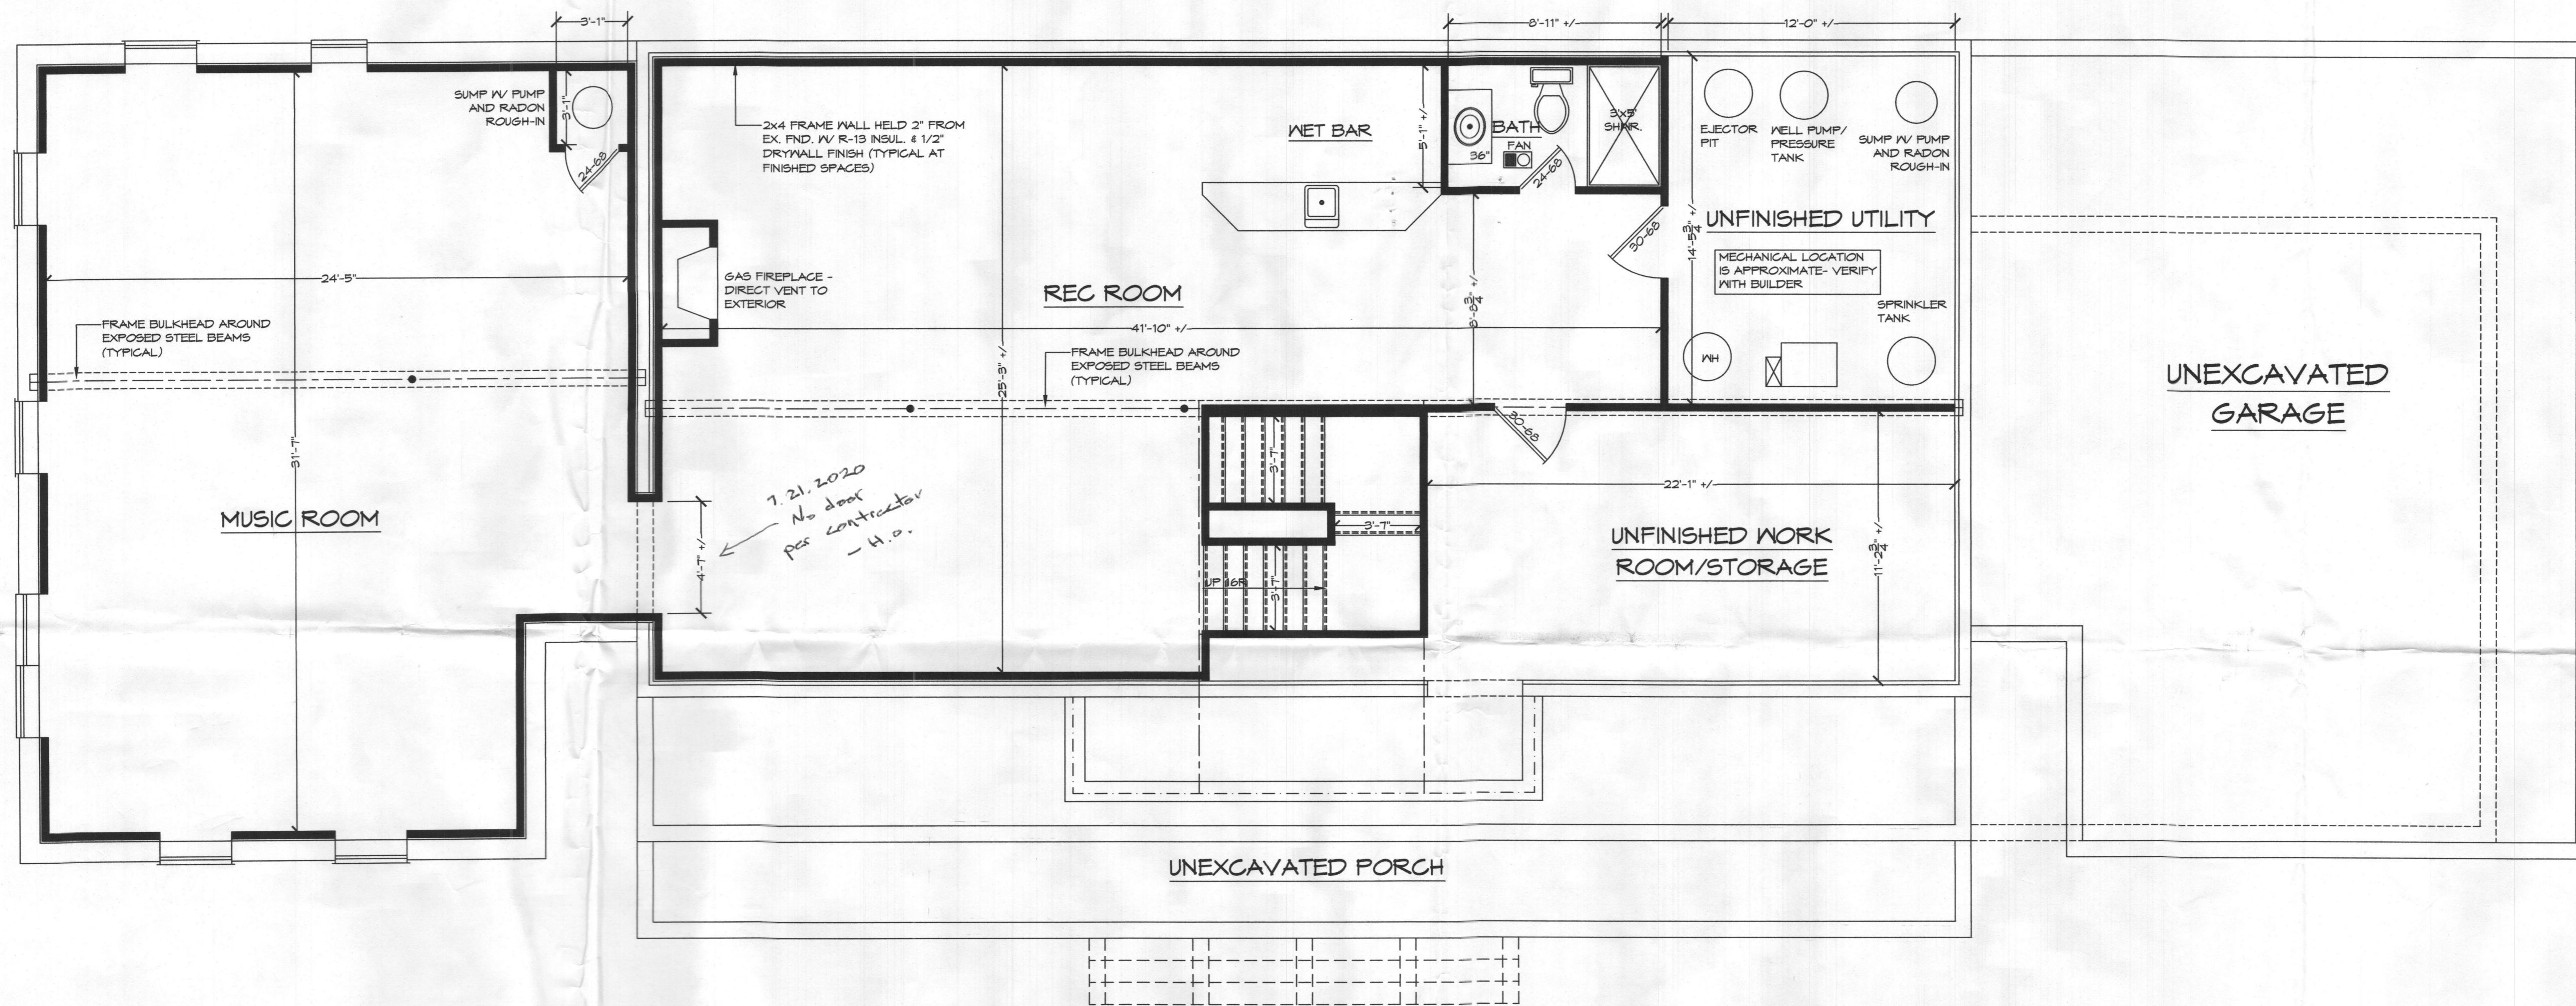

FINISHED BASEMENT PLAN
SCALE: 1/4"=1'-0"

THE PARSLEY RESIDENCE

RECEIVED
JUL 07 2020
LICENSES & PERMITS
DIVISION

REVISED: 6/29/2020
REVISED: 1/24/2020

SCALE: 1/4"=1'-0"
DATE: 12/2019
SHEET NO.: 3 OF 14

GBL CUSTOM HOME
DESIGN INC.
PO BOX 237 FINKSBURG, MD 21048
PHONE 410-833-8320