

PERMIT NUMBER: B 20002181

DATE ACCEPTED:



RESIDENTIAL BUILDING PERMIT APPLICATION

HOWARD COUNTY DEPARTMENT OF INSPECTIONS, LICENSES, AND PERMITS

3430 COURT HOUSE DRIVE, ELLICOTT CITY, MD 21043 - PHONE: (410) 313-2455 OPTION #4

www.howardcountymd.gov

BUILDING SITE ADDRESS REQUIRED

Street Address: 7417 Flame Wood Drive, Unit:
City: Clarksville, State: MD, Zip Code: 21027
Subdivision/Village/Complex Name: SDP/WP/BA #:
Lot: 3, Tax Map: Parcel: Grading Permit #:

DESCRIPTION OF WORK REQUIRED

Existing Use: SF Dwelling, Proposed Use: SF Dwelling, Estimated Cost: \$ 2,120.00
Trade Work to Be Completed (Separate Permits Required): Mechanical (HVACR) Electrical Plumbing None
Install 1-500 gallon capacity storage tank & run line to fuel heater

PROPERTY OWNER INFORMATION REQUIRED

Owner(s) Name(s) (As it appears on tax records): Nick P. ... Primary Residence: Yes
Owner's Street Address: 7417 Flame Wood Drive
City: Clarksville, State: MD, Zip Code: 21027
Phone: 571-237-9274, Email:

APPLICANT NAME REQUIRED - INDIVIDUAL WHO SIGNS THIS APPLICATION

Business Name: Thompson Inc, Contact Name: Anthony D. ...
Street Address: 1600 Spruce Point
City: Baltimore, State: MD, Zip Code: 21217
Phone: 443-876-0506, Email: A.D...@ThompsonInc.com

CONTRACTOR INFORMATION REQUIRED

Business Name: Thompson Inc
Licensee's Name: R. ... License #: 60043
Street Address: 5260 W. ... #300
City: ... State: MD, Zip Code: 21703
Phone: Email: A. ...@ThompsonInc.com

ARCHITECT/ENGINEER INFORMATION INDIVIDUAL WHO SIGNED PLANS, IF APPLICABLE

Business Name: Name:
Street Address:
City: State: Zip Code:
Phone: Email:
RECEIVED JUL 06 2020 LICENSES & PERMITS

BUILDING CHARACTERISTICS REQUIRED

Primary Structure: SF Dwelling SF Townhouse SF Duplex Mobile Home Multi-Family Dwelling (MF*) Condo: Yes No
Utilities: Electric Gas Water Supply: Public Private (Well) Sewage Disposal: Public Private (Septic)
Heating System: Electric Natural Gas Propane Other: Roadside Tree Project: No Yes: #
Sprinkler System: NFPA 13 NFPA 13R NFPA 13D None Fire Alarm System: Yes No Voice Evac

ADDITIONAL RESIDENTIAL INFORMATION (PLEASE SELECT/COMPLETE ALL THAT APPLY)

Model Name & Options:
of Bedrooms (SF): # of efficiency units (MF*): # of 1 BR (MF*): # of 2 BR (MF*): # of 3 BR (MF*):
Rooms: # Full Baths: # Half Baths: # Fireplaces:
Garage/Carport Info: Attached Garage Detached Garage Integral Garage Carport None
Basement/Foundation Info: Slab on Grade Post & Pier Unfinished Basement Finished Basement: Full or Partial
1st Fl Width: 1st Fl Depth: 2nd Fl Width: 2nd Fl Depth: Bsmt Width: Bsmt Depth:
Energy Method: Prescriptive Performance UA Alternative ERI Gross Area: sq ft Occupiable Area: sq ft

AGREEMENT/ DISCALIMER REQUIRED

THE UNDERSIGNED HEREBY CERTIFIES AND AGREES AS FOLLOWS: (1) THAT HE/SHE IS AUTHORIZED TO MAKE THIS APPLICATION; (2) THAT THE INFORMATION IS CORRECT; (3) THAT HE/SHE WILL COMPLY WITH ALL REGULATIONS OF HOWARD COUNTY WHICH ARE APPLICABLE THERETO; (4) THAT HE/SHE WILL PERFORM NO WORK ON THE ABOVE REFERENCED PROPERTY NOT SPECIFICALLY DESCRIBED IN THIS APPLICATION; (5) THAT HE/SHE GRANTS COUNTY OFFICIALS THE RIGHT TO ENTER ONTO THIS PROPERTY FOR THE PURPOSE OF INSPECTING THE WORK PERMITTED AND POSTING NOTICES.

APPLICANT'S ORIGINAL SIGNATURE DATE SIGNED

FOR OFFICE USE ONLY

CHECKS PAYABLE TO: DIRECTOR OF FINANCE OF HOWARD COUNTY


AGENCIES REQUIRED/APPROVALS: PR DPZ DED Health 7/23/20 SHA CID
SUBMITTAL FEES: \$110.00 PAYMENT: CK # 060032074 ACCEPTED BY: DRAPPAS

50:1

7/23/20 - Spoke to Homeowner
he stated that the LP
location is 50 to 60' away
from the septic tank
closer to the lot line

Approved for LP Tank

B 20002181
7/23/20 RJA

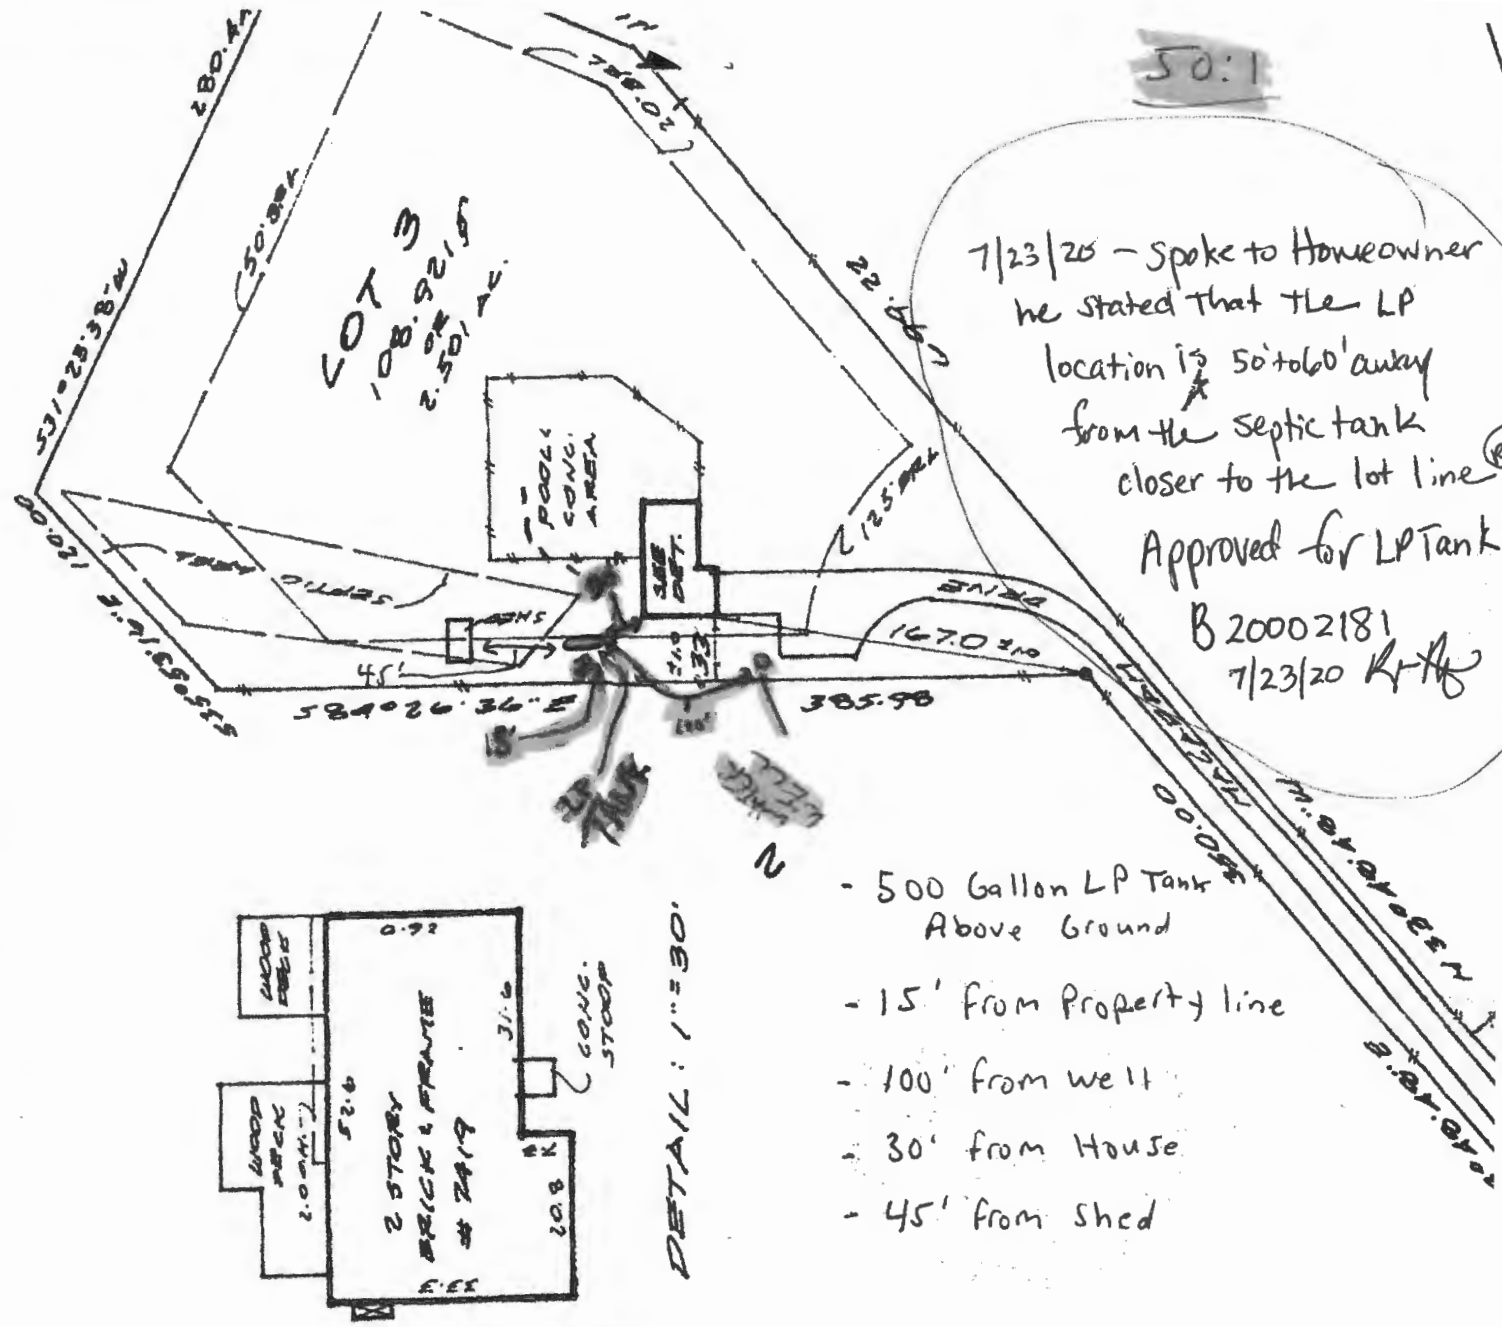

Unable to verify location of fences due to vegetation.

No evidence of property corners was found. Apparent occupation is shown.

FLAMEWOOD DRIVE

Date: 11-06-01 Scale: 1" = 100' Dm: B.O.

Plat Book: ---

Plat No.: 3822 NO TITLE REPORT FURNISHED

Work Order: 01-4897

Address: 7419 FLAMEWOOD DRIVE

District: 5

Jurisdiction: HOWARD COUNTY, MD

Surveyor's Certification

I hereby certify that the survey shown hereon is correct knowledge and that, unless noted otherwise, it has been described of record. This survey is not a boundary survey. The existence of property corners is neither guaranteed nor if shown, are approximate in location. This property does not lie in a year flood plain according to FEMA insurance maps. Building rest as per available information and are subject to the originator.

LOCATION DRAWING
LOT 3 BLOCK B
FLAMEWOOD
SECTION 3
AREA 1

Stephen J. Heath

NOTE: This plat is of benefit to a consumer only insofar as it is required by a