



# APPLICATION

## FOR PERCOLATION TESTING AND SITE EVALUATION

TEST DATE(S) \_\_\_\_\_ TEST TIME \_\_\_\_\_

AP 555334

AGENCY REVIEW: \_\_\_\_\_

DATE 11-25-14

DO NOT WRITE ABOVE THIS LINE

I HEREBY APPLY FOR THE NECESSARY TESTING/EVALUATION PRIOR TO ISSUANCE OF SEWAGE DISPOSAL SYSTEM PERMIT(S) TO:

CHECK AS NEEDED:

- CONSTRUCT NEW SEPTIC SYSTEM(S)
- REPAIR/ADD TO AN EXISTING SEPTIC SYSTEM
- REPLACE AN EXISTING SEPTIC SYSTEM

CHECK AS NEEDED:

- NEW STRUCTURE(S)
- ADDITION TO AN EXISTING STRUCTURE
- REPLACE AN EXISTING STRUCTURE

CHECK ONE:

- CREATE NEW LOT(S)
- BUILD ON AN EXISTING LOT IN A SUBDIVISION
- BUILD ON AN EXISTING PARCEL OF RECORD

IS THE PROPERTY WITHIN 2500' OF ANY RESERVOIR?

- YES
- NO

THE TYPE OF STRUCTURE IS:

- RESIDENTIAL WITH \_\_\_\_\_ PROPOSED BEDROOMS IN THE COMPLETED STRUCTURE (NOTE **UNKNOWN** IF APPROPRIATE)
- COMMERCIAL (PROVIDE DETAIL OF NUMBERS AND TYPES OF EMPLOYEES/ CUSTOMERS ON ACCOMPANYING PLAN)
- INSTITUTIONAL/GOVERNMENT (PROVIDE DETAIL OF NUMBERS AND TYPES OF EMPLOYEES/USERS ON ACCOMPANYING PLAN)

PROPERTY OWNER(S) Bach Van Vu

DAYTIME PHONE \_\_\_\_\_ CELL 301-651-3036

FAX VANMAR 301-831-5603

MAILING ADDRESS 20316 Seabrook Drive, Montgomery Village

MD 20886  
STATE ZIP

APPLICANT Debbie Vansant - Vanmar Assoc. Inc

DAYTIME PHONE 910 514 2751 CELL \_\_\_\_\_

FAX 301 831 5603

MAILING ADDRESS 310 S. Main St. MTAirg

MD 21771  
STATE ZIP

APPLICANT'S ROLE: DEVELOPER BUILDER BUYER RELATIVE/FRIEND REALTOR CONSULTANT

PROPERTY LOCATION

SUBDIVISION/PROPERTY NAME \_\_\_\_\_ LOT NO. \_\_\_\_\_

PROPERTY ADDRESS 1615 Old Annapolis Rd

STREET TOWN/POST OFFICE

TAX MAP PAGE(S) 7 GRID 14 PARCEL(S) 353 PROPOSED LOT SIZE \_\_\_\_\_

AS APPLICANT, I UNDERSTAND THE FOLLOWING: THE SYSTEM INSTALLED SUBSEQUENT TO THIS APPLICATION IS ACCEPTABLE ONLY UNTIL PUBLIC SEWERAGE IS AVAILABLE. THIS APPLICATION IS COMPLETE WHEN ALL APPLICABLE FEES AND A SUITABLE SITE PLAN HAVE BEEN RECEIVED. I ACCEPT THE RESPONSIBILITY FOR COMPLIANCE WITH ALL M.O.S.H.A. AND "MISS UTILITY" REQUIREMENTS. APPROVAL IS BASED UPON SATISFACTORY REVIEW OF A PERC CERTIFICATION PLAN.

TEST RESULTS WILL BE MAILED TO APPLICANT.

*Deborah Vansant*  
SIGNATURE OF APPLICANT

SIGNATURE OF APPLICANT

HOWARD COUNTY HEALTH DEPARTMENT, BUREAU OF ENVIRONMENTAL HEALTH, WELL AND SEPTIC PROGRAM  
7178 COLUMBIA GATEWAY DRIVE COLUMBIA, MARYLAND 21046 (410) 313-2640 FAX (410) 313-2648  
TDD (410) 313-2323 TOLL FREE 1-877-4MD-DHMH

AP \_\_\_\_\_

**1A**

6" brn l

3.5' red brn chscl

6' yellow brn sl saprolite Hsbk

9' ylw-red fsl saprolite ~10% rx

12' pink ch fsl

**1B**

8" brn l

4.5' red brn chscl - 2esbk

5' yellow sl saprolite

7' yellow fsl saprolite 20% rx

10' ylw-red ch fsl saprolite

12' **1D**

1' brn l


4' org brn scl icsbk

6' yellow sl saprolite

9.5' yellow fsl saprolite

13' white-ylw v fsl saprolite

beige ls

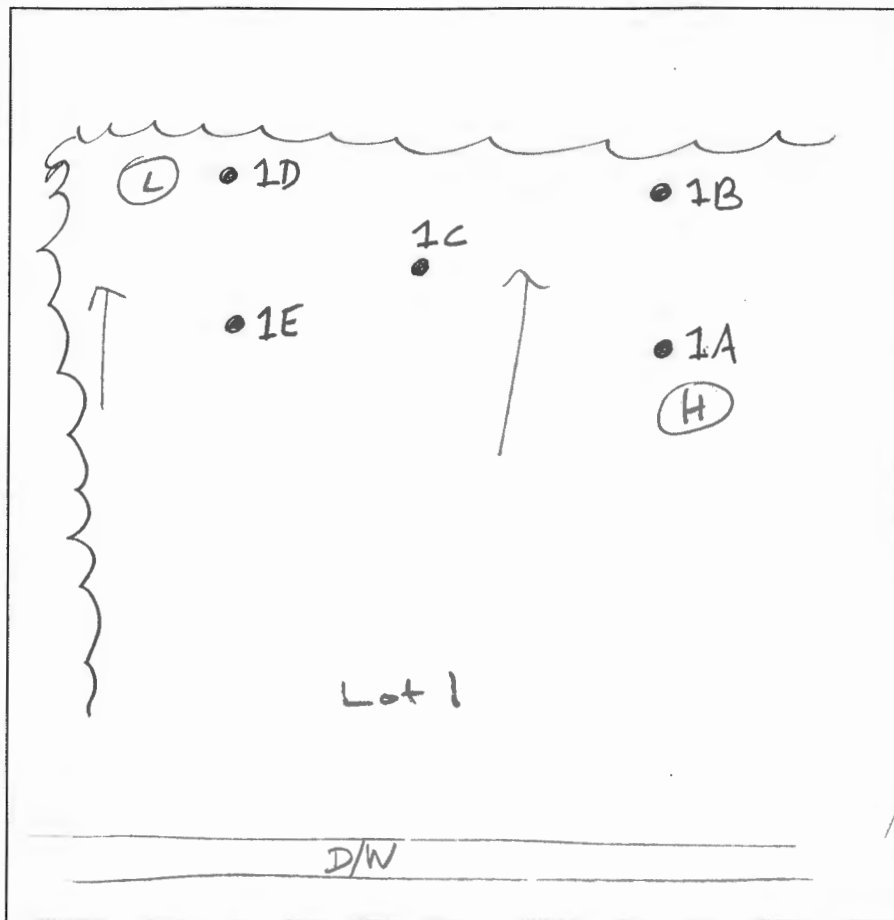

NOT TO SCALE

DATE	TEST #	DEPTH	START	BREAK 1" DROP	STOP 2" DROP	TIME OF 2ND INCH	P/F/H
3/20/13	1A	4'9" / 12'	9:51	10:01	10:15	14	P
	1B	4.5' / 12'	10:06	10:17	10:35	18	P
	1D	5' / 13'	10:21	10:25	10:31	6	P
	1E	4' / 12.5'	10:35	10:37 <sup>35</sup>	10:42	5	P
	1C	11.5'	VISUAL				P

**1E**

brn l 6"

org brn scl lmsbk 3.5'-4'

org brn sl saprolite 6.5-7'

yellow fsl saprolite 15% rx 9'

yellow/org ch fsl 12.5'

**1C**

brn l sbk 1'

red brn scl lmsbk 4'

yellow sl saprolite 6.5'

ylw-red fsl saprolite 10-15% rx

yellow sl 11.5'

REMARKS holes dug per plan / holes similar Lot 2

SANITARIAN HS BACKHOE Level Land OTHERS \_\_\_\_\_

TEST HOLES USED IN SDA 5 AVG. PERC TIME 10 SQ. FT/BR \_\_\_\_\_

TRENCH WIDTH 3 INLET DEPTH 4 MAX. BOT DEPTH 6'-7' EFFECTIVE SW 1.5'