

PERMIT NUMBER: B 21000453

DATE ACCEPTED:

REVISED 2/23/21



RESIDENTIAL BUILDING PERMIT APPLICATION

HOWARD COUNTY DEPARTMENT OF INSPECTIONS, LICENSES, AND PERMITS
3430 COURT HOUSE DRIVE, ELLICOTT CITY, MD 21043 - PHONE: (410) 313-2455 OPTION #4
www.howardcountymd.gov

BUILDING SITE ADDRESS REQUIRED

Street Address: 6501 HEATHER GLEN WAY
City: CLARKSVILLE
State: MD
Zip Code: 21029
Subdivision/Village/Complex Name:
Lot:
Tax Map: 34
Parcel: 444
Grading Permit #: GP-21-089

DESCRIPTION OF WORK REQUIRED

Existing Use: RESIDENTIAL
Proposed Use: RESIDENTIAL
Estimated Cost: \$450,000.00
Trade Work to Be Completed (Separate Permits Required): Mechanical (HVACR) Electrical Plumbing None
GARAGE ADDITION - 673 S.F.
HOME OFFICE ADDITION - 1,367 S.F.
GALLERY MUSEUM SPACE. 2,164 S.F.

PROPERTY OWNER INFORMATION REQUIRED

Owner(s) Name(s) (As it appears on tax records): SHERMAN & DEDRA CARWAPP
Primary Residence: Yes
Owner's Street Address: 6501 HEATHER GLEN WAY
City: CLARKSVILLE
State: MD
Zip Code: 21029
Phone:
Email: SCARWAPP3@GMAIL.COM

APPLICANT NAME REQUIRED - INDIVIDUAL WHO SIGNS THIS APPLICATION

Business Name: PENNEY DESIGN GROUP
Contact Name: RUI A PONTE, AIA
Street Address: 8120 WOODMONT AVE SUITE 750
City: BETHESDA
State: MD
Zip Code: 20814
Phone: 240-417-7666
Email: RPONTE@PENNEYDESIGNGROUP.COM

CONTRACTOR INFORMATION REQUIRED

Business Name: ESTORIL CONSTRUCTION DBA ENDEAVOR CUSTOM BUILDERS
Licensee's Name: JEAN ASSUNCAO
License #: MHIC 132029
Street Address: 5116 WESSLING LANE
City: BETHESDA
State: MD
Zip Code: 20814
Phone: 240-417-7665
Email: J.ASSUNCAO@ECB-GROUP.COM

ARCHITECT/ENGINEER INFORMATION INDIVIDUAL WHO SIGNED PLANS, IF APPLICABLE

Business Name: PENNEY DESIGN GROUP
Name: RUI A PONTE AIA
Street Address: 8120 WOODMONT AVE
City: BETHESDA
State: MD
Zip Code: 20814
Phone: 240-417-7666
Email: R.PONTE@PENNEYDESIGNGROUP.COM

BUILDING CHARACTERISTICS REQUIRED

Primary Structure: SF Dwelling
Utilities: Electric Gas Water Supply: Public Private (Well) Sewage Disposal: Public Private (Septic)
Heating System: Electric Natural Gas Propane Other: Roadside Tree Project: No
Sprinkler System: NFPA 13 NFPA 13R NFPA 13D None Fire Alarm System: Yes No Voice Evac

ADDITIONAL RESIDENTIAL INFORMATION (PLEASE SELECT/COMPLETE ALL THAT APPLY)

Model Name & Options:
of Bedrooms (SF):
of efficiency units (MF*):
of 1 BR (MF*):
of 2 BR (MF*):
of 3 BR (MF*):
Rooms:
Full Baths:
Half Baths:
Fireplaces:
Garage/Carport Info: Attached Garage Detached Garage Integral Garage Carport None
Basement/Foundation Info: Slab on Grade Post & Pier Unfinished Basement Finished Basement Full or Partial
1st Fl Width: 1st Fl Depth: 2nd Fl Width: 2nd Fl Depth: Bsmt Width: Bsmt Depth:
Energy Method: Prescriptive Performance UA Alternative ERI Gross Area: sq ft Occupiable Area: sq ft

AGREEMENT/ DISCALIMER REQUIRED

THE UNDERSIGNED HEREBY CERTIFIES AND AGREES AS FOLLOWS: (1) THAT HE/SHE IS AUTHORIZED TO MAKE THIS APPLICATION; (2) THAT THE INFORMATION IS CORRECT; (3) THAT HE/SHE WILL COMPLY WITH ALL REGULATIONS OF HOWARD COUNTY WHICH ARE APPLICABLE THERETO; (4) THAT HE/SHE WILL PERFORM NO WORK ON THE ABOVE REFERENCED PROPERTY NOT SPECIFICALLY DESCRIBED IN THIS APPLICATION; (5) THAT HE/SHE GRANTS COUNTY OFFICIALS THE RIGHT TO ENTER ONTO THIS PROPERTY FOR THE PURPOSE OF INSPECTING THE WORK PERMITTED AND POSTING NOTICES

APPLICANT'S ORIGINAL SIGNATURE: [Signature] DATE SIGNED: Feb 22 2021

FOR OFFICE USE ONLY

CHECKS PAYABLE TO: DIRECTOR OF FINANCE OF HOWARD COUNTY

AGENCIES REQUIRED/APPROVALS:
PR DPZ DED Health 3/16/21 SHA CID

SUBMITTAL FEES: \$25.00 PAYMENT: NONE SUB. ACCEPTED BY: [Signature]

**COMPLETE THIS FORM WHEN DROPPING OFF ANY
CORRESPONDENCE AND/OR PLANS TO THE HOWARD COUNTY
DEPARTMENT OF INSPECTIONS, LICENSES AND PERMITS COUNTER:**

RECEIVED

Date: February 23, 2021 FEB 23 2021

To: INcomplete PLAN REVIEW DIVISION

From: RUI A. POOTE, PERNEY DESIGN GROUP 240-417-7666
(Your Name, Company Name) (Phone Number)

Subject: Project name CANAPP RESIDENCE
Project site address 6501 HEATHER GLEN WAY
Permit # B 21000 453 SDP # GP-21-084
Other information pertinent to this project ATTACHED

✓ Please check the attachments below that you are submitting with this transmittal:

- Letter of response to address plan review comment letter
- Revised plans and/or revised details: When submitting for a complete re-review, duplicate sets shall be submitted.
- Letter Summarizing Changes
- Energy conservation calculations
- Copies of 1 (be specific).
- Health Department Request DPZ/ DED Request Applicant's Request
- Two sets of single-family model plans to be placed on permanent file: Model Name/ # _____
- Other _____

Contact Person Information: (Required)

RUI A. POOTE
Please Print Name

Telephone No: 240-417-7666

E-Mail Address: RPOOTE@PERNEYDESIGNGROUP.COM

PLEASE ASSURE ALL DOCUMENTS AND/OR REVISIONS ARE APPROPRIATELY SIGNED AND SEALED, IF NECESSARY, BY A LICENSED ARCHITECT OR ENGINEER. PLEASE BE ADVISED THAT INSUFFICIENT INFORMATION MAY RESULT IN THE DELAY OF REVIEW BY THE PLANS EXAMINER. THE DEPARTMENT OF INSPECTIONS, LICENSES AND PERMITS WILL CONTACT YOU IF THERE IS A PROBLEM. IN ADDITION, ONCE THE BUILDING PERMIT IS APPROVED BY THE PLAN REVIEW DIVISION AND ALL OTHER REQUIRED SIGNATORY AGENCIES, AND THE BUILDING PERMIT IS READY FOR ISSUANCE, THE PERMIT DIVISION WILL NOTIFY THE APPROPRIATE CONTACT PERSON FOR PERMIT PICK UP. ALL PERMIT STATUS INQUIRIES SHALL BE DIRECTED TO THE PERMIT DIVISION AT 410-313-2455 OPTION #4 OR BY VISITING MYHOWARD.INFO. CODE RELATED QUESTIONS AND PLAN REVIEW INQUIRIES SHALL BE DIRECTED TO THE PLAN REVIEW DIVISION AT 410-313-2436. PLEASE ALLOW A MINIMUM OF FIVE (5) WORKING DAYS FOR ANY PLAN SUBMITTALS TO BE REVIEWED. THANK YOU.

Received by DROPBOX

From: "Anest, Cathy" <canest@howardcountymd.gov>
Date: February 19, 2021 at 4:39:34 PM EST
To: Rui <ruiaponte@gmail.com>
Subject: RE: Canapp Residence - 6501 Heather Glen Way - B21000453

Good afternoon,

This is also in response to your voicemail that you left earlier. A few things that are required prior to acceptance of the application for the referenced address:

1. A third set of drawings that will need to go to the Health Department for their review and approval.
Delivered with this package, please forward
2. The application was incomplete:
 - a. The description of work will need the dimension of the proposed garage
The proposed daily driver garage space is approx.. 26 x 27 ft - square footage total of 673 sf. This space is for the owner's daily/regular use cars.
The lower level auto "museum" gallery space is approx.. 80 x 32 ft - square footage total of 2,664 sf. The space will be used for the display of Owner's race car collection and other art automotive memorabilia.
The upper level office space of 35 x 32 ft- square footage total of 1,367 sf will be used by owner's as a home office for their veterinary telemedicine and video conferencing use in support of their veterinary education practice.
There is also a small hobby workshop in the lower level of approx. 567 sf.
 - b. The bottom of the application was cut off and was not signed. Please see attached blank copy that should be included with the rest of the items.
New application attached
3. Please indicate whether any roadside trees will be removed on the application.
No Roadside trees are being removed, some of Owner's screening plantings will be relocated during construction and replanted when work is complete
4. A plot plan or location survey dimensioning the proposed garage and showing distance to property lines is required.

A copy of the approved grading plan showing all new work is within the setback is attached
All of this information can be dropped off in our DILP Drop Off Bin in the lobby of the Howard Building.
Please include the building permit number that is referenced in the subject line. This information should have been emailed to the applicant when it was made incomplete.

Feel free to contact a permit technician at buildingtech@howardcountymd.gov with any questions.
Thank you.



Cathy H. Anest, Chief
Licenses and Permits Division

SOILS LEGEND			
SYMBOL	NAME / DESCRIPTION	% FACTOR	SOIL GROUP
(Symbol)	Soil	0.25	
(Symbol)	Soil	0.15	

LEGEND	
(Symbol)	Prop. 10' Contour Line
(Symbol)	Prop. 1' Contour Line
(Symbol)	Prop. Spot Elevation
(Symbol)	Prop. 10' Contour Line
(Symbol)	Prop. 2' Contour Line
(Symbol)	Prop. Spot Elevation
(Symbol)	Soil Line
(Symbol)	Drainage Area to Micro-Biorestation
(Symbol)	DA to SSM Micro-Biorestation
(Symbol)	5th Fence
(Symbol)	Smart Fence
(Symbol)	Scenic Construction Entrance (SCE)

GENERAL NOTES

1. Site Data Property Address: 6001 Heather Glen Way, Howard County, Maryland 21077. Deed: 13071786. Tax Map 34, Grid 17; Parcel 444, 5th Election District. Area = 3.578 ac.; Lot 7 of Plots 21678 & 22970.
2. The subject property is zoned SR-DCO.
3. Private water and sewer exists on the site.
4. There are no floodplains, wetlands, streams, wetland/stream buffers, historic structures or cemeteries on-site.
5. This property is subject to the Amended 5th edition of the Howard County Subdivision and Land Development Regulations.
6. Field run topographic survey prepared by FSH Associates in June, 2020.
7. Per FEMA (FIRM Map) 24027C01300 no FEMA delineated floodplain exists within the project area.
8. Boundary based on plot #21628, Lot 7.
9. Approval of this Simplified ECP plan does not constitute approval of subsequent grading or building permits, site reduction or forest conservation plans. The applicant and consultant should expect additional comments as the development plan progresses through the plan review and/or permit application process.
10. Forest Conservation requirements were previously addressed under F-10-108 (Plot #21628).

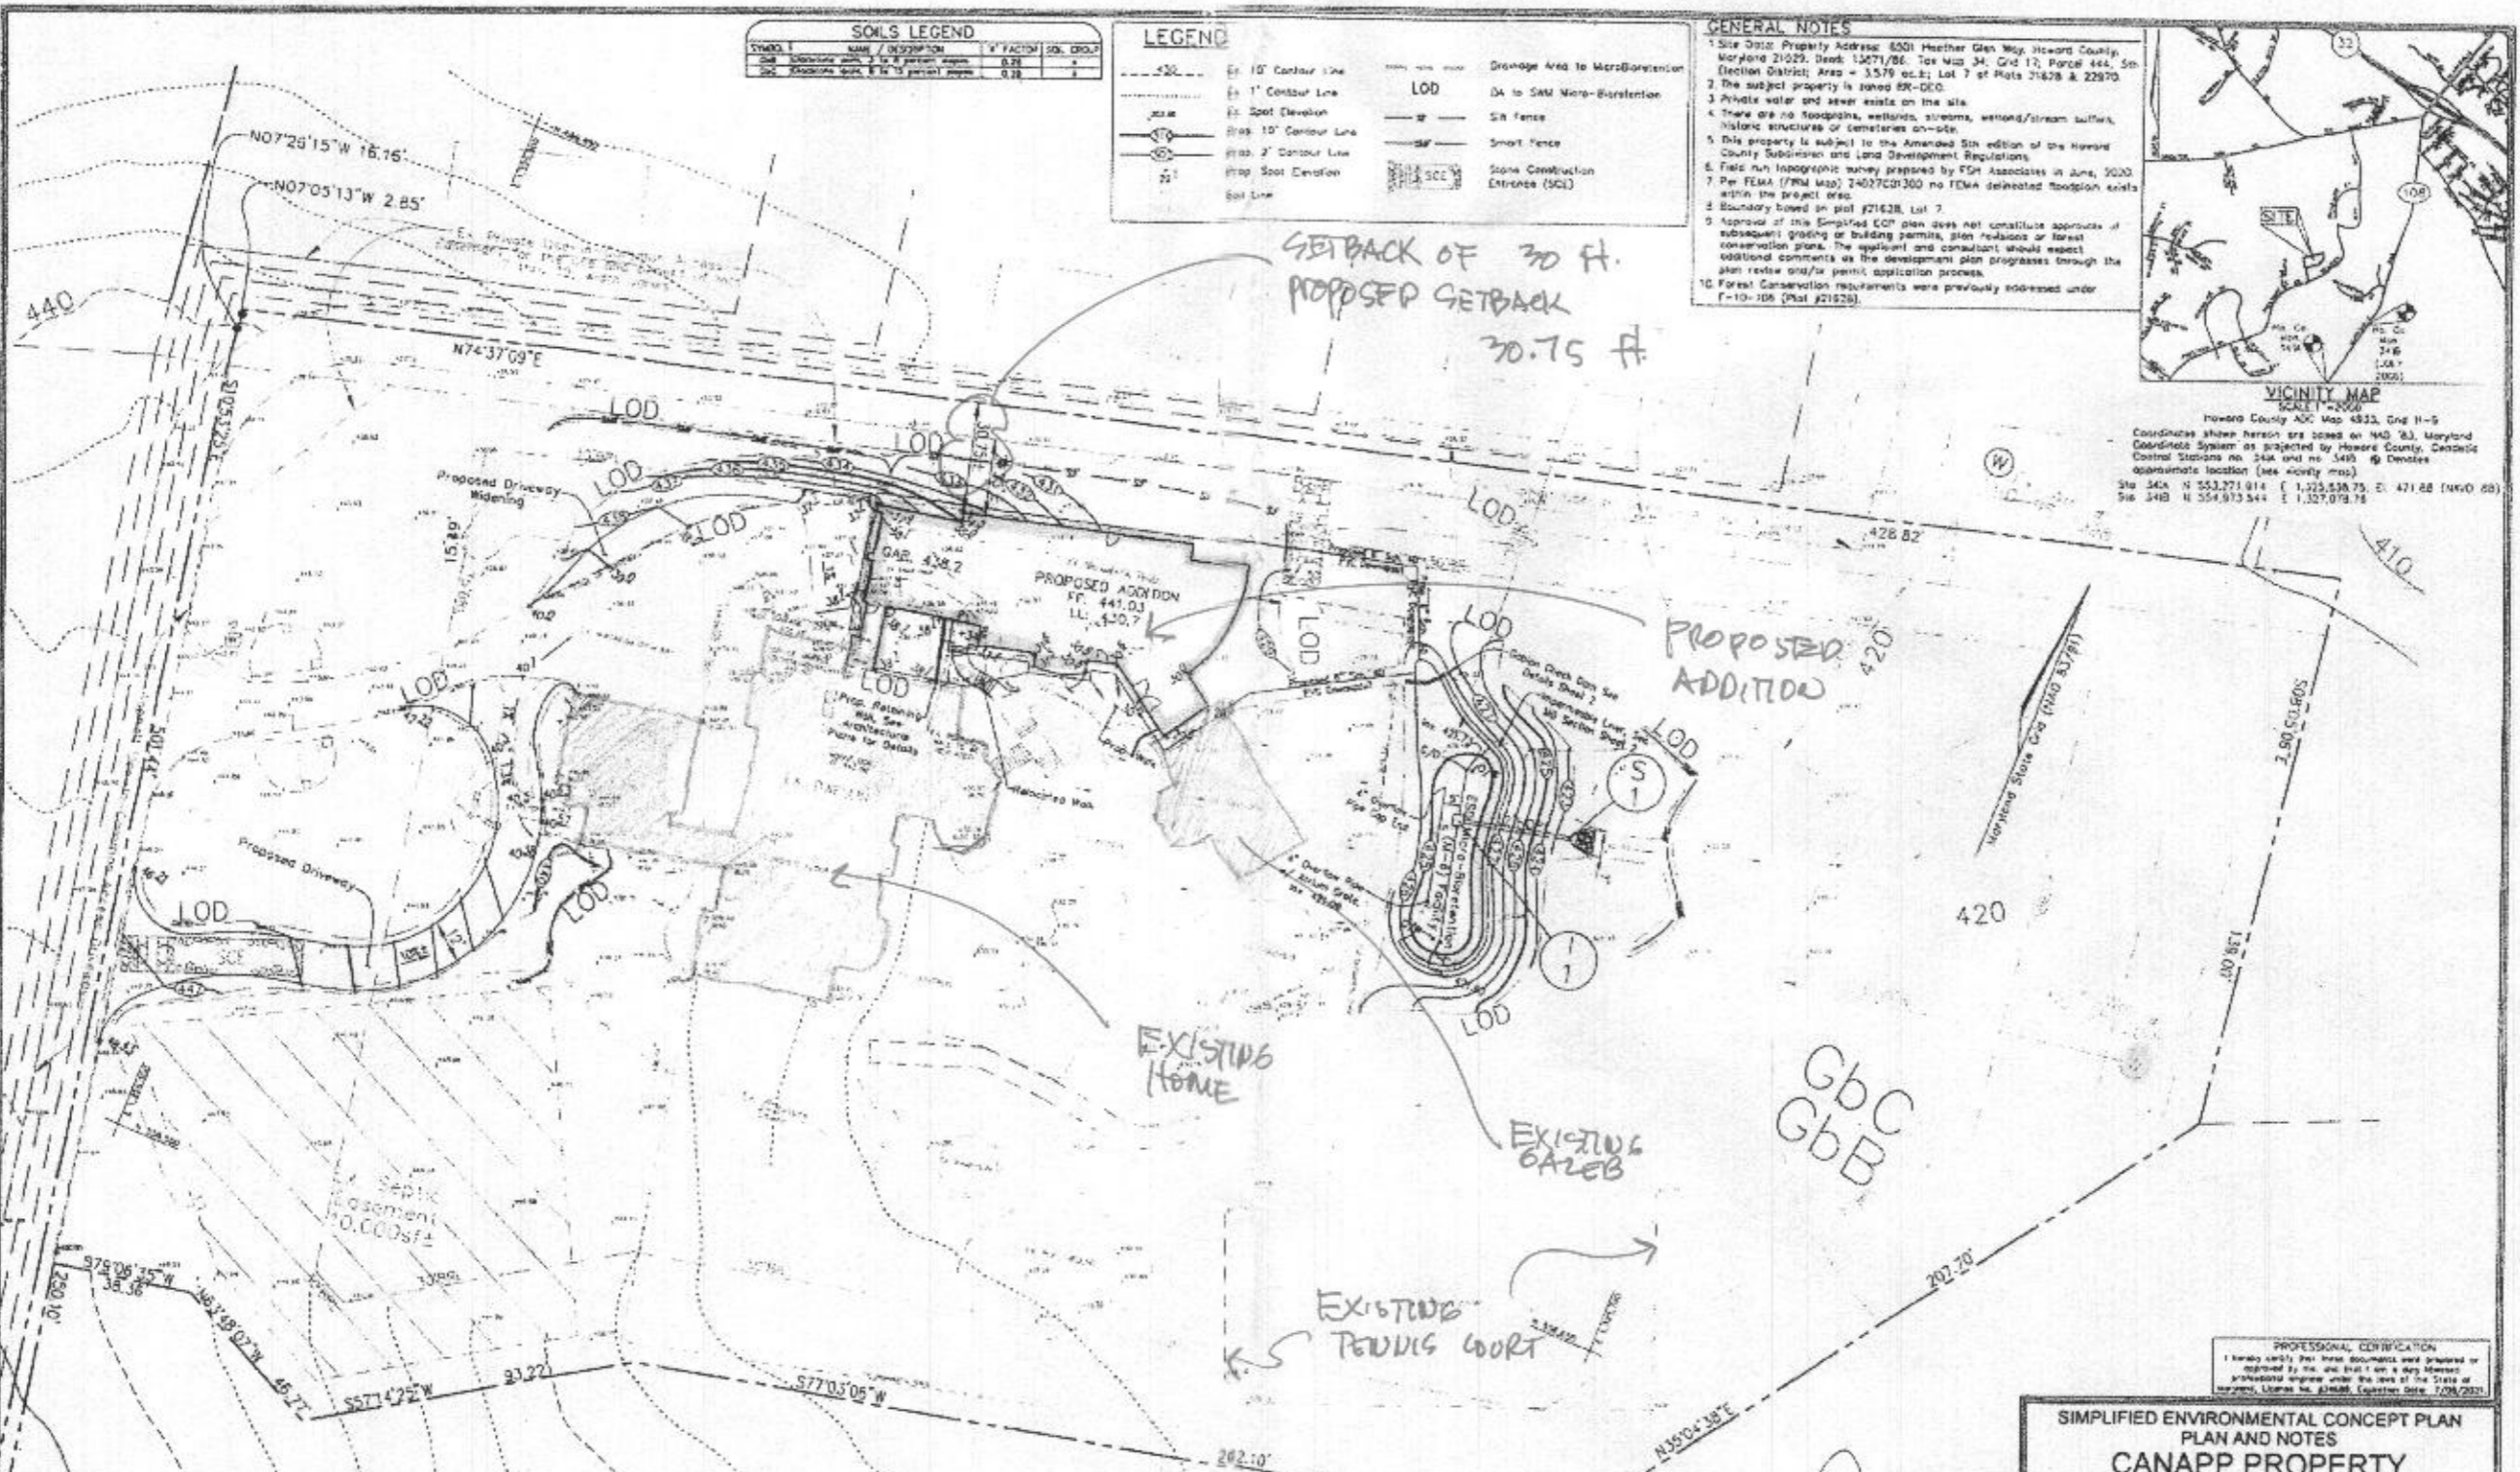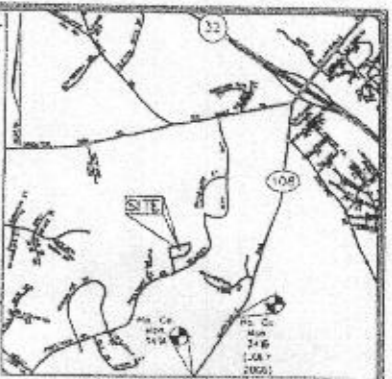

SITE ANALYSIS DATA

1. Total area of site (LOD) = 0.44 ac.s
2. No wetlands, wetland buffers or streams exist on site.
3. No 100-year floodplain exists on site.
4. No forest area on site.
5. No areas of 15-24.9% slope exist on site.
6. No 25% slopes or greater exist on site.
7. Limits of disturbance = 0.44 ac.s
8. Proposed impervious area = 0.18 ac.s
9. Gradiable soils (K > 0.35) = 0
10. Proposed site use: Residential

GRADING PLAN-PHASE 1
Scale: 1" = 20'
Note: See Sheet 2 for Phase 2 Grading Plan.

DESIGN NARRATIVE:

1. The project area (LOD) contains no natural resources.
2. All existing tree patterns were maintained.
3. The proposed project area (LOD) consists of 19,291 sq.ft.
4. Minimal erosion and sediment control measures are required for this project. Erosion and sediment control will be achieved through the use of S.F., S.N.F. and two Simplified Construction Entrances.
5. Stormwater management has been achieved through a Micro-Biorestation facility (u-b).

PROFESSIONAL CERTIFICATION
I hereby certify that these documents were prepared or approved by me, and that I am a duly licensed professional engineer under the laws of the State of Maryland, License No. 810488, Expiration Date: 7/28/2023.

SIMPLIFIED ENVIRONMENTAL CONCEPT PLAN PLAN AND NOTES CANAPP PROPERTY

TAX MAP 34 GRID 17
5TH ELECTION DISTRICT

PARCEL 444
HOWARD COUNTY, MARYLAND


FSH Associates
Engineers Planners Surveyors
6220 Powers Lane, Ellicott City, MD 21030
Tel: 410.987.8200 Fax: 410.987.1902
E-mail: info@fsh.com

OWNER/DEVELOPER
Sherman O. Jr. & Debra A. Conapp
10975 CULFORD RD
ANNAPOLIS JUNCTION MD 20701
(301)560-1397

DESIGN BY: M.T.
DRAWN BY: J.L.T.
CHECKED BY: J.T.E.
SCALE: 1" = 30'
DATE: JUNE 23, 2020
JOB NO.: 2102
SHEET NO.: 1 OF 3

APPROVED
6/23/20 ✓

ART GALLERY & MUSEUM EXHIBIT (D) = 21664 S.F.
 WORK STOP (C) = 567 S.F.

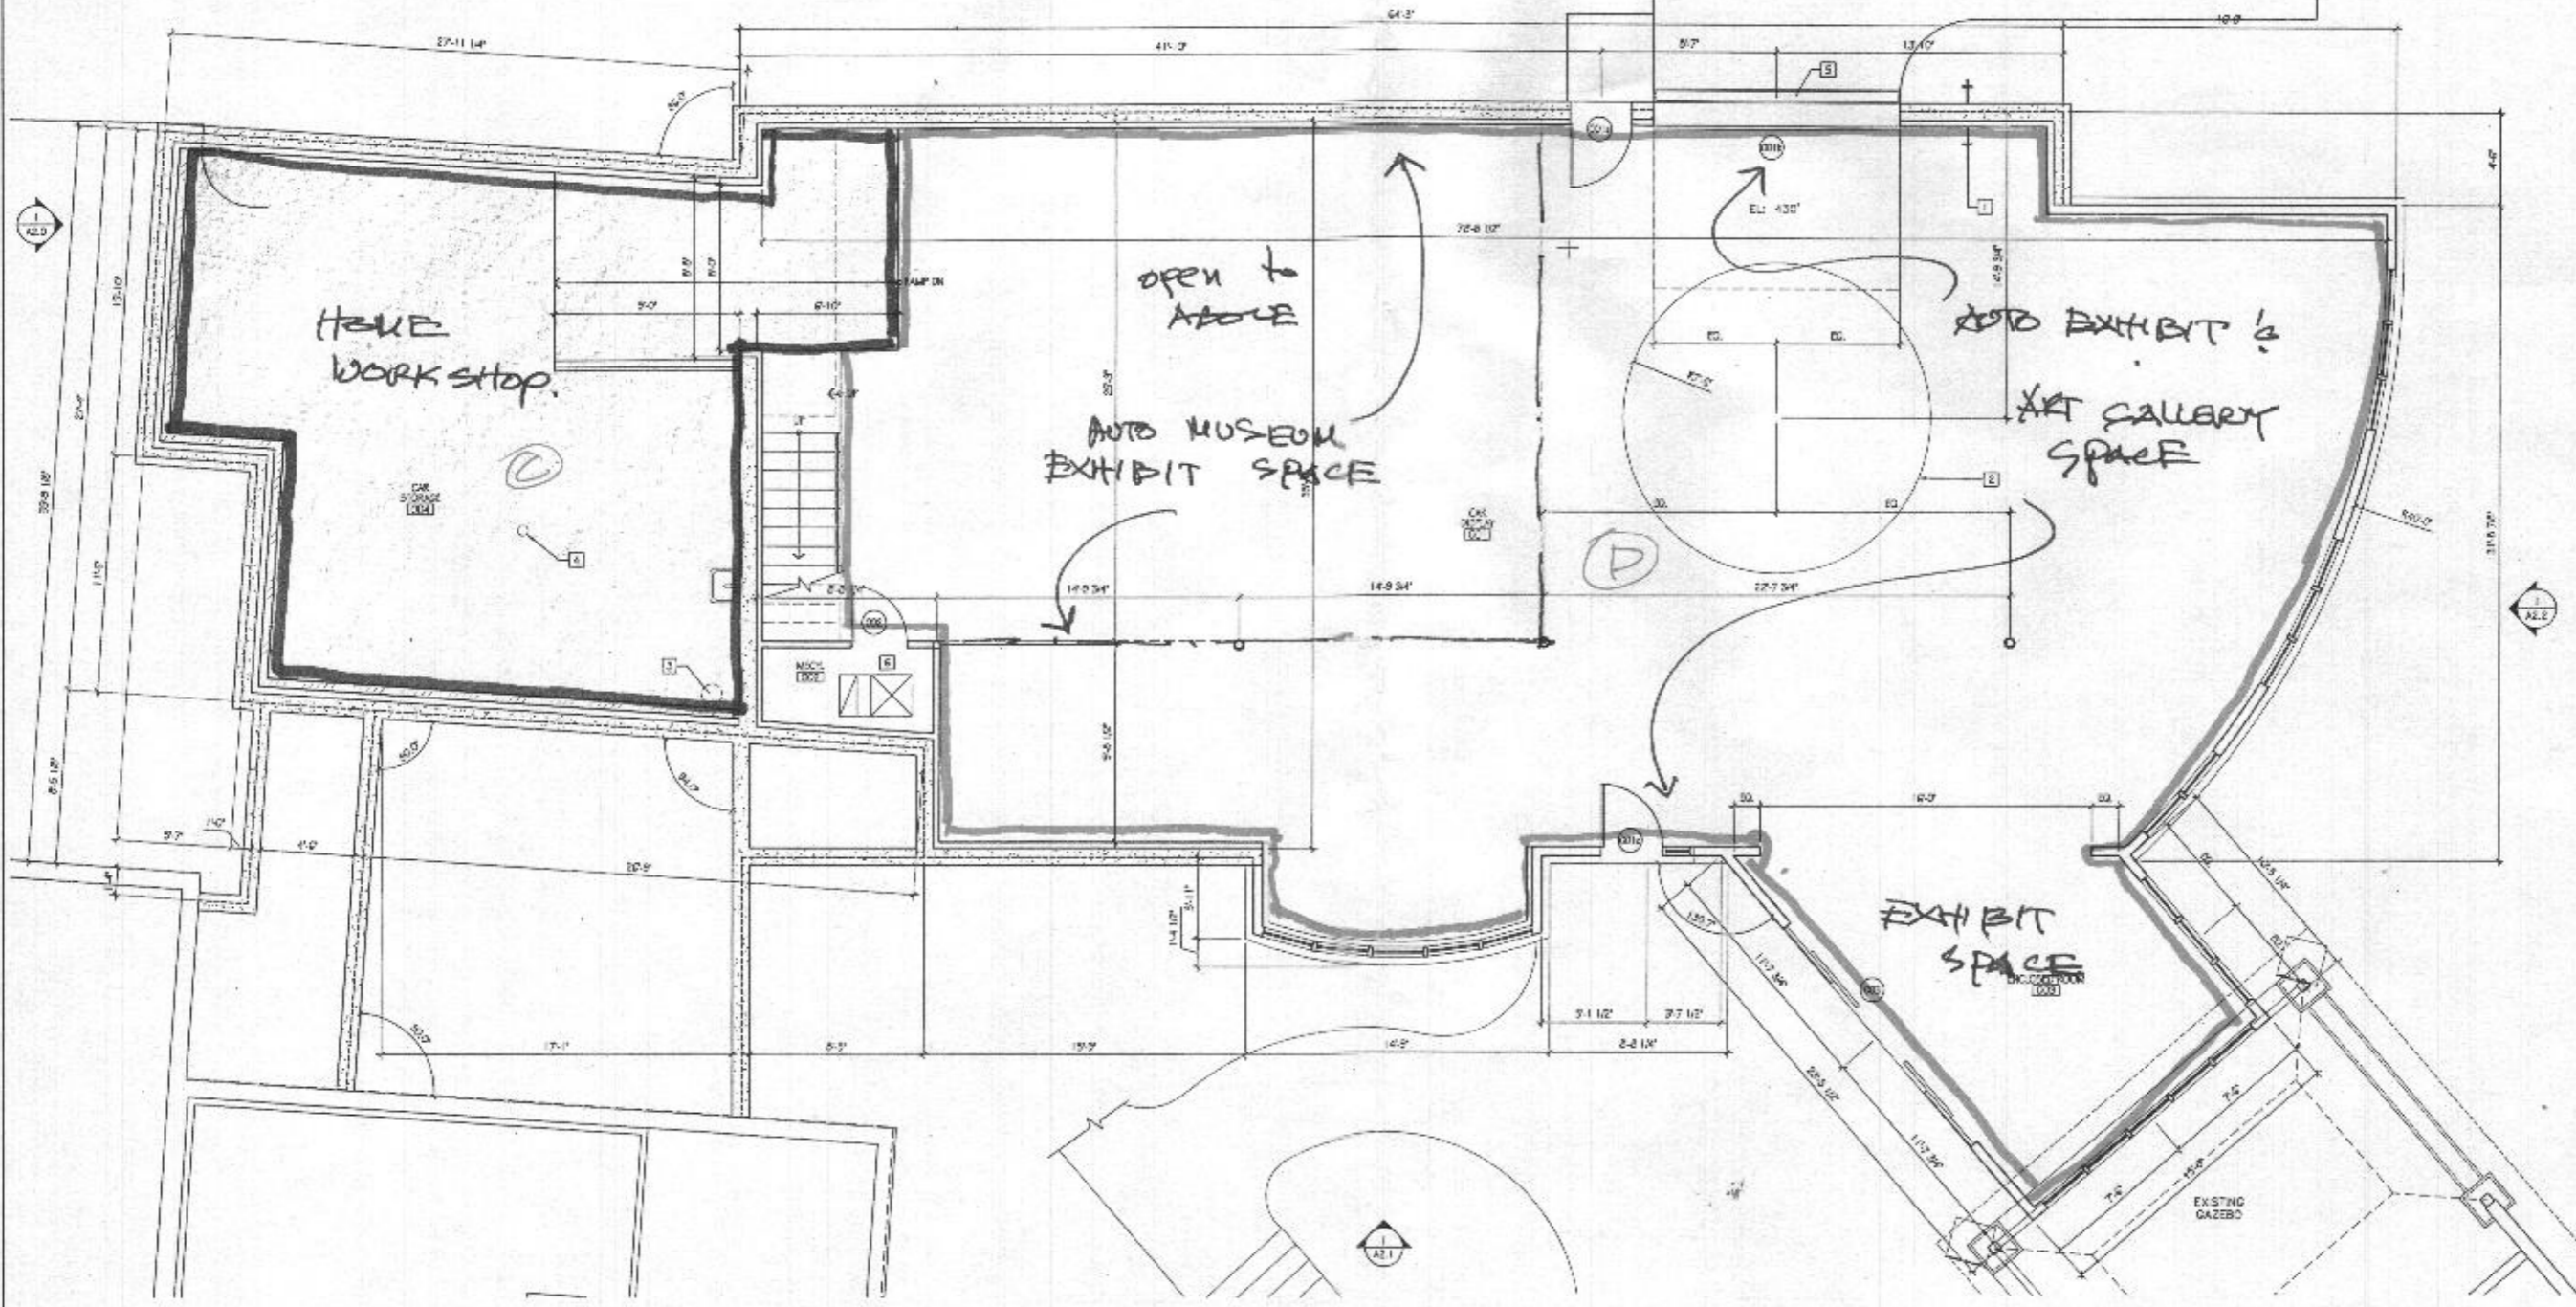

1 BASEMENT FLOOR PLAN
 Scale: 1/4" = 1'-0"

PENNEY DESIGN GROUP
 ARCHITECTURE | PLANNING | INTERIORS
 8120 Woodmont Avenue
 Suite 410
 Bethesda, Maryland 20814
 P. 301.975.7600
 F. 301.710.6384
 www.penneydesigngroup.com

STRUCTURAL ENGINEERING UNLIMITED, L.C.
 341 W. Patrick Street
 Frederick, Maryland 21701

Canapp Residence
 Renovation/Addition
 6501 Heather Glen Way
 Clarksville, MD 21029


1. ALL DIMENSIONS UNLESS OTHERWISE NOTED ARE IN FEET AND INCHES. DIMENSIONS SHALL BE TO FACE UNLESS OTHERWISE NOTED.
 2. ALL DIMENSIONS SHALL BE TO FACE UNLESS OTHERWISE NOTED.
 3. ALL DIMENSIONS SHALL BE TO FACE UNLESS OTHERWISE NOTED.
 4. ALL DIMENSIONS SHALL BE TO FACE UNLESS OTHERWISE NOTED.

No.	Issue / Revision	Date
ISSUED FOR PERMIT		12.29.20
ISSUED FOR REVIEW		12.23.20
ISSUED FOR REVIEW		12.07.20
ISSUED FOR REVIEW		11.17.20
Drawn By:		M.B.
Checked By:		R.P.
Checked By:		
Plot Date:		

KEYED PLAN NOTES
1. PROVIDE MANG VALVE ON INTERIOR HOSE END.
2. PROVIDE CAST IRON FURNACE. SEE MANUFACTURER'S INSTRUCTIONS FOR INSTALLATION.
3. PUMP PUMP 1 CHECK.
4. FLOOR DRAIN.
5. TRENCH DRAIN.
6. COORDINATE ELECTRICAL PANEL LOCATION TO THE EXISTING TOWER.

GENERAL NOTES
1. ALL EXTERIOR WALLS SHALL BE 8" STUCCO @ 1/2" O.C. U.S.G.
2. ALL INTERIOR WALLS SHALL BE 5/8" STUCCO @ 1/2" O.C. U.S.G.
3. ALL INTERIOR WALLS IN CASES OPENINGS SHALL BE 2" STUCCO U.S.G.
4. PROVIDE REBAR INTO GROUND FOR LIGHTNING PROTECTION.

PLAN LEGEND	
	NEW DOOR & TAG - SEE BOOK S0-10002
	NEW PARTITION - TYPE I U.S.G.
	AREA NOT IN CONTRACT - NO WORK PROPOSED
	EXISTING WALL/PARTITION TO REMAIN
	EXISTING WALL/PARTITION TO BE DEMOLISHED

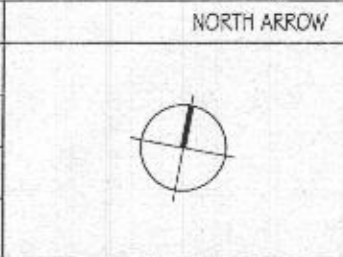


Sheet Number
A1.0
 Sheet Title
Basement Floor Plan
 Project Number
 CAN001a
 File Name
 CAN001P01.dwg

GARAGE A = 673 S.F.

HOME OFFICE B = 1767 S.F.
+ GALLERY

CONVERTOR SPACE B1 = 103 S.F.

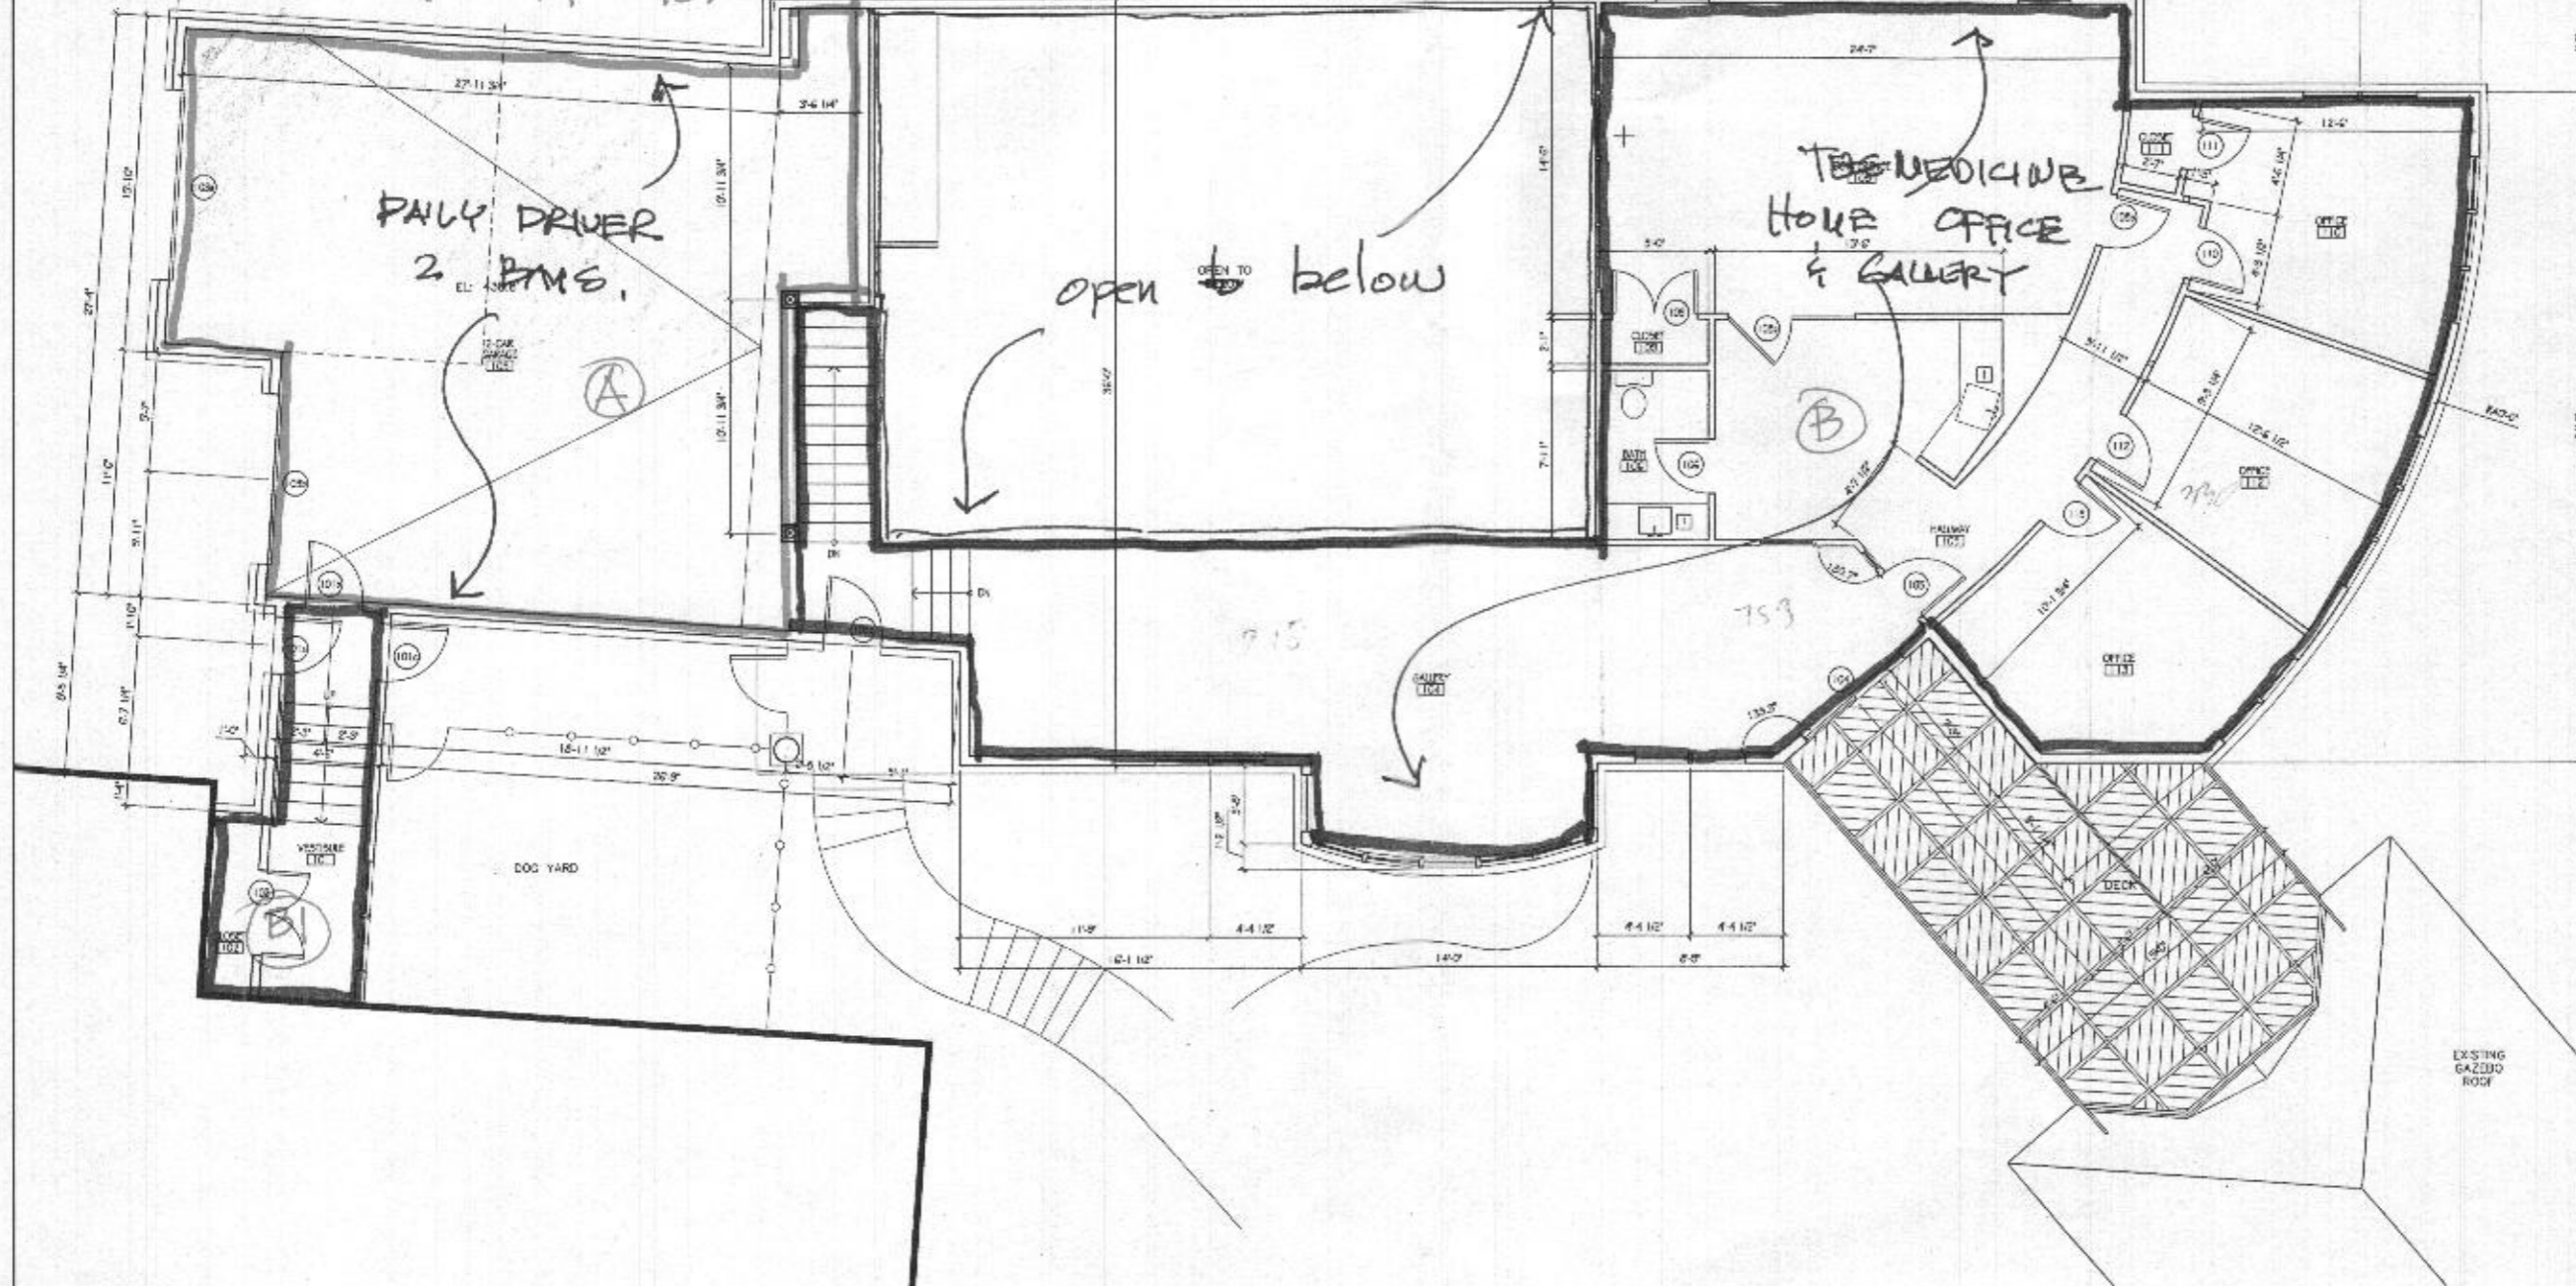

1 FIRST FLOOR PLAN
Scale: 1/4" = 1'-0"

PENNEY DESIGN GROUP
ARCHITECTURE | PLANNING | INTERIORS
8120 Woodmont Avenue
Suite 410
Bethesda, Maryland 20814
P: 301.979.7600
F: 301.710.6364
www.penneydesigngroup.com

STRUCTURAL ENGINEERING UNLIMITED, LLC
341 W. Patrick Street
Frederick, Maryland 21701

Canapp Residence
Renovation/Addition
6501 Heather Glen Way
Clarksville, MD 21029

THIS SET OF PLANS HAS BEEN PREPARED BY ME OR UNDER MY CLOSE PERSONAL SUPERVISION AND I AM A LICENSED ARCHITECT IN THE STATE OF MARYLAND. I AM NOT PROVIDING CONTRACT ADMINISTRATION SERVICES.

ISSUED FOR PERMIT	01.21.21
ISSUED FOR PERMIT	12.29.20
ISSUED FOR REVIEW	12.21.20
ISSUED FOR REVIEW	12.07.20
ISSUED FOR REVIEW	11.17.20
No. / Issue / Revision	Date
Drawn By:	M.B.
Checked By:	E.P.
Plan Date:	

KEYED PLAN NOTES	GENERAL NOTES
1. TANKLESS WATER HEATER.	1. ALL EXTERIOR WALLS SHALL BE 200 S.F. @ 16" O.C. U.S.A. 0.
	2. ALL INTERIOR WALLS SHALL BE 204 STUDS @ 16" O.C. U.S.A. 0.
	3. ALL INTERIOR WALLS IN CASE OF OPENINGS SHALL BE 204 STUDS U.S.A. 0.

PLAN LEGEND	NORTH ARROW
NEW DOOR & TAG - SEE DOOR SCHEDULE	
NEW WINDOW - TYPE 1 U.S.A. 0	
AREA NOT IN CONTRACT - NO WORK PROPOSED	
EXISTING WALL/PARTITION TO REMAIN	
EXISTING DOOR TO REMAIN	
EXISTING DOOR TO BE DEMOLISHED	
EXISTING WALL/PARTITION TO BE DEMOLISHED	

Sheet Number
A1.1
Sheet Title
First Floor Plan
Project Number
CAN001a
File Name
CAN001a00.dwg

Oswald, Hank

From: Williams, Jeffrey
Sent: Tuesday, March 16, 2021 9:45 AM
To: Oswald, Hank
Subject: RE: B21000493_6501 Heather Glen Way

I Think we can accept that with this email in the file. We can let them know that this is based on no employees or customers.

From: Oswald, Hank <hoswald@howardcountymd.gov>
Sent: Tuesday, March 16, 2021 9:36 AM
To: Williams, Jeffrey <jewilliams@howardcountymd.gov>
Subject: RE: B21000493_6501 Heather Glen Way

The owners response was in this email thread.

Hank

From: Williams, Jeffrey <jewilliams@howardcountymd.gov>
Sent: Tuesday, March 16, 2021 9:35 AM
To: Oswald, Hank <hoswald@howardcountymd.gov>
Subject: RE: B21000493_6501 Heather Glen Way

Was that in an email or phone call? We should have it in writing. If email, can you forward it to me? If not, can you get them to send it in writing for me to look at and consider?

From: Oswald, Hank <hoswald@howardcountymd.gov>
Sent: Tuesday, March 16, 2021 9:29 AM
To: Williams, Jeffrey <jewilliams@howardcountymd.gov>
Subject: FW: B21000493_6501 Heather Glen Way

Hi jeff:

I reached out to the owner of 6501 Heather Glen Way regarding the home addition showing 3 offices and a conference room. Based on his response, it doesn't sound like he will be receiving clients or allowing employees to work out of his home offices. Based on this info, is it acceptable to sign off on the building permit?

Thanks,

Hank

From: Sherman Canapp <scanapp3@gmail.com>
Sent: Monday, March 15, 2021 5:01 PM
To: Oswald, Hank <hoswald@howardcountymd.gov>
Cc: Debra Canapp <DrD@canappsportsmed.com>; Sherman Canapp <DrS@canappsportsmed.com>
Subject: Re: B21000493_6501 Heather Glen Way

[Note: This email originated from outside of the organization. Please only click on links or attachments if you know the sender.]

Good afternoon Mr. Oswald,

Thank you so much for taking the time to review our project.

Just prior to the onset of COVID, my wife (Dr. Debra Canapp) and daughter (Ally Canapp) created a virtual tele-educational project called Canapp Sports Medicine (CSM).

<https://www.canappsportsmed.com>

CSM allows us to "virtually" help pet owners and veterinarians that have dogs with challenging orthopedic conditions. Via ZOOM and other virtual software programs, we help to virtually educate pet owners on injuries and treatment options as well as helping veterinarians understand how to treat these conditions. We also offer virtual educational webinars.

For the past year, the three of us have been working out of our small home office which is very challenging. The new space we are wishing to build would allow for the three of us to work in separate home office spaces for calls / zooms, and then together in the conference room when the three of us are on the same zoom together. We called it a "conference room" but it's really just a larger home office room to allow the three of us to sit at the same table. There will be no employees, patients, clients etc. Just my wife, daughter and I using this space as a home office.

In addition, my wife and I are car enthusiasts and we are wishing to expand our collection with the additional space. The majority of the new space will be a garage with the smaller portion home office space.

Thank you very much for your consideration of our project. We would be more than happy to discuss over the phone should you have additional questions. My cell is 301-305-1249.

Best,

Drs. Sherman and Debra Canapp

Sherman O. Canapp Jr., DVM, MS, CCRT
Diplomate, American College of Veterinary Surgeons
Diplomate, American College of Veterinary Sports Medicine
& Rehabilitation, (Past President)

National Director of Regenerative, Rehabilitation and Sports Medicine,
Pathway Vet Alliance

Co-founder,
Veterinary Orthopedic & Sports Medicine Group (VOSM)

President & CEO,
Orthobiologic Innovations, LLC
R&D in Regenerative & Sports Medicine

Founder & CEO,
Project GO (Global Orthopedics)

People helping animals helping people...
501(c)(3)

Co-founder,
Canapp Sports Medicine, LLC
Virtual Sports Medicine

10975 Guilford Road
Annapolis Junction, MD 20701
Phone: (240) 295-4400
Fax: (240) 295-4401

<http://www.vosm.com>

<http://www.ortho-bio.com>

<http://www.project-go.org>

<https://www.canappsportsmed.com>

On Mar 15, 2021, at 3:53 PM, Oswald, Hank <hoswald@howardcountymd.gov> wrote:

Hello Mr. Canapp:

Good afternoon. I am reviewing the building permit application for the proposed addition located at 6501 Heather Glen Way. The floor plan layout shows 3 offices and a conference room. Will you provide me with some details about your business plan? Are you planning on receiving clients or have employees working out of this office space?

Thanks in advance for your time,

Hank

Hank Oswald, L.E.H.S.
Howard County Health Department
Well & Septic Program
410.313.1786

Oswald, Hank

From: Oswald, Hank
Sent: Tuesday, March 16, 2021 11:17 AM
To: 'Sherman Canapp'
Cc: Debra Canapp; Sherman Canapp
Subject: RE: B21000493_6501 Heather Glen Way

Hi Mr. Canapp:

Thank you for the clarification. Your building permit has been approved. Approval has been based on your response that there will be no employees or customers using the office space.

Thanks,

Hank

From: Sherman Canapp <scanapp3@gmail.com>
Sent: Monday, March 15, 2021 5:01 PM
To: Oswald, Hank <hoswald@howardcountymd.gov>
Cc: Debra Canapp <DrD@canappsportsmed.com>; Sherman Canapp <DrS@canappsportsmed.com>
Subject: Re: B21000493_6501 Heather Glen Way

[Note: This email originated from outside of the organization. Please only click on links or attachments if you know the sender.]

Good afternoon Mr. Oswald,

Thank you so much for taking the time to review our project.

Just prior to the onset of COVID, my wife (Dr. Debra Canapp) and daughter (Ally Canapp) created a virtual tele-educational project called Canapp Sports Medicine (CSM).

<https://www.canappsportsmed.com>

CSM allows us to "virtually" help pet owners and veterinarians that have dogs with challenging orthopedic conditions. Via ZOOM and other virtual software programs, we help to virtually educate pet owners on injuries and treatment options as well as helping veterinarians understand how to treat these conditions. We also offer virtual educational webinars.

For the past year, the three of us have been working out of our small home office which is very challenging. The new space we are wishing to build would allow for the three of us to work in separate home office spaces for calls / zooms, and then together in the conference room when the three of us are on the same zoom together. We called it a "conference room" but it's really just a larger home office room to allow the three of us to sit at the same table. There will be no employees, patients, clients etc. Just my wife, daughter and I using this space as a home office.

In addition, my wife and I are car enthusiasts and we are wishing to expand our collection with the additional space. The majority of the new space will be a garage with the smaller portion home office space.

Thank you very much for your consideration of our project. We would be more than happy to discuss over the phone should you have additional questions. My cell is 301-305-1249.

Best,

Drs. Sherman and Debra Canapp

Sherman O. Canapp Jr., DVM, MS, CCRT
Diplomate, American College of Veterinary Surgeons
Diplomate, American College of Veterinary Sports Medicine
& Rehabilitation, (Past President)

National Director of Regenerative, Rehabilitation and Sports Medicine,
Pathway Vet Alliance

Co-founder,
Veterinary Orthopedic & Sports Medicine Group (VOSM)

President & CEO,
Orthobiologic Innovations, LLC
R&D in Regenerative & Sports Medicine

Founder & CEO,
Project GO (Global Orthopedics)
People helping animals helping people...
501(c)(3)

Co-founder,
Canapp Sports Medicine, LLC
Virtual Sports Medicine

10975 Guilford Road
Annapolis Junction, MD 20701
Phone: (240) 295-4400
Fax: (240) 295-4401

<http://www.vosm.com>

<http://www.ortho-bio.com>

<http://www.project-go.org>

<https://www.canappsportsmed.com>

On Mar 15, 2021, at 3:53 PM, Oswald, Hank <hoswald@howardcountymd.gov> wrote:

Hello Mr. Canapp:

Good afternoon. I am reviewing the building permit application for the proposed addition located at 6501 Heather Glen Way. The floor plan layout shows 3 offices and a conference room. Will you provide me with some details about your business plan? Are you planning on receiving clients or have employees working out of this office space?

Thanks in advance for your time,

Hank

Hank Oswald, L.E.H.S.
Howard County Health Department
Well & Septic Program
410.313.1786