

MARYLAND DEPARTMENT OF THE ENVIRONMENT, WATER MANAGEMENT ADMINISTRATION
 1800 Washington Blvd., Baltimore, Maryland 21230 (410) 537-3784

 WATER WELL ABANDONMENT-SEALING REPORT FORM

SUBMIT COPIES OF COMPLETED FORM TO:

- * COUNTY ENVIRONMENT AGENCY (contact MDE, WMA if address needed)
- * WELL OWNER
- * MDE, WATER MANAGEMENT ADMINISTRATION, WELL PROGRAM

DATE WELL ABANDONED: 3/29/07 (month/day/year)

* PERMIT NUMBER OF ABANDONED WELL (if any)

HO - 88 - 1425

* PERMIT NUMBER OF REPLACEMENT WELL

* PERSON ABANDONING WELL: Richard A. Crummitt

WELL DRILLERS LICENSE NUMBER: WR0 014


* OWNER'S NAME: HAROLDO DRACHENBERG

CIRCLE: MWD/MSD/MGD

* WELL LOCATION:

COUNTY: Howard
 NEAREST TOWN: HIGHLAND
 TAX MAP _____ BLOCK _____ PARCEL _____
 SUBDIVISION: _____
 SECTION: _____ LOT: _____
 NEAREST ROAD: 6851 SANTA MARIA AVE

SITE LOCATION MAP

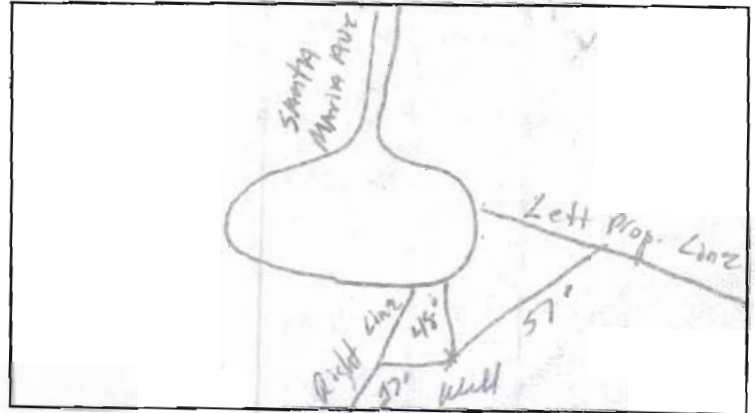

* TYPE OF WELL BEING ABANDONED:

- DRILLED JETTED
- BORED/AUGERED HAND DUG
- OTHER (specify) _____

* USE CODE:

- DOMESTIC MUNICIPAL/PUBLIC
- IRRIGATION INDUSTRIAL
- TEST/OBSERVATION GEOTHERMAL

* TYPE OF CASING:

- STEEL PLASTIC
- CONCRETE OTHER (specify) _____

* SIZE OF CASING: 6 INCHES IN DIAMETER

* DEPTH OF WELL: 280 FEET DEEP

* WAS ANY CASING REMOVED? YES NO
 if yes, length removed, in feet: 3

* WAS CASING RIPPED OR PERFORATED? YES NO

LOG OF SEALING MATERIAL

MATERIAL	FEET	
	FROM	TO
Burhartz Fill DIET	28	1
	1	0
VOLUME OF MATERIAL USED		
<u>28 bags Burhartz</u>		

SIGNATURE- MASTER WELL DRILLER OR SUPERVISING SANITARIAN

LICENSE # 040

MWD/MSD/MGD
 CIRCLE ONE

DATE 3/24/07