


042 Candle Light Drive  
Poyton, MD 21036

AREA: 1330  
R AREA: 1930  
DRAWS: 4  
BERP(2)

TEN ONKS

B21001166

revised site plan

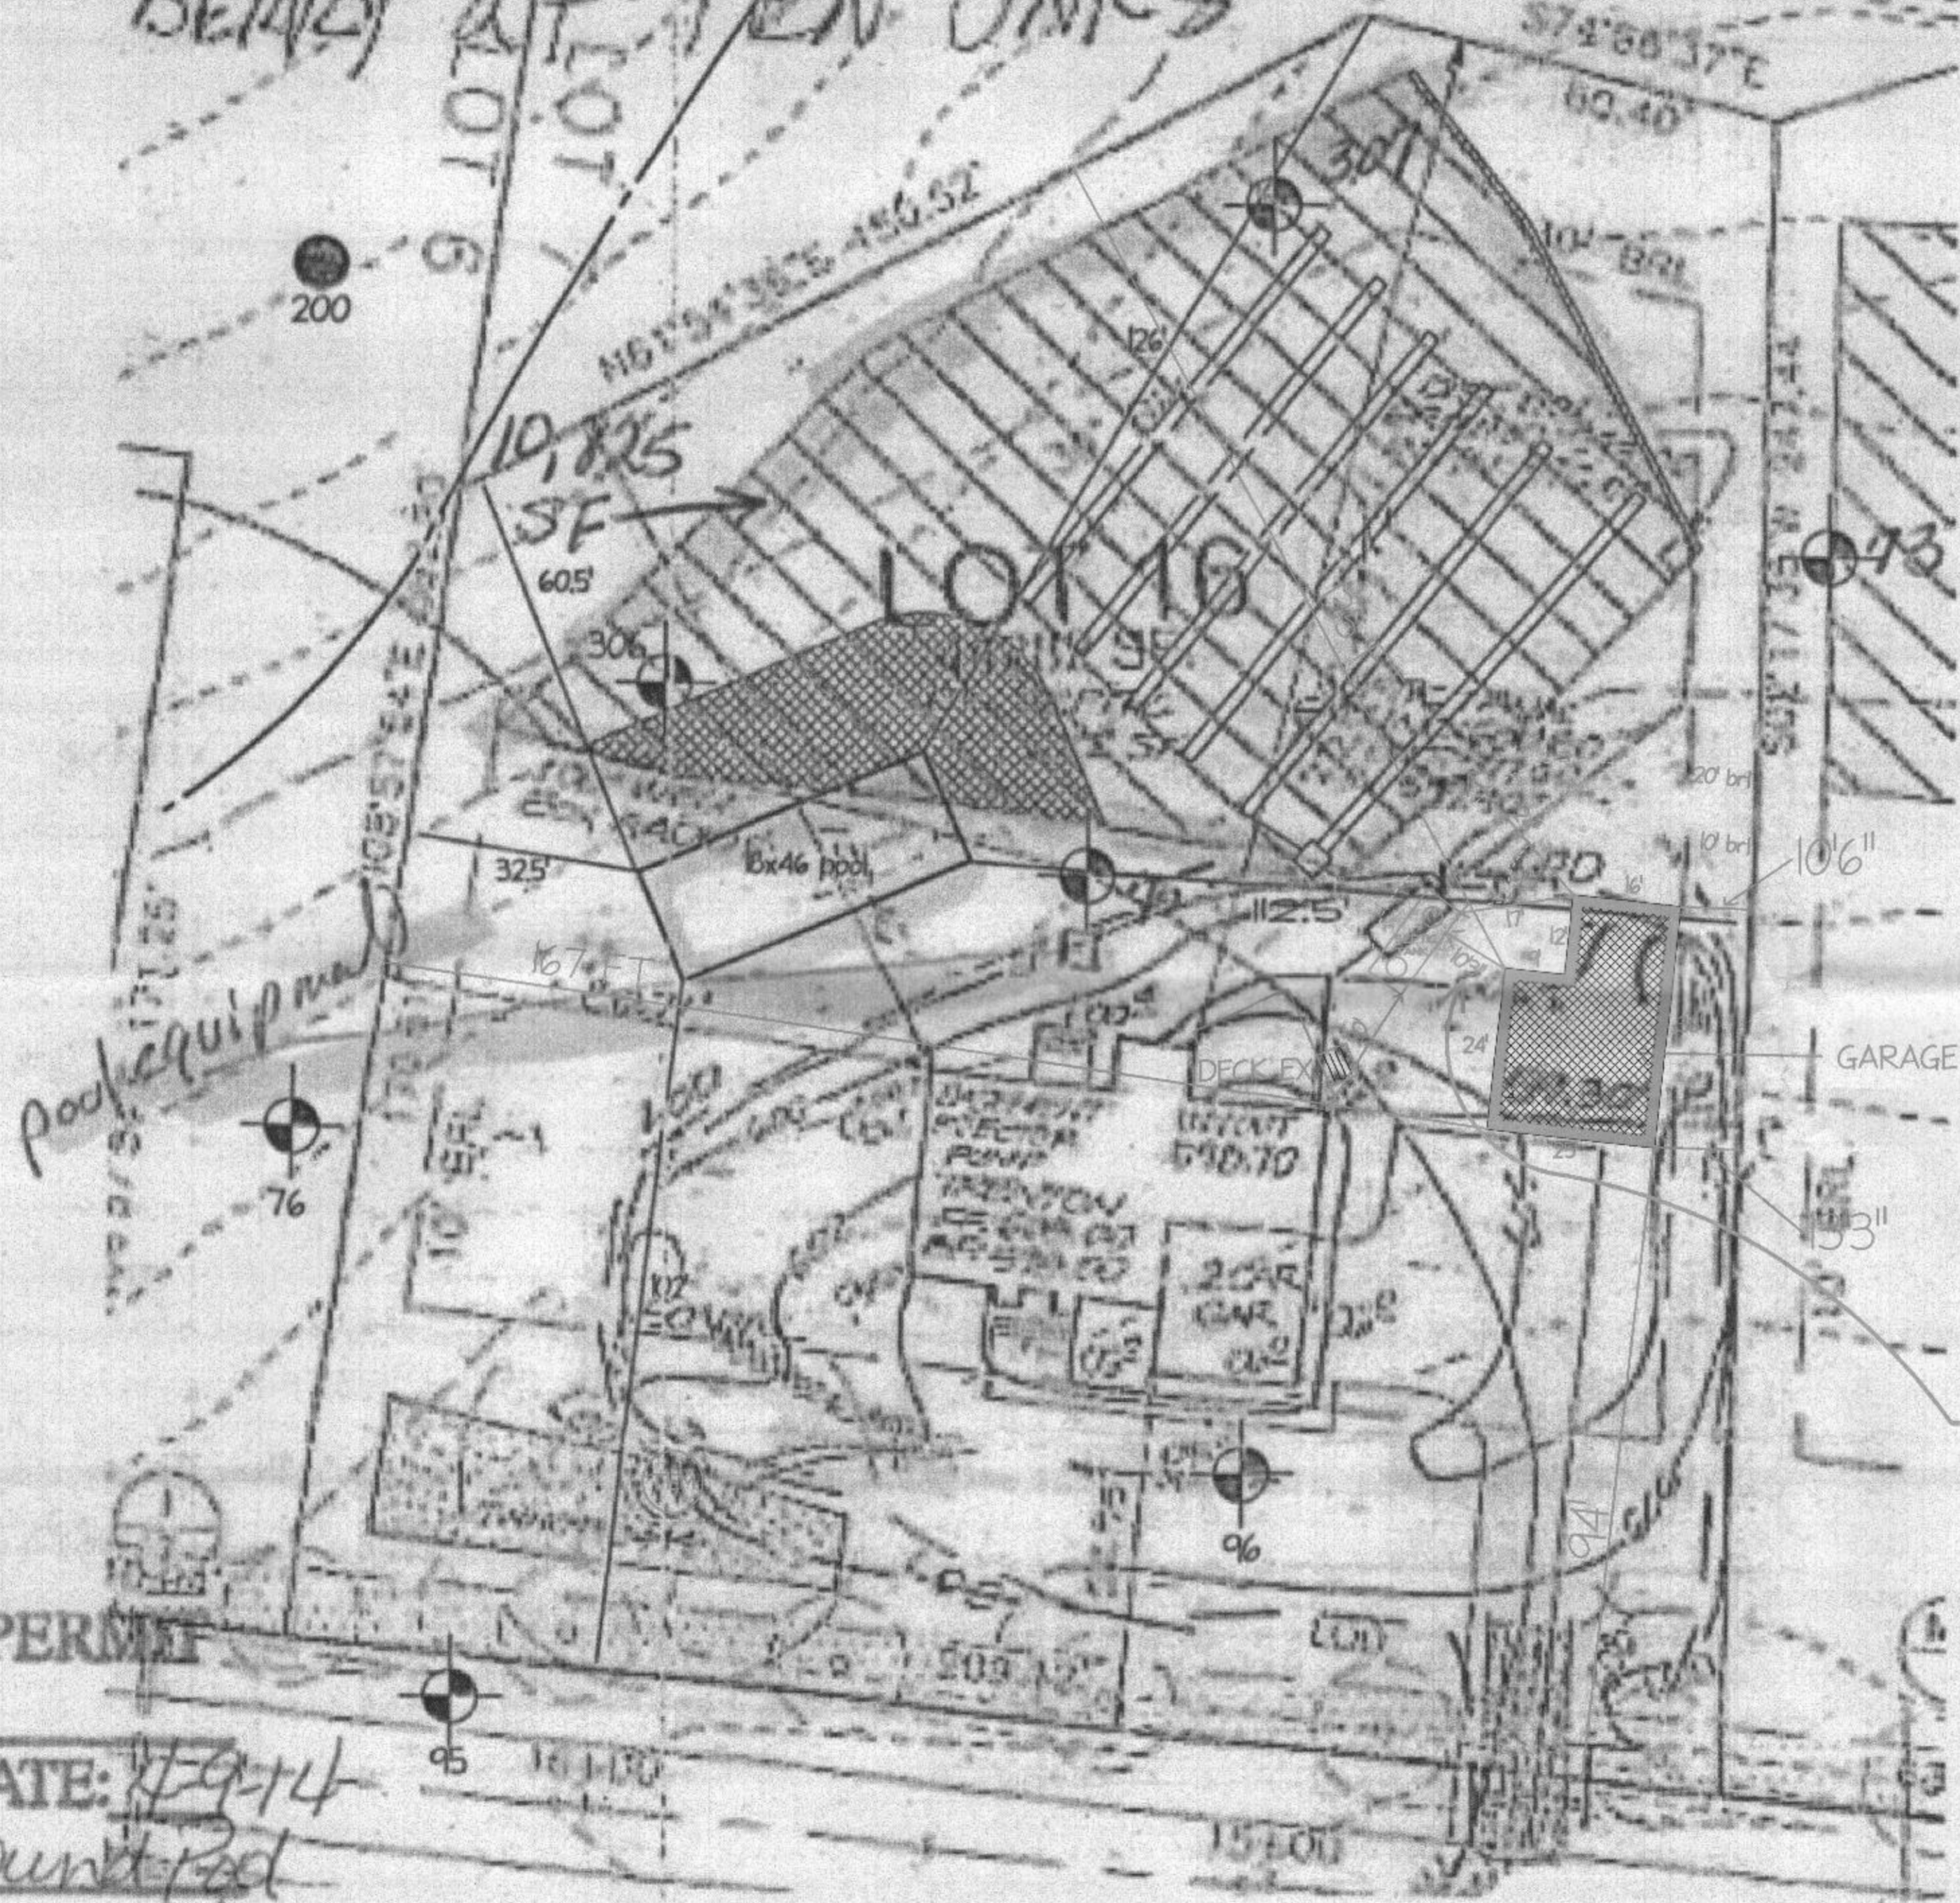

Approved B21001166  
RAE 5/17/2021

10' 3" GARAGE TO TANK

4042 CANDLE LIGHT DR  
DETACHED GARAGE  
CLOSE UP VIEW  
SCALE: 1" = 20'

LEGEND

APPROVED

BUILDING PERMIT

A#  
ward DATE: 4-9-14  
K: Inground Pool  
no. Approved

NOTES  
ALL EXISTING WELLS ON THE SUBJECT PROPERTY AND WITHIN 100 FEET OF SUBJECT PROPERTY

042 Candle Light Drive  
Baylor, MD 2036

AREA: 1330  
R AREA: 1930  
DRAWS: 4  
BEAR) AT TEN OAKS

BZ1001166  
revised site plan



10' 3" GARAGE TO TANK

4042 CANDLE LIGHT DR  
DETACHED GARAGE  
CLOSE UP VIEW  
SCALE: 1" = 20'

APPROVED  
BUILDING PERMIT

A#  
DATE: 7-9-14  
K: Inground  
Approved

NOTES  
ALL EXISTING WELLS ON THE SUBJECT PROPERTY AND WITHIN 100 FEET OF SUBJECT PROPERTY


LEGEND

B21001166

revised site plan

042 Candle Light Drive  
Poyton, MD 2036

AREA: 1330  
R AREA: 1930  
DRAWS: 4  
BE(12)

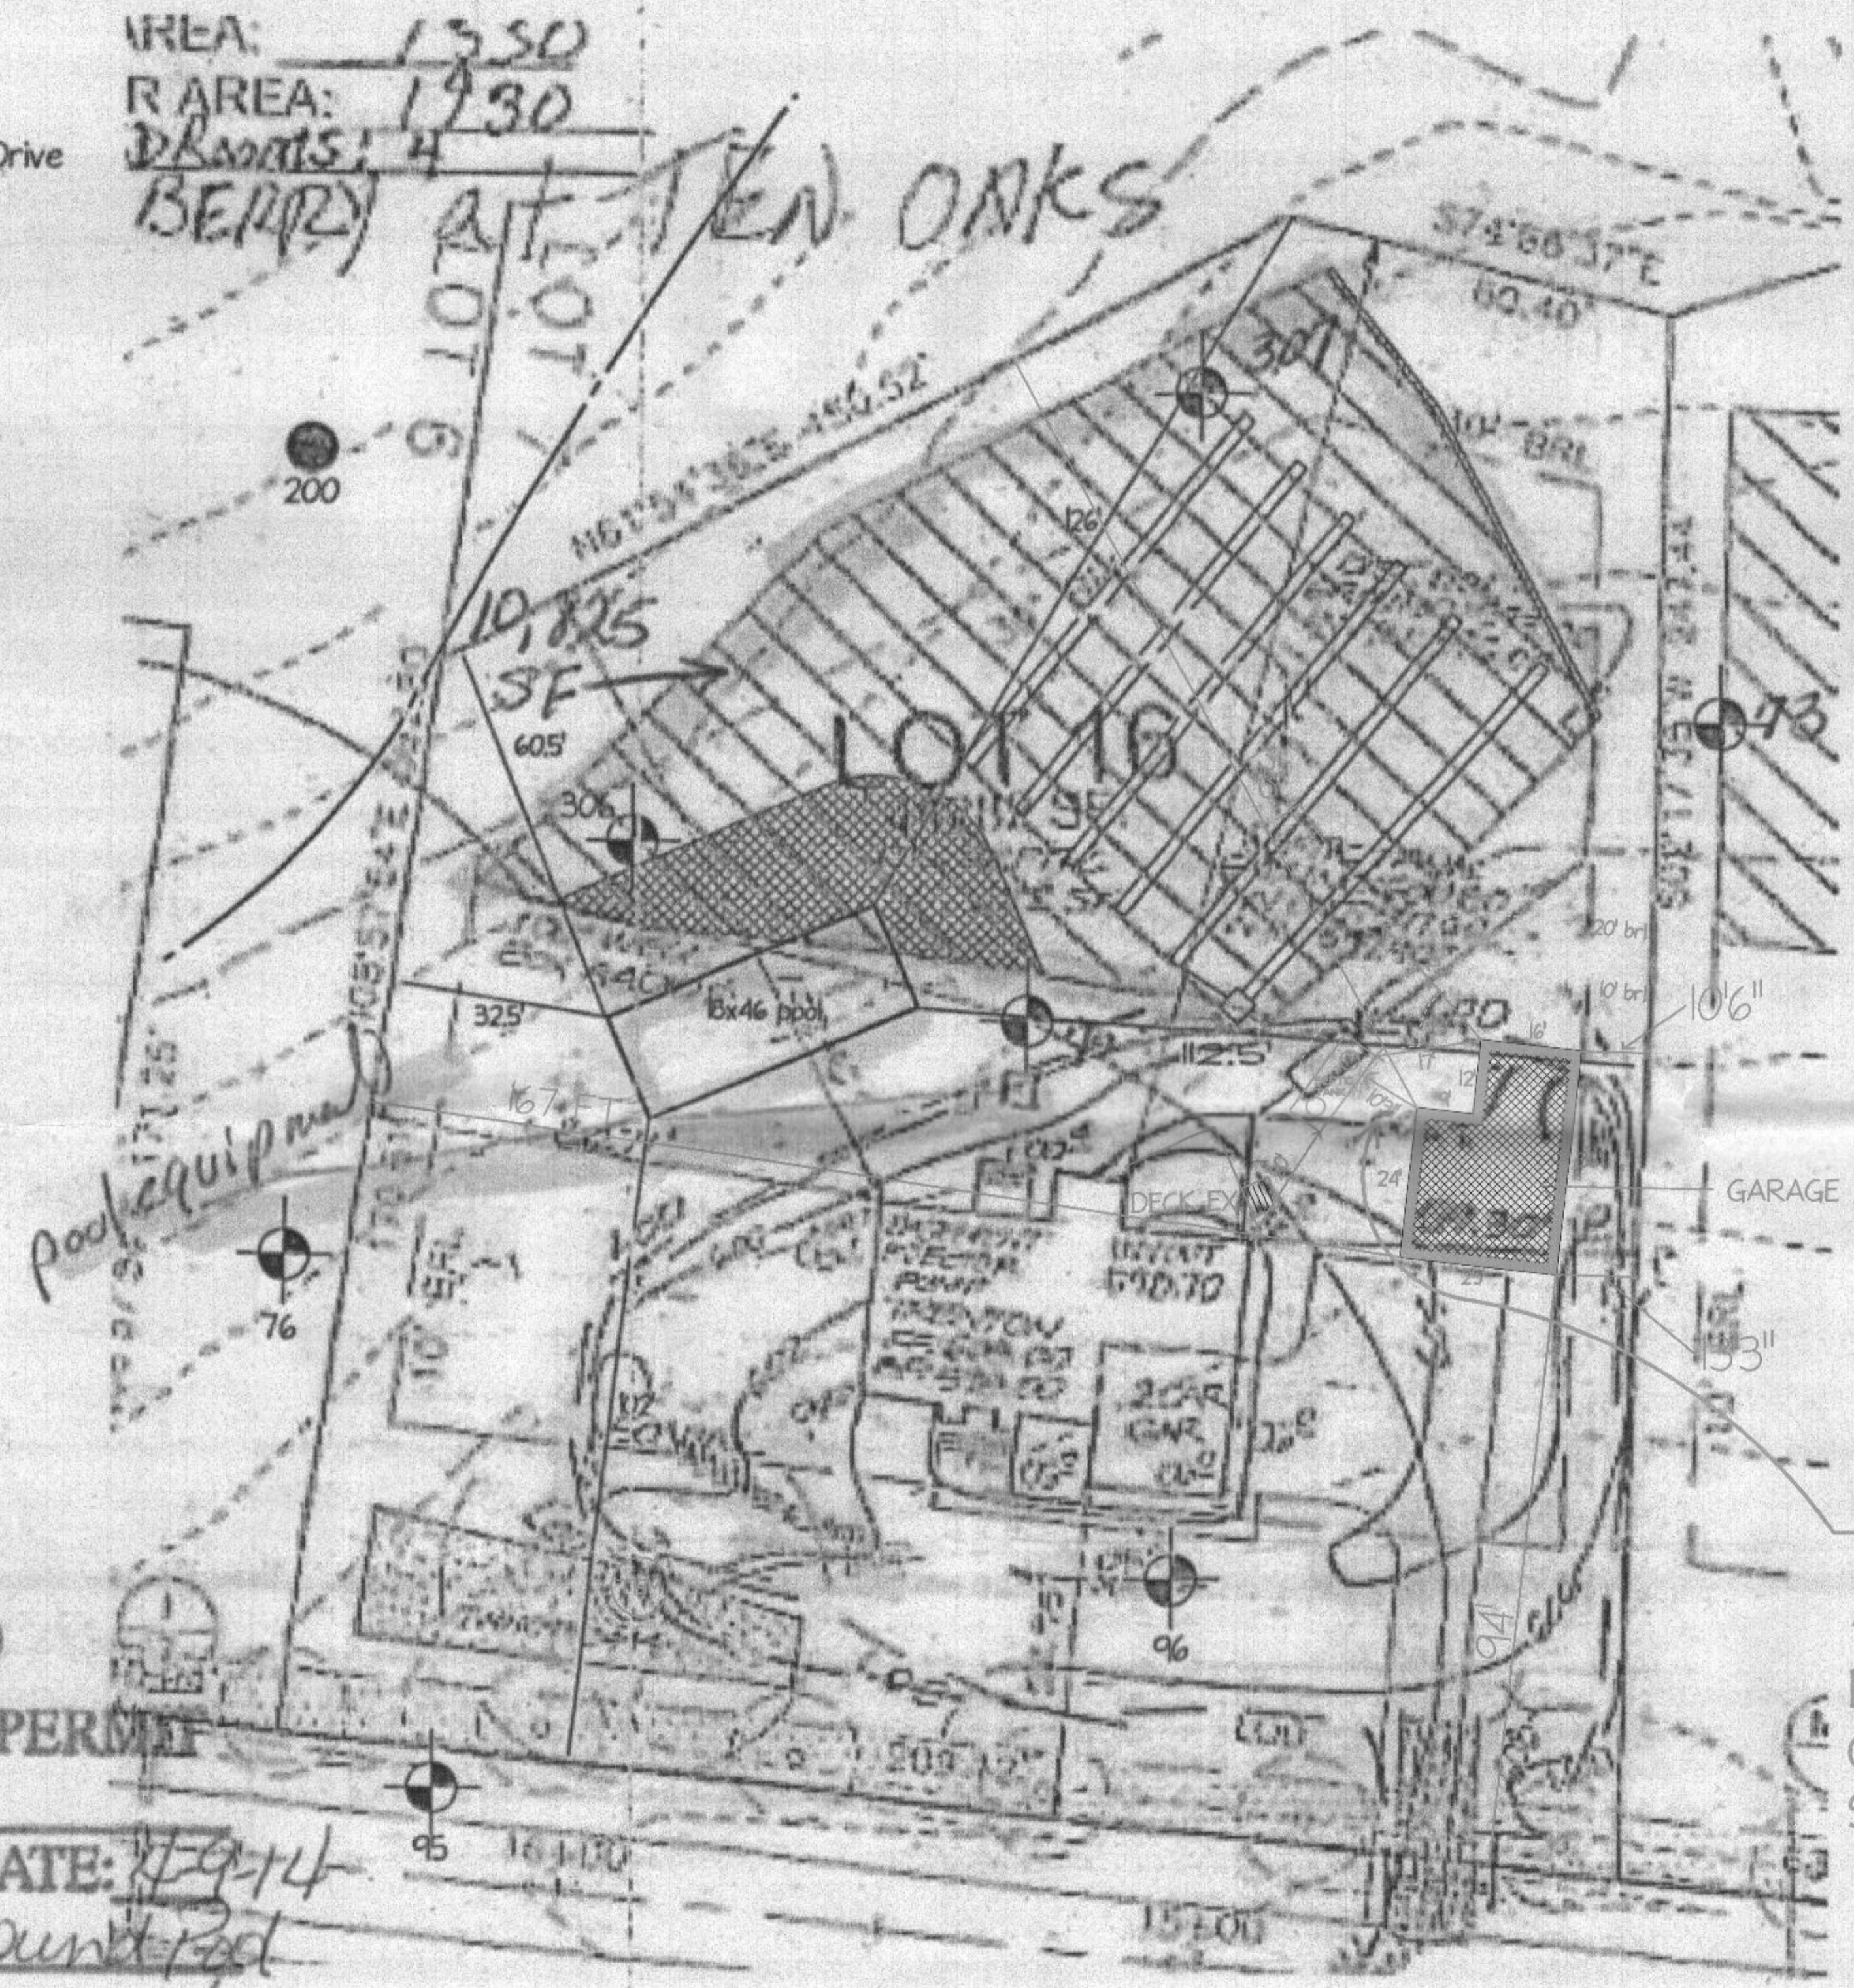

10' 3" GARAGE TO TANK

4042 CANDLE LIGHT DR  
DETACHED GARAGE  
CLOSE UP VIEW  
SCALE: 1" = 20'

APPROVED  
BUILDING PERMIT

A#  
WARD DATE: 4-9-14  
K: Inground Pool  
no. Approved


NOTES  
[ ALL EXISTING WELLS ON THE SUBJECT PROPERTY AND WITHIN 100 FEET OF SUBJECT PROPERTY

LEGEND


Approved  
3/21/2016  
RTE 5/19/2017




FRONT ELEVATION

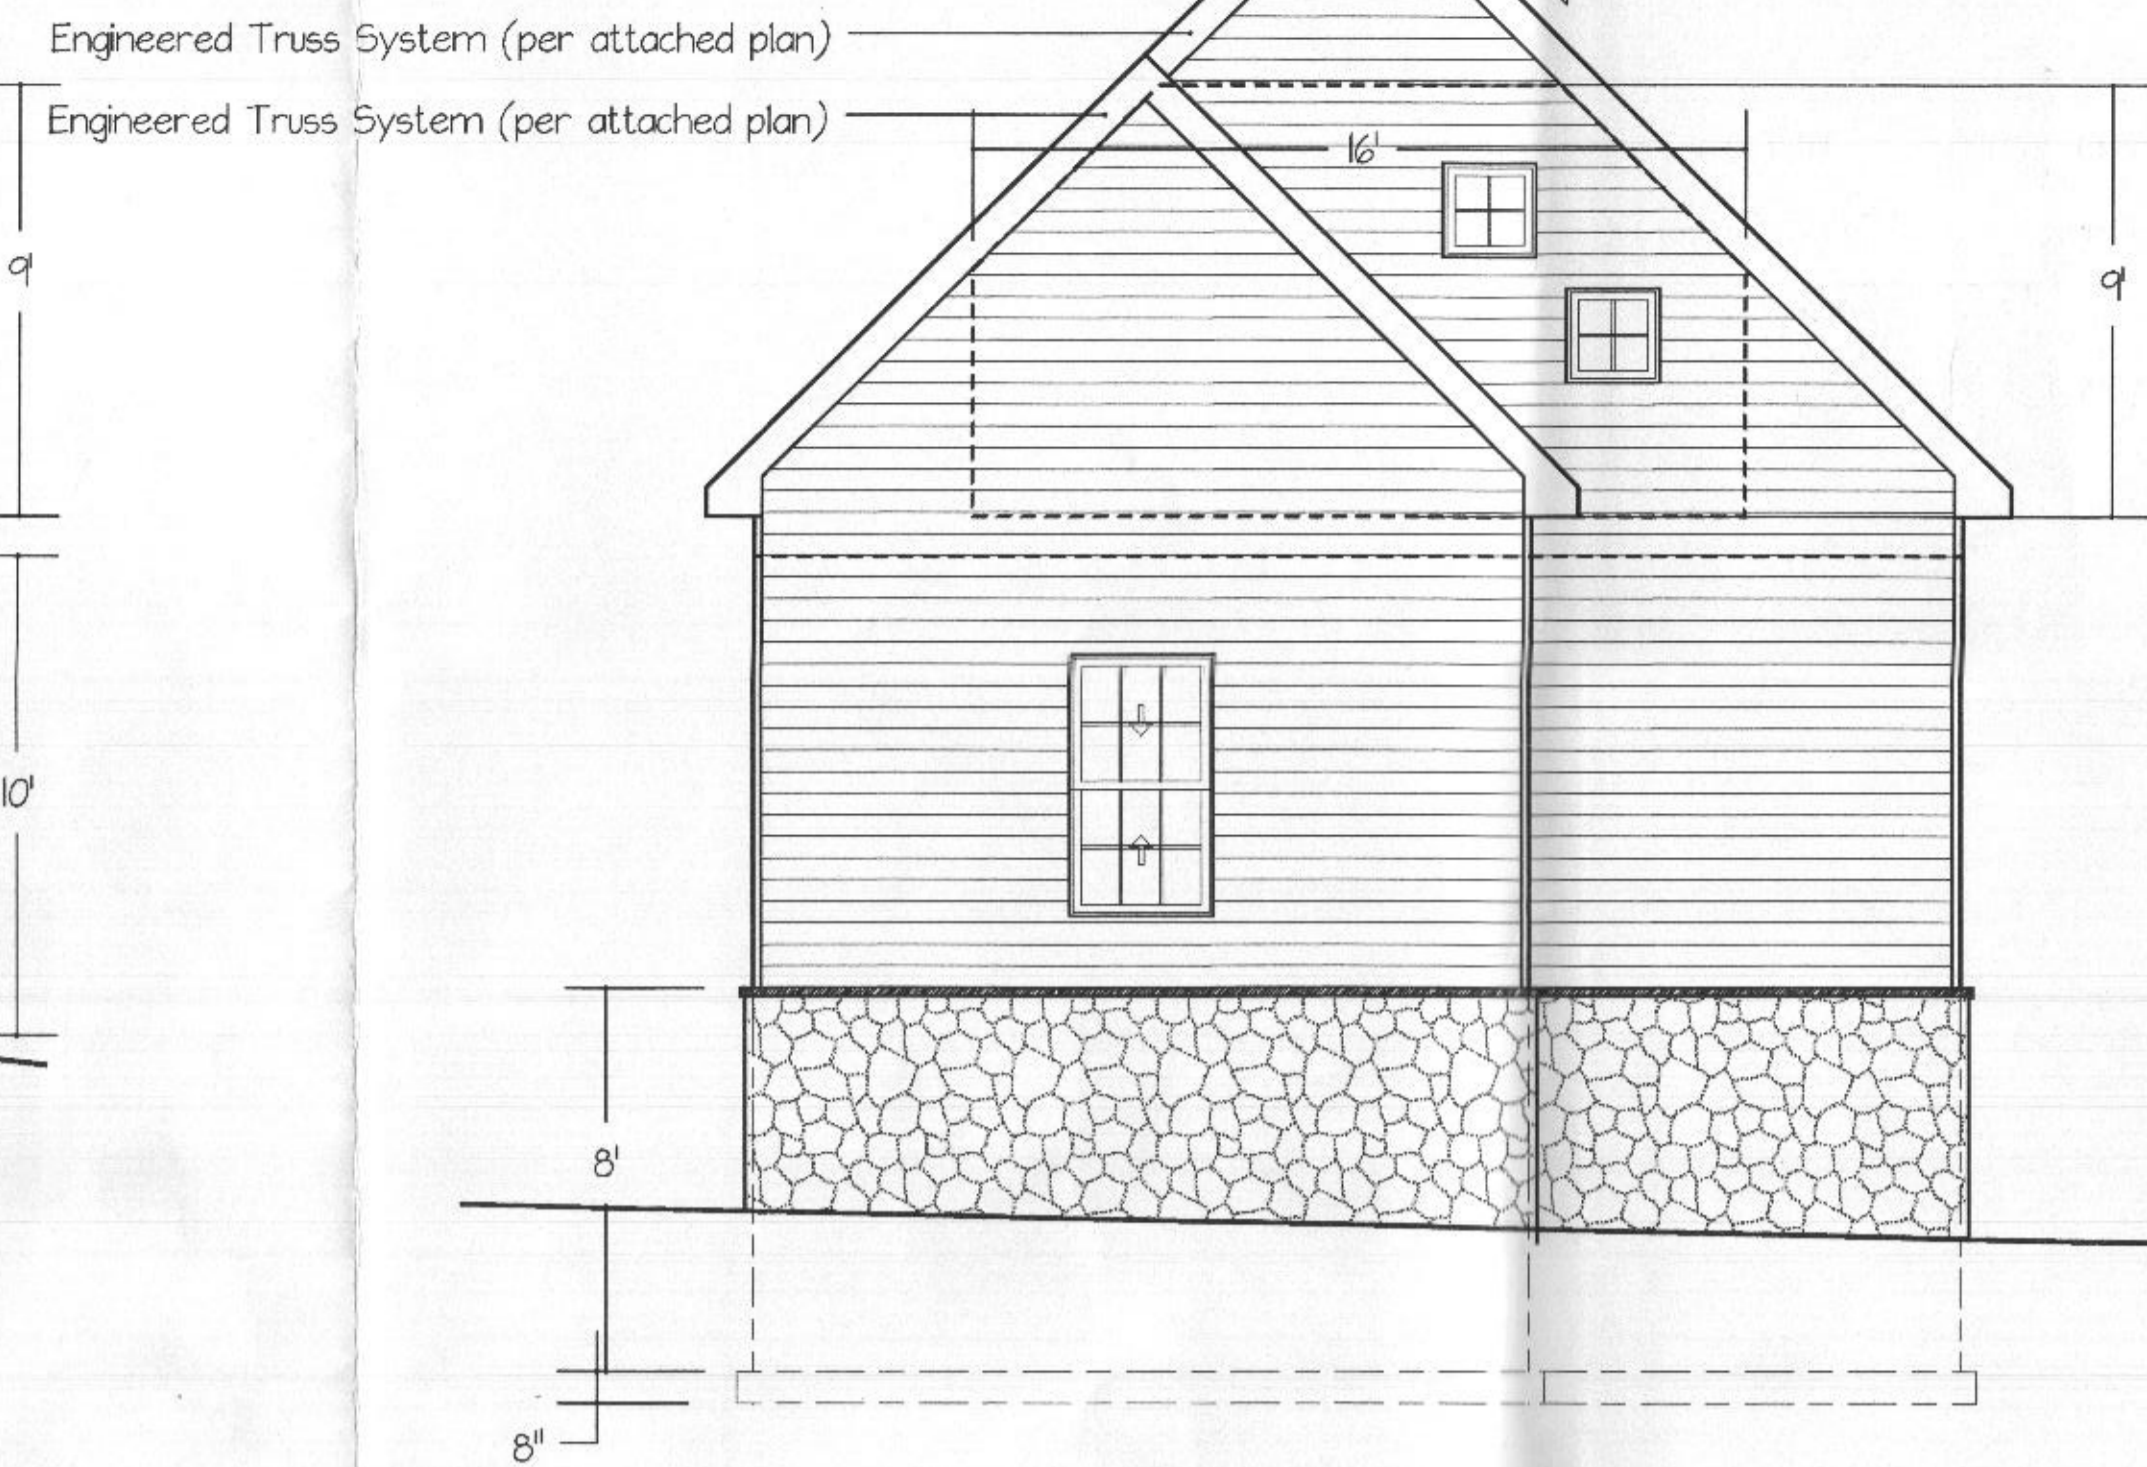


BACK ELEVATION

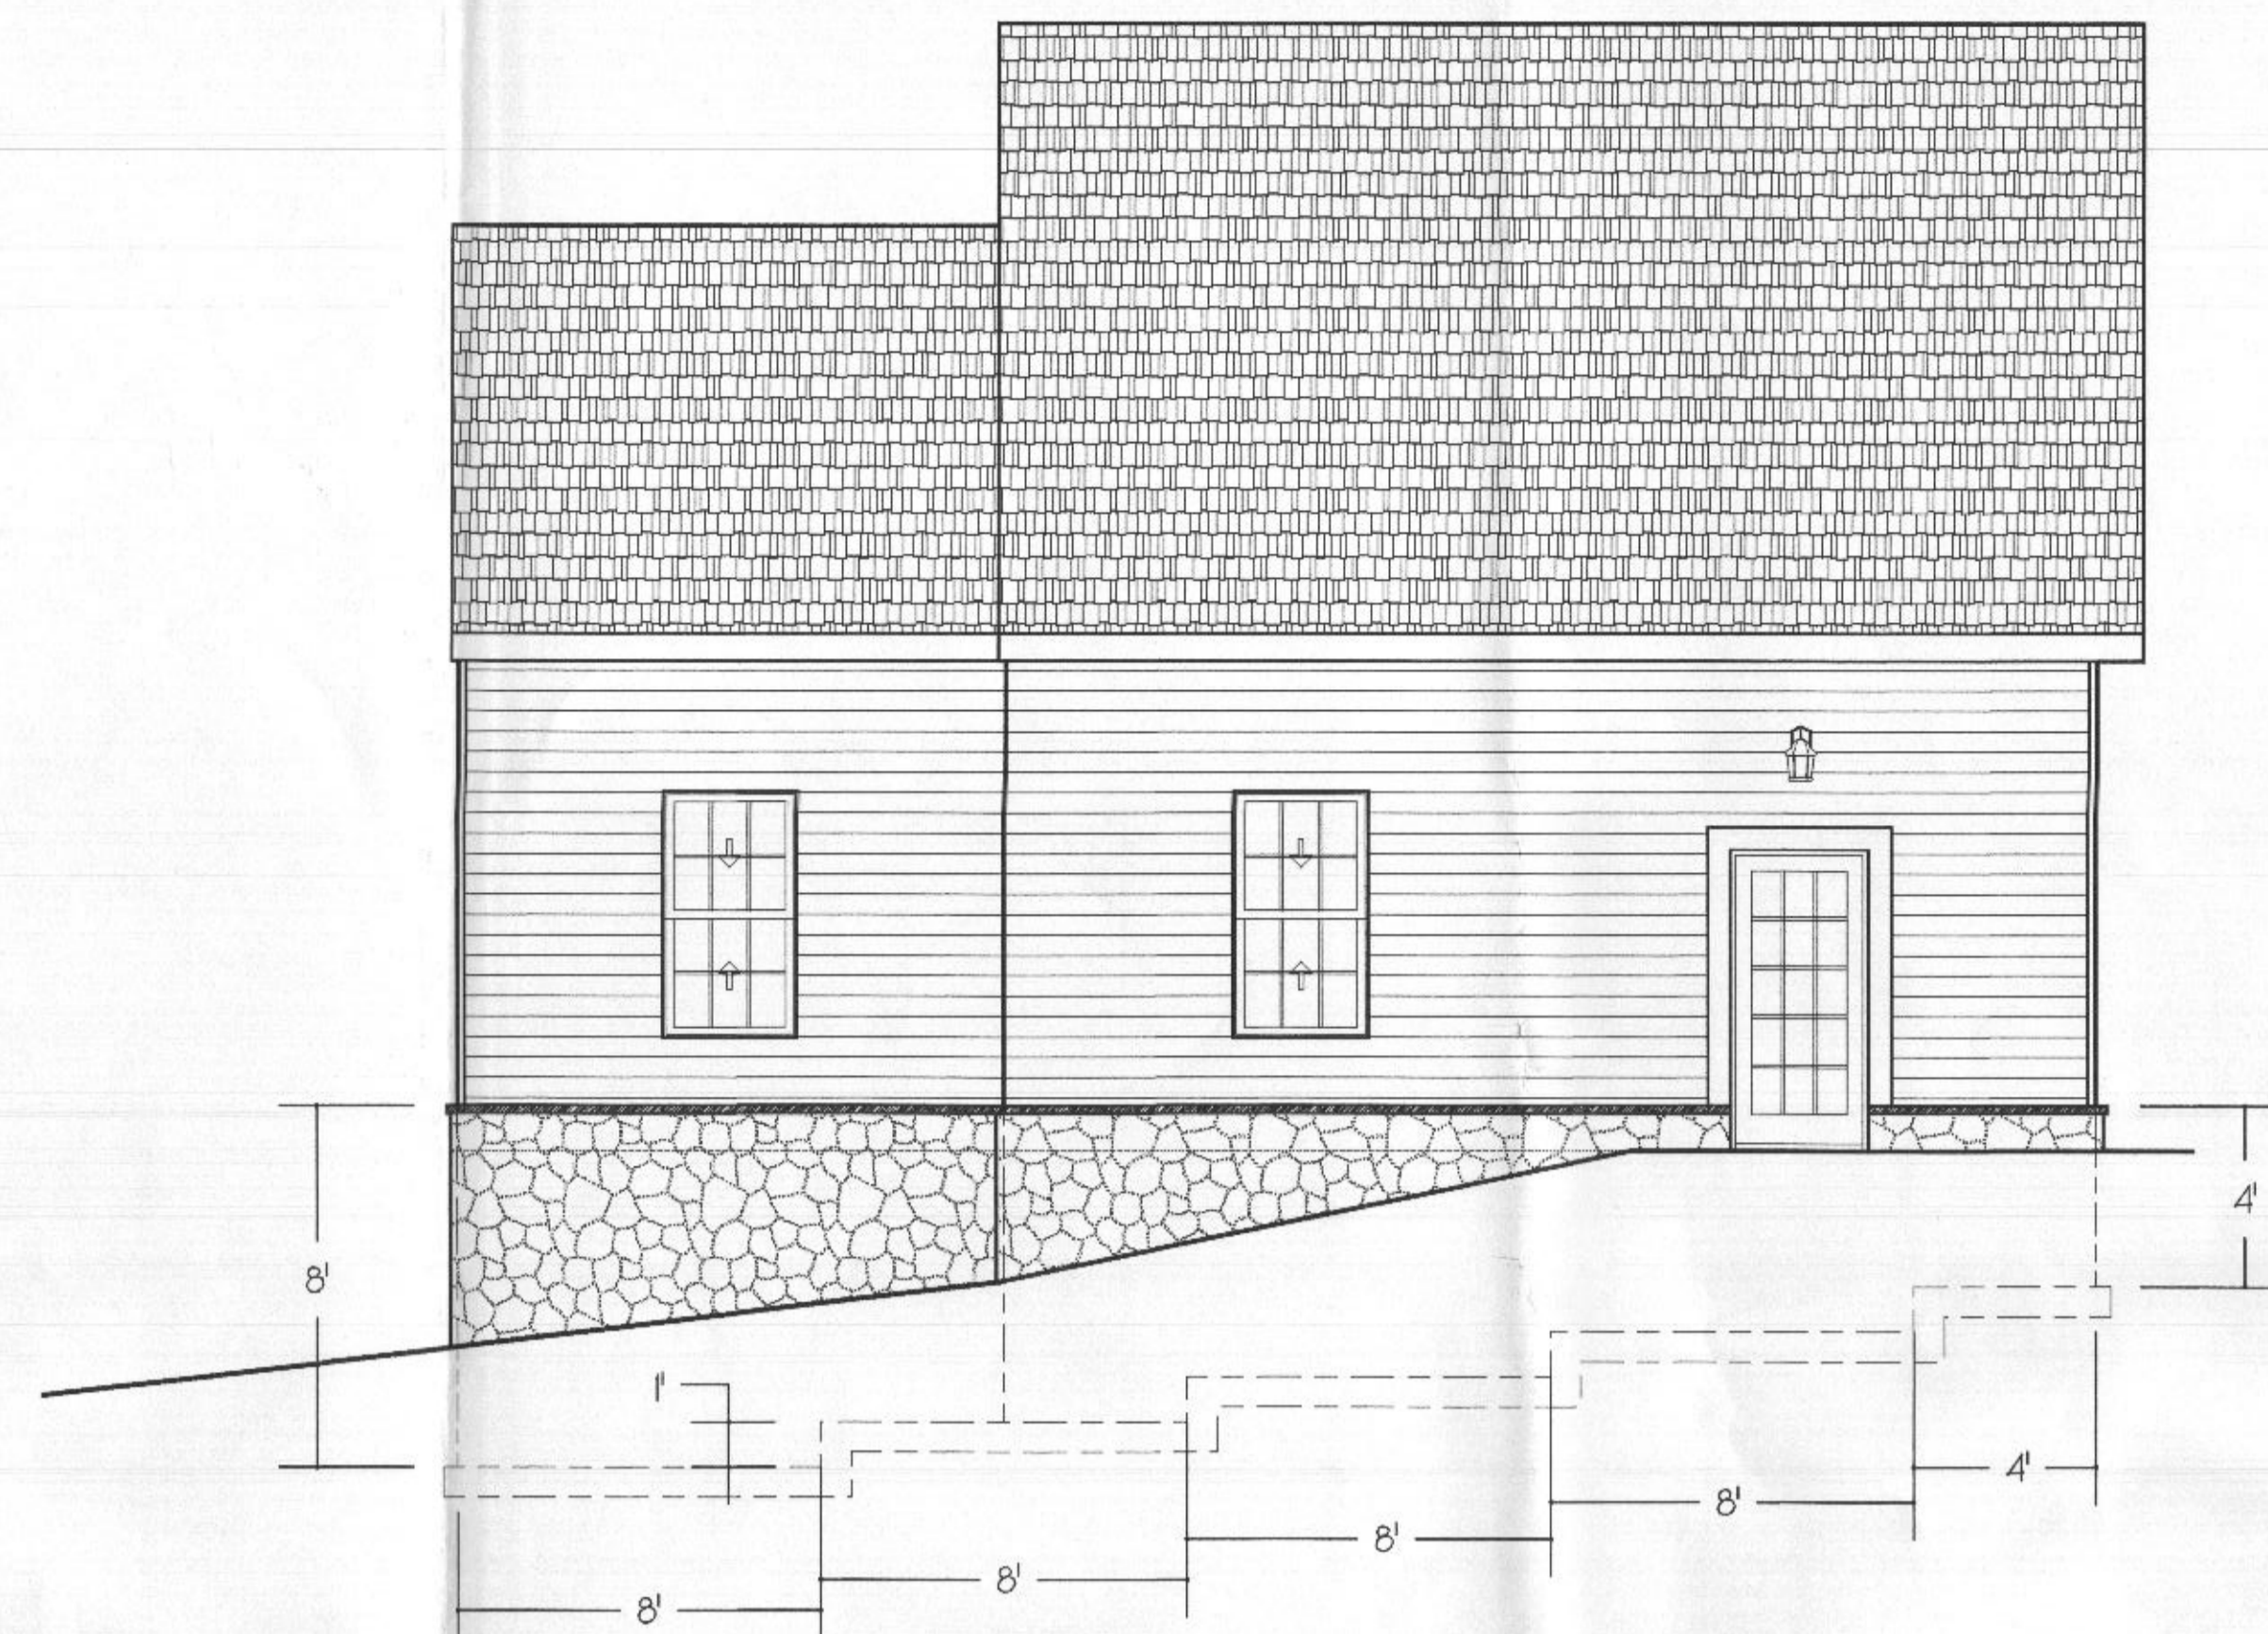


LEFT SIDE ELEVATION

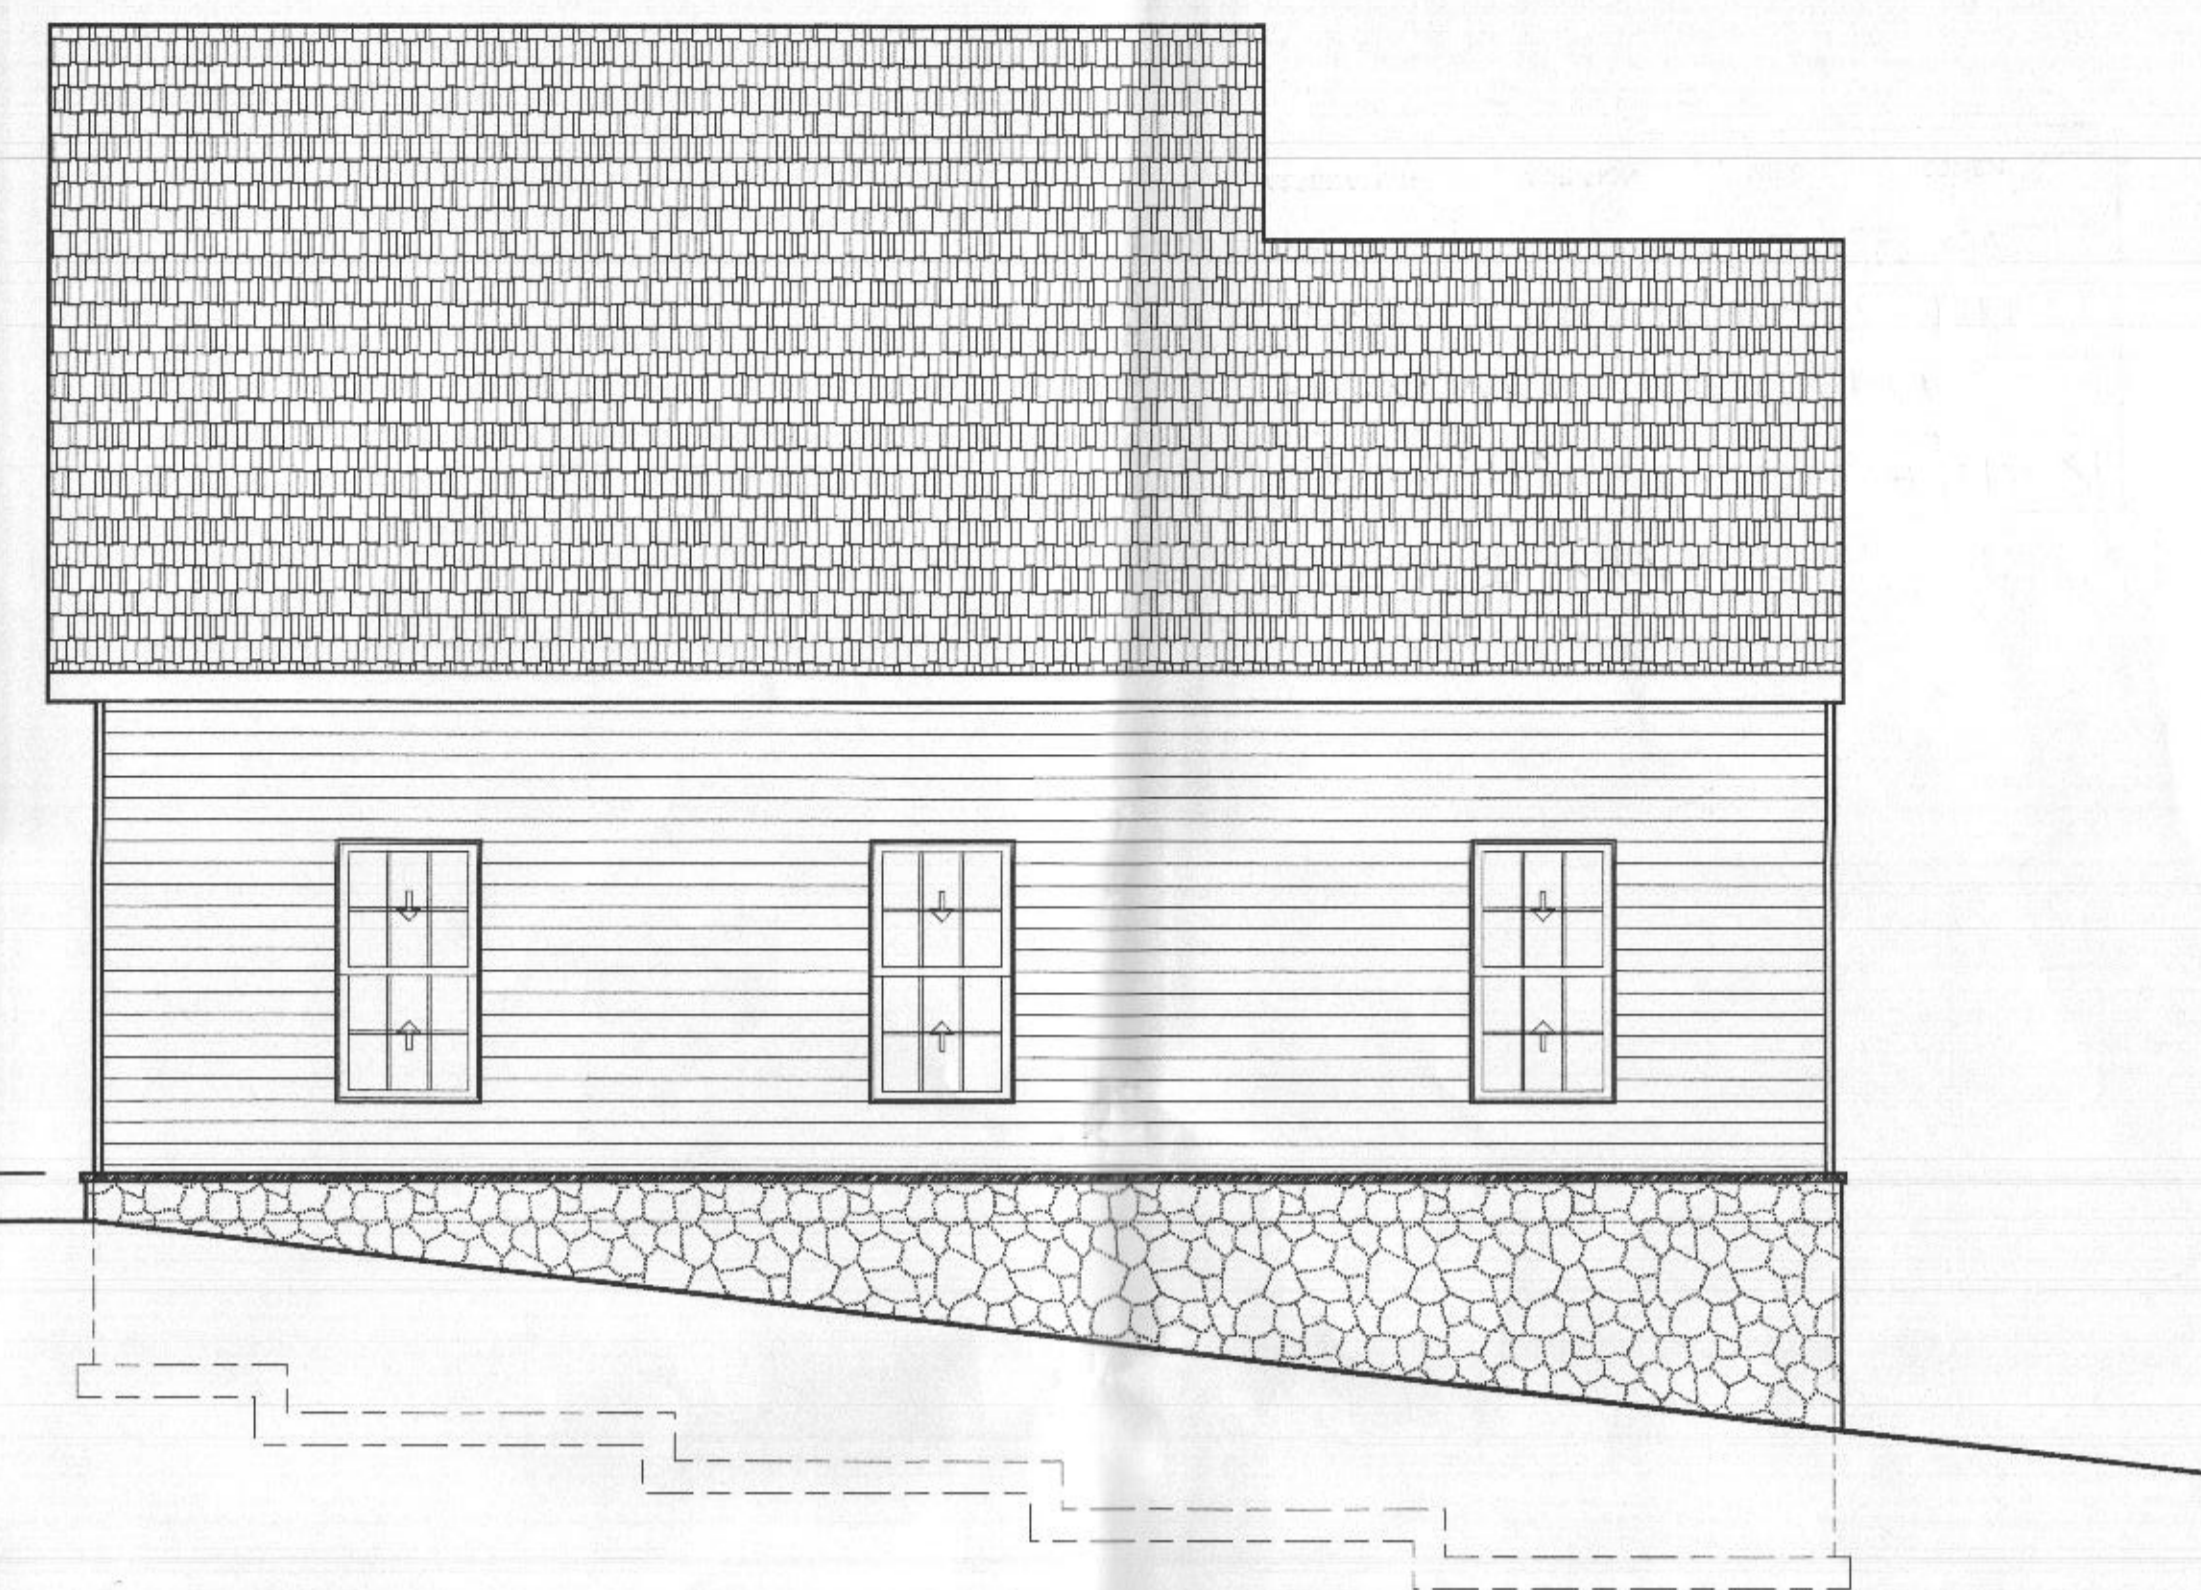


RIGHT SIDE ELEVATION

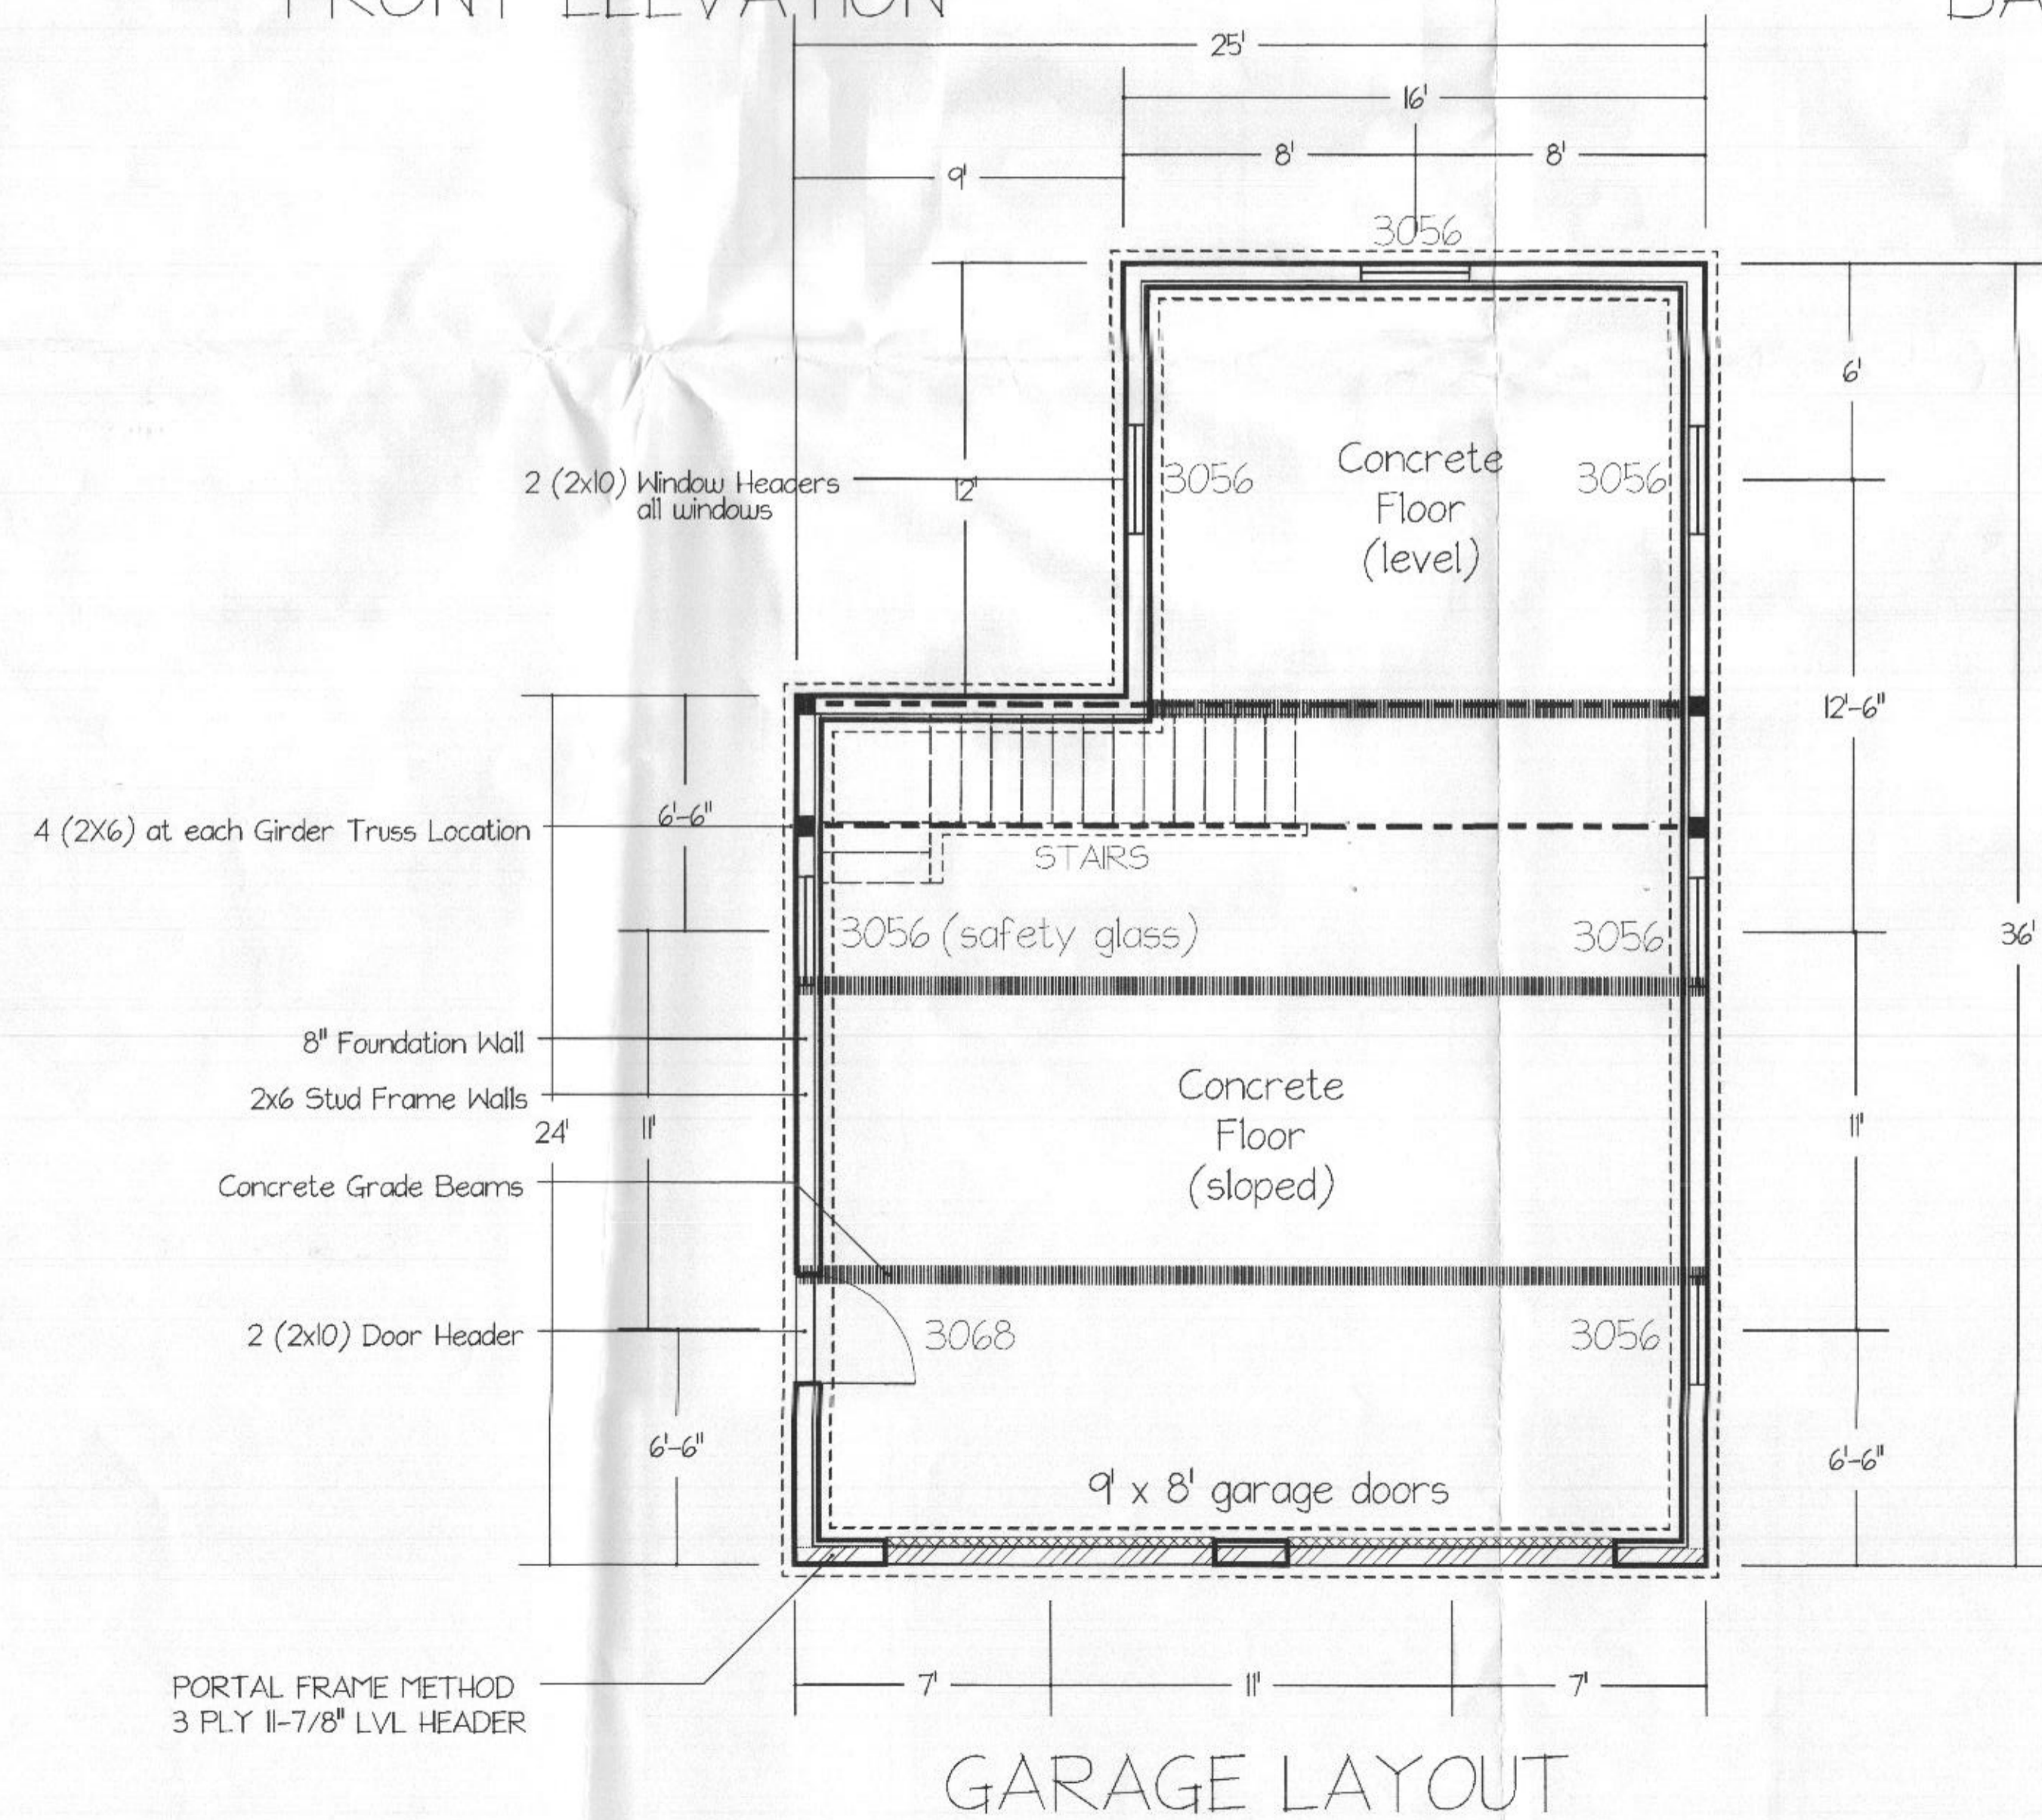

GARAGE LAYOUT

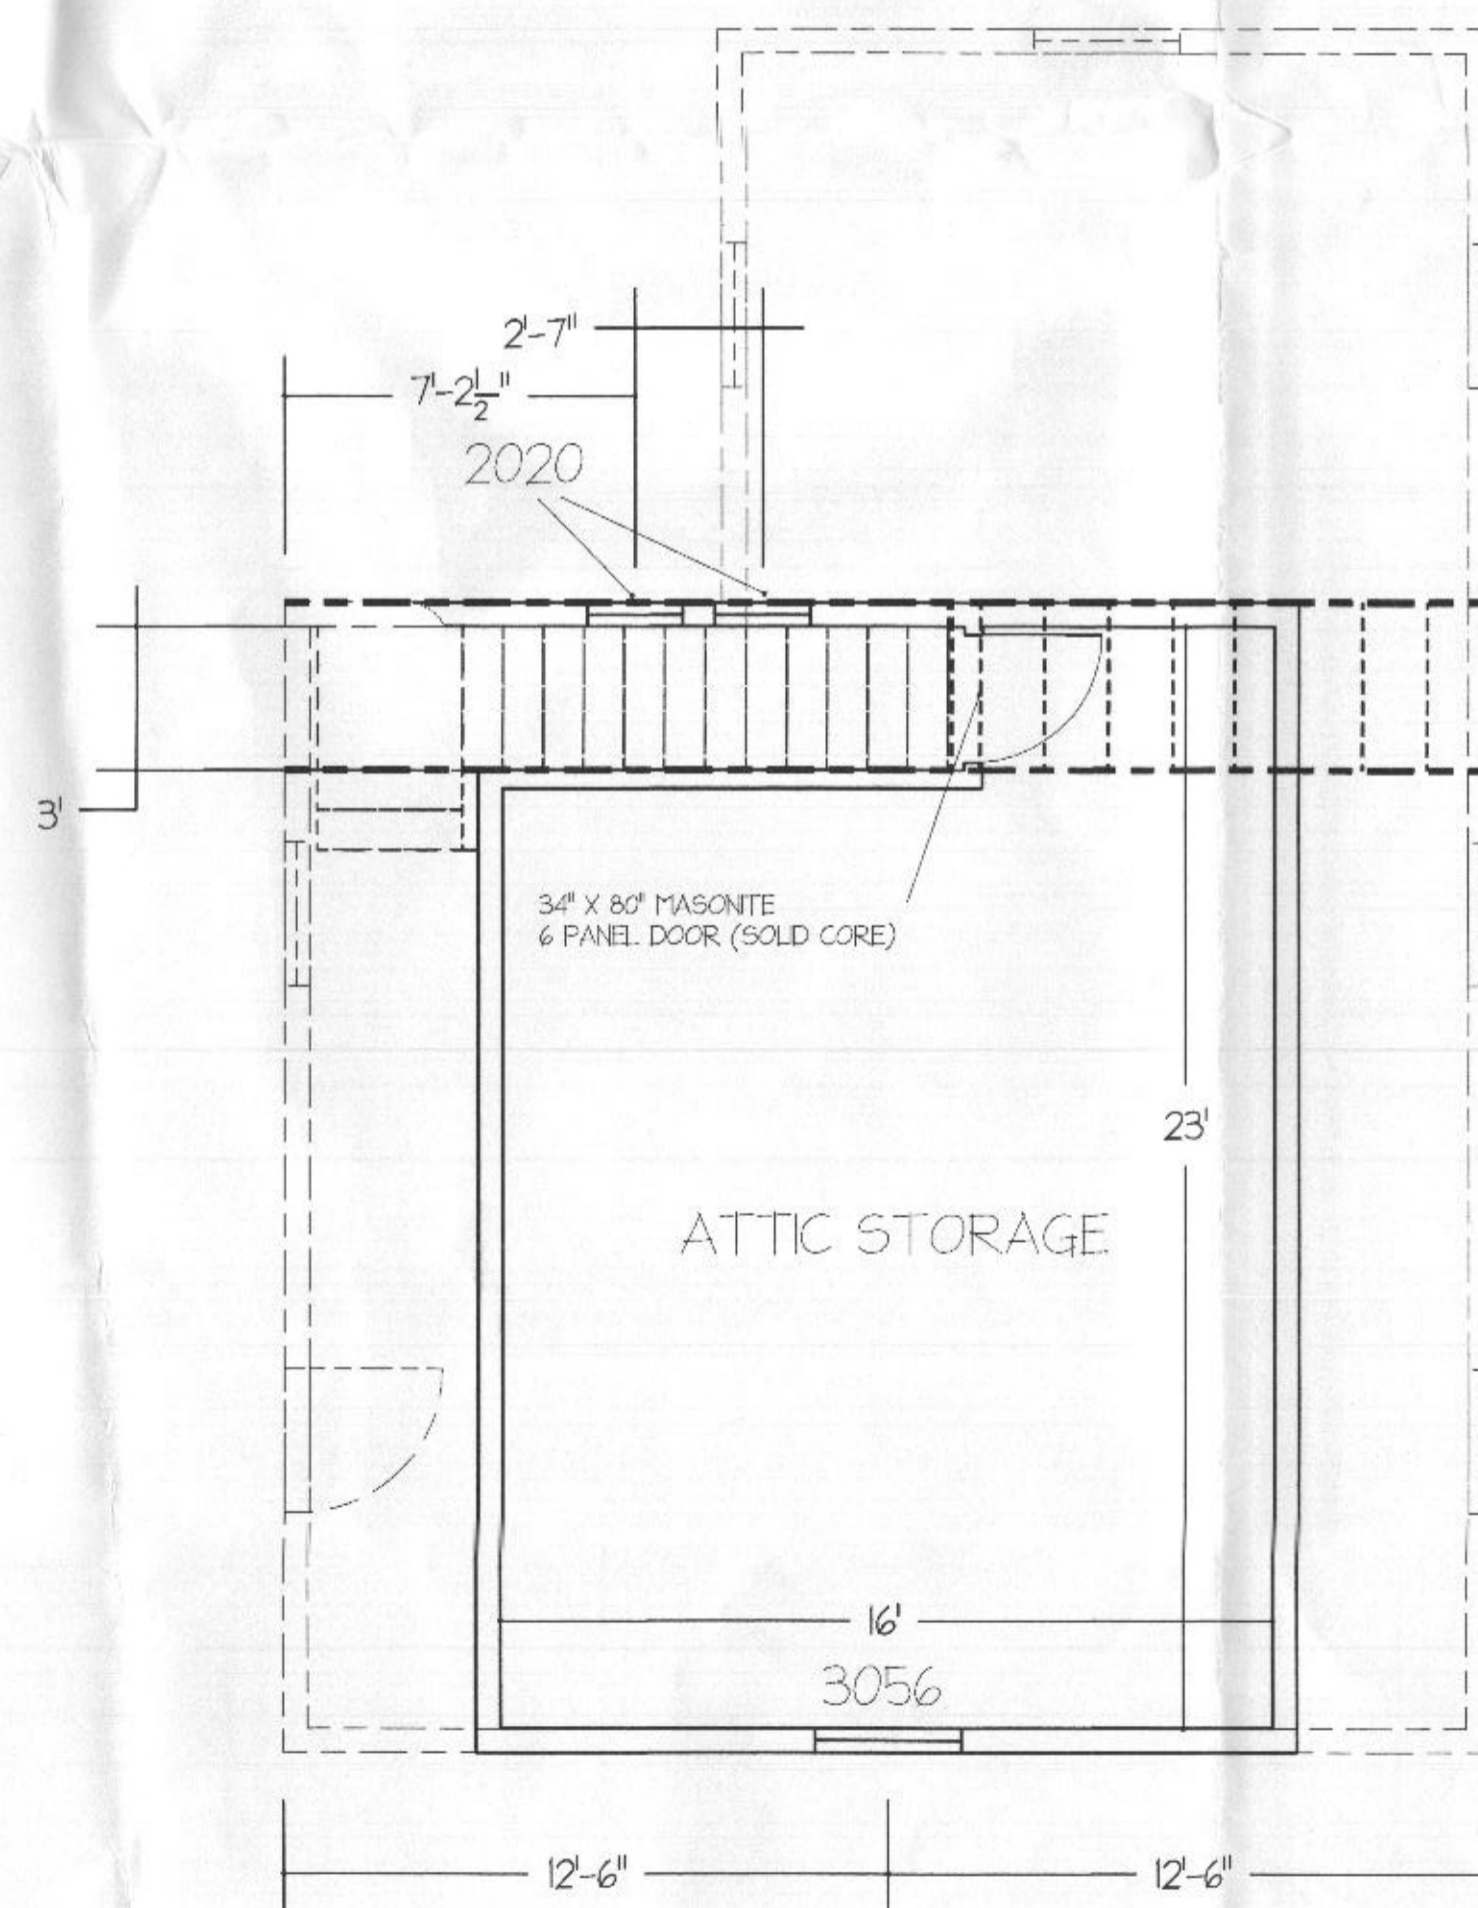

SECOND FLOOR

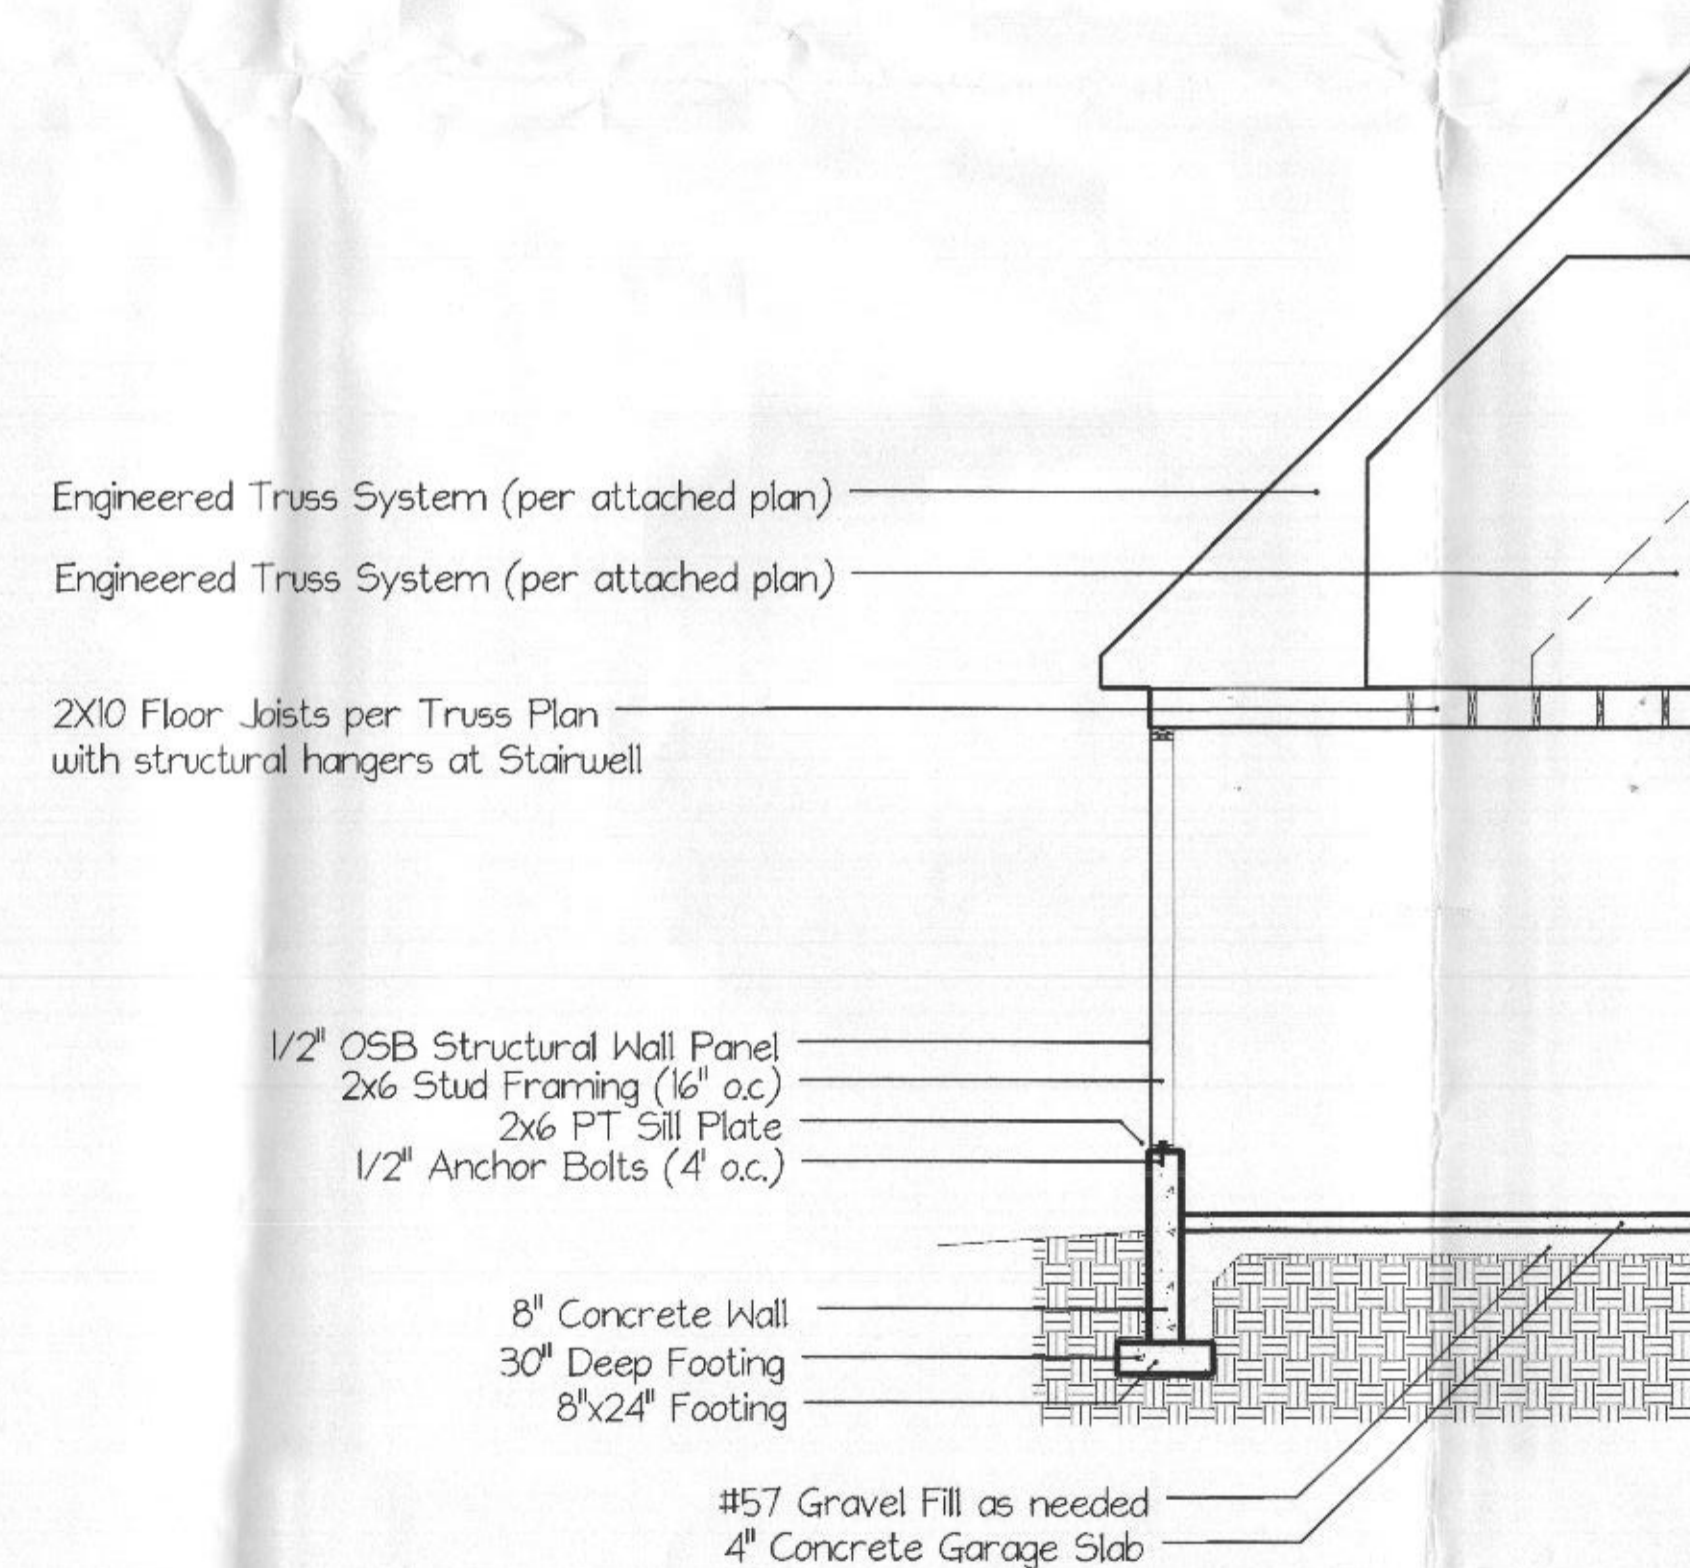

CROSS SECTION