

Maura J. Rossman, M.D., Health Officer

MEMORANDUM

Sent via email to besproketman@hotmail.com

TO: Brian E Smith

FROM: **Joseph Cabahug**
Licensed Environmental Health Specialist 001997
Howard County Health Department
Well & Septic Program

P 05/17/2021

DATE: May 17th, 2021

RE: **8079 Old Montgomery Road**
Ellicott City, MD 21043
M. 0037 G. 0002 P. 0024
(Demolition of existing House – Restore to Grass)

This is to advise that the Howard County Health Department recommends issuance of the demolition permit for the above referenced property.

A site inspection was made on 05/17/2021 to confirm works done.

On March 5th, 2021, the existing 6" drilled well was abandoned and sealed by Fogle's Well Drilling (Andrew Houseman MSD 224). The bore hole was sealed with 17 bags of bentonite from 70' below grade to grade. The well was serving a vestigial house (To Be Abandoned) on property, not the house built in 1999.

On March 10th, 2021, Fogle's Septic Clean Inc, abandoned and sealed the existing cesspool with clean fill pursuant to current local ordinance and state statute. The septic system was serving a vestigial house (To Be Abandoned) on property, not the house built in 1999.

IF ANY WELL OR SEPTIC COMPONENTS ARE FOUND DURING SITE WORK, YOU MUST NOTIFY THIS OFFICE IMMEDIATELY!!

JCC 001997

Cc: File

Maura J. Rossman, M.D., Health Officer

Demolition Request Form
 (Fill in all blanks)

Information of Property to be demolished:

Dale & Faith Smith 8079 Old Montgomery Road
 Current Owner's Name Property Address

Jade Estates 2
 Subdivision (if applicable) Lot #

John H. Smith Jr. 0037 0024 180215
 All Prior Owners' Names (if requested or known) Tax Map Parcel # Tax ID #

Original House which was replace by new primary residence
 Purpose/Reason for Demolition In 1999. The house is in very poor condition.

The demolished structure will be back filled and restored to grass.
 Future plans of property after demo (i.e. subdivision, parking lot, re-build new house, etc...)

If a subdivision, SDP# N/A Has the structure(s) been deemed unsafe by DILP YES NO

UTILITY RECORDS:

Property currently connected to public water ^{*}YES NO * connections are to current primary residence

Property currently connected to public sewer ^{*}YES NO There are no attachments to the structure to be demolished

Does the property currently have any wells and/or septic systems YES NO
 → Explain: Both existing well and septic were abandoned properly in March 2021. certificates are attached

*Note: Any wells and/or septic systems that are to remain may require an approved percolation certification plan under Howard County Code Sec. 3.805
 *Note: Any septic systems that are to be abandoned must be done by a septic contractor with documentation of the process.
 *Note: All abandoned wells are to be sealed by a well driller licensed by the Maryland State Board of Well Drillers COMAR Sec 26.04.04.11 Abandonment Standards D (3)

COMMENTS:

Brian E Smith (brother of owner) 443-864-8141
 Applicant's Name (please print) Applicant's Phone #

besprocketman@hotmail.com
 Applicant's Email Applicant's Fax #

Brian E Smith May 7, 2021
 Applicant's Signature Date

(revised 10-25-18 MJD)

MARYLAND DEPARTMENT OF THE ENVIRONMENT, WATER MANAGEMENT ADMINISTRATION
1800 Washington Blvd., Baltimore, Maryland 21230 (410) 537-3784

WATER WELL ABANDONMENT-SEALING REPORT FORM

SUBMIT COPIES OF COMPLETED FORM TO:

- * COUNTY ENVIRONMENTAL AGENCY (contact MDE, WMA if address needed)
- * WELL OWNER
- * MDE, WATER MANAGEMENT ADMINISTRATION, WELL PROGRAM

DATE WELL ABANDONED: 3-5-21 (month/day/year)

* PERMIT NUMBER OF ABANDONED WELL (if any) _____

- No tag

* PERMIT NUMBER OF REPLACEMENT WELL: _____


* PERSON ABANDONING WELL: Andrew Hausmann WELL DRILLER'S LICENSE NUMBER: 224

CIRCLE: MWD / MSD / MGD

* OWNER'S NAME: Brian Smith

SITE LOCATION MAP

* WELL LOCATION:
COUNTY: Hancock
NEAREST TOWN: Ellicott City
TAX MAP 0039 BLOCK 0002 PARCEL 0024
SUBDIVISION: Jade Estates
SECTION: _____ LOT: 2
STREET ADDRESS: 8079 Old Montgomery Rd.

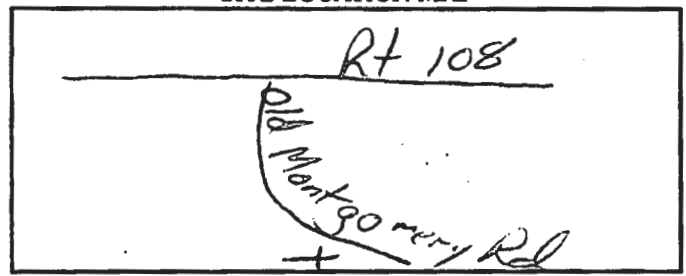

LATITUDE 39.213064

LONGITUDE 76.289332

LOG OF SEALING MATERIAL

* TYPE OF WELL BEING ABANDONED:
 DRILLED _____ JETTED
 BORED _____ HAND DUG
 OTHER (specify) _____

MATERIAL	FEET	
	FROM	TO
Bentonite	70	0

* USE CODE:
 DOMESTIC _____ MUNICIPAL/PUBLIC
 IRRIGATION _____ INDUSTRIAL
 TEST/OBSERVATION _____ GEOTHERMAL

VOLUME OF MATERIAL USED
Bentonite 8.50 lbs

* TYPE OF CASING:
 STEEL _____ PLASTIC
 CONCRETE _____ OTHER (specify) _____

SIZE OF CASING: 6 INCHES IN DIAMETER

DEPTH OF WELL: 70 FEET DEEP

WAS ANY CASING REMOVED? YES NO
If yes, length removed, in feet: _____

WAS CASING RIPPED OR PERFORATED? YES NO

SIGNATURE-MASTER WELL DRILLER OR SUPERVISING SANITARIAN LICENSE# _____

224

MWD MSD MGS 3-5-21
CIRCLE ONE DATE

DRILLER

Pursuant to § 10-624 of the State Govt. Article of the Maryland Code, personal info requested on this form is used in processing this form pursuant to COMAR 26.04.04. Failure to provide the info may result in this form not being processed. You have the right to inspect, amend, or correct this form. The Maryland Department of the Environment is subject to the Maryland Public Information Act. This form may be made available on the Internet via MDE's website and is subject to inspection or copying, in whole or in part, by the public and other governmental agencies, if not protected by federal or State Law.

Fogle's Septic Clean Inc.

Fogle's Portable Toilets • Fogle's Well Drilling LLC • Fogle's Excavating, LLC



March 11, 2021

Howard Co Dept of Environmental Health
8930 Stanford Blvd
Columbia, Md 21045

To whom it may concern,

On March 10th 2021 Fogle's Septic Clean Inc, crushed and filled in an cesspool with dirt located at 8079 Old Montgomery Rd for Brian Smith. They have been hooked up to public sewer.

If you have any questions please call me at the office 410-795-5670.

Sincerely,

Kurt Cassell
Fogle's Septic Clean, Inc.