


9/6/00

Test notes
not
found

88, 89, 90 & 91

SERIES
MISSING

A

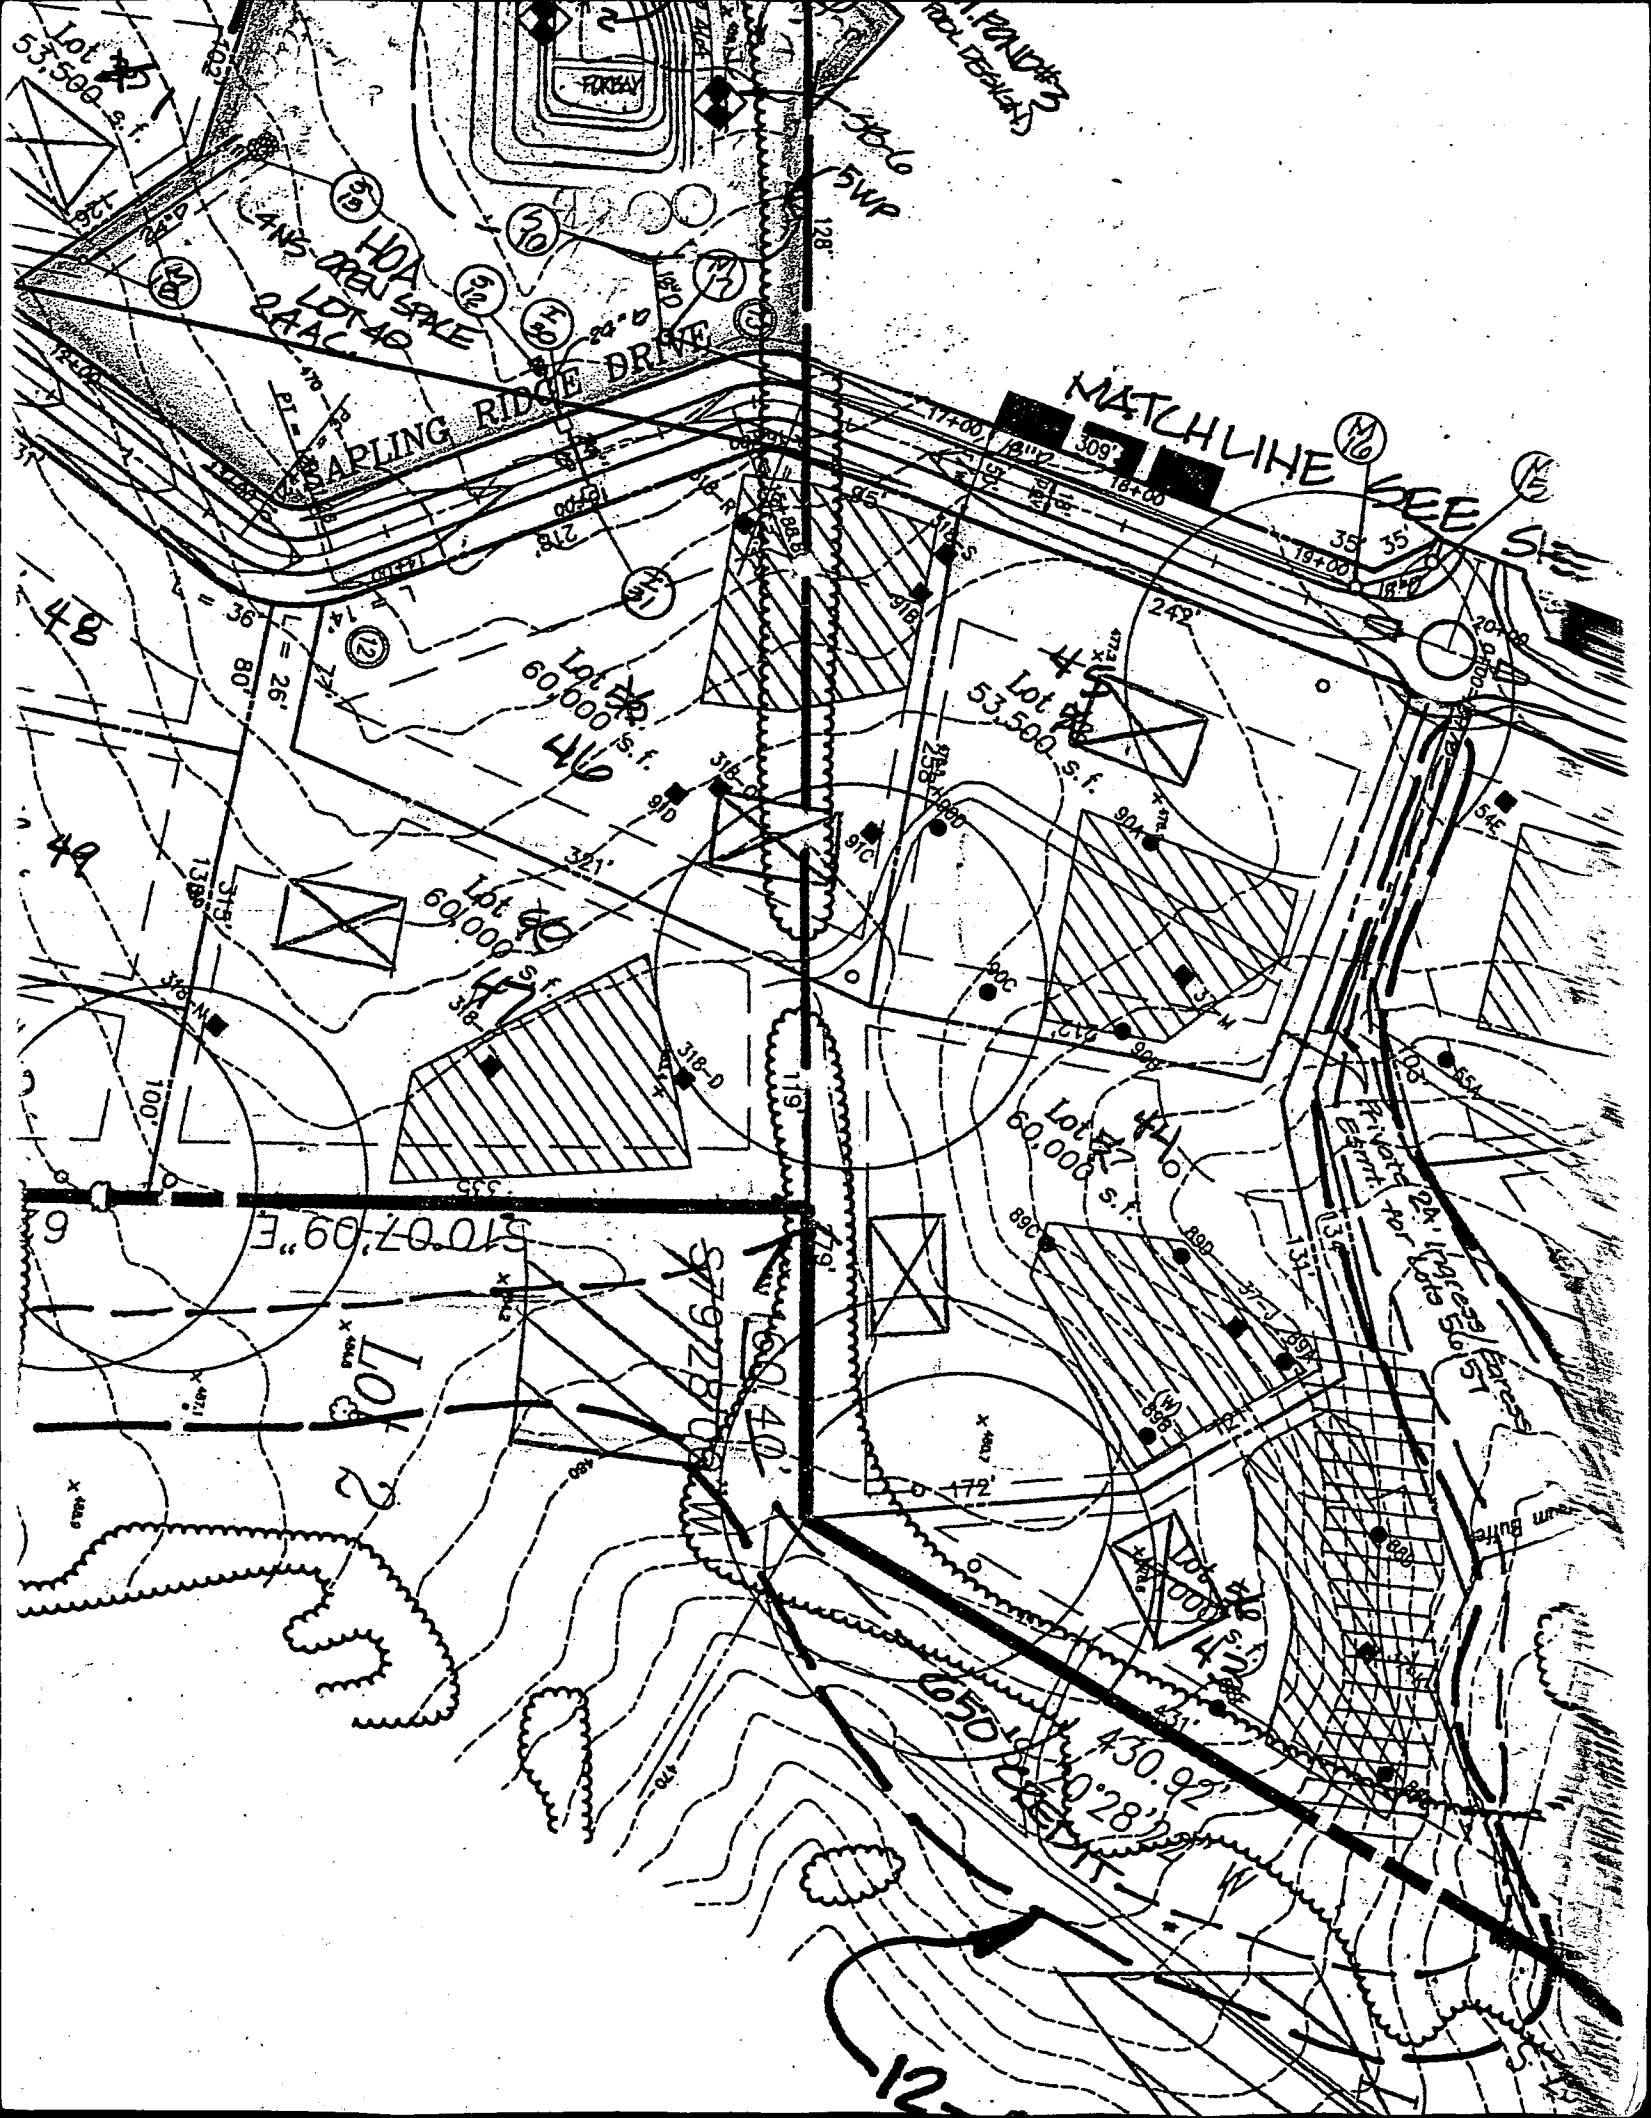

Lot 45
53,500 s.f.

LANE DRIVE
LOT 40
HOA
DRAC

CARLING RIDGE DRIVE

MATCHLINE SEE S...
309

Lot 46
60,000 s.f.

Lot 47
53,500 s.f.

Lot 48
60,000 s.f.

Lot 49
60,000 s.f.

100' 07" 09" E

LOT 2

928' 08" W

650' 10" 28' 28" W

12