



HOWARD COUNTY HEALTH DEPARTMENT

69510

DATE 5/17/24

PS

Received From

Freedom Septic Services

PHONE #

410-795-2944

For

Repair Septic - 1964

Brown Bridge Rd.

CASH

CHECK

NO.

4968

One hundred eighty four

Dollars

\$ 165.00

Received By

[Signature]

Maura J. Rossman, M.D., Health Officer

INFORMATION FORM - SEPTIC SYSTEM REPAIR/UPGRADE

Reason for Request:

- Failing System
- System relocation for proposed addition
- System upgrade for proposed addition
- Inadequate treatment zone
- Collapsed septic tank
- Collapsed drywell

Has the septic tank been pumped within the last month?

Yes _____
 No Date pumped: _____

Was a visual inspection of the septic tank and/or drain fields conducted?

Yes _____
 No Explain observation: _____

Existing system design

- Drywell
- Trench
- Mound
- Unknown
- Other: _____

Was a visual inspection of the sewage line conducted?

Yes _____
 No

Blockage Leading to the field

Yes _____ Explain _____
 No

Is discharge surfacing on the ground?

Yes
 No

Additional Comments:

perc done 4/9/21

*For REPAIRS, are the owners proposing, or do they plan to add in the future any additions or modifications to the property, i.e. pools, living space additions, garages, etc? This information must be disclosed at the time of this application. The Health Department will not be able to accommodate requests in the field for property modifications unrelated to the repair request. Such requests may require an additional fee, testing, and submittal of a Percolation Certification Plan, if the property does not meet current Code and Regulations.

Septic Contractor: Freedom Septic Contractor's Phone: 410-785-2847
 Contractor's Address: 2809 Liberty rd Sylkesville md 21784
 Property Address: 7164 Browns Blvd rd County File: _____
 Subdivision: 2001 Lot: _____ Year Built: 1990
 Owner's Name: Jennic Bait Existing bedrooms: 4
 Name of previous owners: _____ Existing bedrooms: _____
 Proposed bedrooms: _____

*A Sanitarian will be in contact within three business days, depending upon the urgency of the situation, to coordinate the scheduling/review of the repair or upgrade.

Prior to scheduling inspections, scaled plans should be submitted to clarify the nature of the addition.


Print out a copy of Real Property Data via Dept. of Taxation website _____ Indexed file found _____

If soil/site conditions are limited and sewer and/or Metro District status is not conducive to connection, the Sanitarian may recommend pursuit of Emergency Sewer Extension or Emergency Metro District Inclusion. The Owner should contact the Bureau of Utilities for details.

No permit is to be issued nor inspection to be scheduled without prior fee collection at the office unless an emergency exists.

The contractor is to notify the office of the emergency as soon as possible.

2/2020

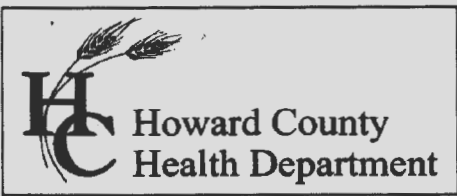

Bureau of Environmental Health
 8930 Stanford Boulevard, Columbia, MD 21045
 Main: 410-313-2640 | Fax: 410-313-2648
 TDD 410-313-2323 | Toll Free 1-866-313-6300
www.hchealth.org
 Facebook: www.facebook.com/hocohealth

Maura J. Rossman, M.D., Health Officer

RECEIPT DATE: 5/17/21 **ONSITE SEWAGE DISPOSAL SYSTEM** P 569510
 APPROVAL DATE: 5/25/21 (57) **PERMIT:** **REPAIR** A 568814
 PROPERTY ADDRESS: 7964 Browns Bridge Road
 SUBDIVISION: — LOT: — TAX ID: 05-355583
 CONTRACTOR: FREEDOM SEPTIC EMAIL: christy@freedomseptic.com
 CONTRACTOR ADDRESS: 2809 LIBERTY ROAD, SYKESVILLE, MD 21784 PHONE: 410-795-2947
 PROPERTY OWNER: Jennie Johnston EMAIL: _____
 OWNER ADDRESS: 7964 Browns Bridge Road, Highland, MD 20777 PHONE: _____

SEPTIC TANK SIZE (GALLONS): EXISTING PUMP CHAMBER CAPACITY (GALLONS): — PUMP SIZE: —
 NUMBER OF BEDROOMS: 4 HOUSE SQ. FT. — APPLICATION RATE: 1.2
 DISTRIBUTION SYSTEM: GRAVITY FED LOW PRESSURE DOSED

TRENCHES:	LINEAR FEET REQUIRED: <u>56'</u>	INLET DEPTH: <u>2.5'</u>
	TRENCH WIDTH: <u>3'</u>	MAXIMUM BOTTOM DEPTH: <u>8'</u>
	MINIMUM SPACE BETWEEN TRENCHES: <u>N/A</u>	EFFECTIVE AREA BEGINNING DEPTH: <u>3.5'</u>

LOCATION: **TO BE STAKED BY SANITARIAN DURING PRE-CONSTRUCTION INSPECTION.**


NOTES: INSTALL 1x 56' TRENCH ON CONTOUR

ISSUED BY: CABANOG 001997 ISSUE DATE: 06/14/2021 EXPIRATION DATE: 06/14/2022

- NOTE: CONTRACTOR MUST SCHEDULE A PRE-CONSTRUCTION INSPECTION PRIOR TO BEGINNING ANY INSTALLATION
- NOTE: CONTRACTOR MUST SCHEDULE AN INSPECTION AND GAIN APPROVAL OF ALL COMPONENTS PRIOR TO COVERING
- NOTE: STONE MUST BE APPROVED BY HEALTH DEPARTMENT AND GRAVEL TICKET MUST BE AVAILABLE FOR REVIEW.
- NOTE: WATERTIGHT SEPTIC TANKS REQUIRED
- NOTE: ALL PARTS OF SEPTIC SYSTEM SHALL BE AT LEAST 100 FEET DOWNGRADIENT FROM ANY WATER WELL
- NOTE: MANHOLE RISERS REQUIRED ON ALL SEPTIC TANKS AND PUMP CHAMBERS
- NOTE: AN ELECTRICAL PERMIT IS REQUIRED FOR INSTALLATION OF ANY ELECTRICAL COMPONENTS OF THE SYSTEM
 ELECTRICAL PERMIT ISSUED E —
- NOTE: THE HCHD DOES NOT WARRANTY ANY SYSTEM AND CANNOT GUARANTEE THE PERFORMANCE OF THIS SYSTEM AS DESIGNED. BY ACCEPTING THIS PERMIT, THE OWNER AND/OR APPLICANT ACKNOWLEDGE THAT THE SPECIFICATIONS DETAILED IN THIS DESIGN ARE ONE POSSIBLE OPTION AND THAT THE HCHD WILL REVIEW OTHER PROPOSALS. YOU HAVE THE OPTION TO SEEK THE ADVICE OF A QUALIFIED DESIGN CONSULTANT OR PROFESSIONAL ENGINEER FOR FURTHER GUIDANCE.
- NOTE: MDE RECOMMENDS SEPTIC TANKS, BAT, AND OTHER PRETREATMENT UNITS BE PUMPED AT A FREQUENCY ADEQUATE TO ENSURE THAT SOLIDS ARE NOT DISCHARGED TO THE DISPOSAL AREA

NEITHER THE HOWARD COUNTY COUNCIL NOR THE HEALTH DEPARTMENT IS RESPONSIBLE FOR THE SUCCESSFUL OPERATION OF ANY SYSTEM.
PERMITTEE RESPONSIBLE FOR OBTAINING FINAL APPROVAL ON THIS PERMIT.
CALL 410-313-1771 TO SCHEDULE INSPECTIONS.

NOT TO SCALE

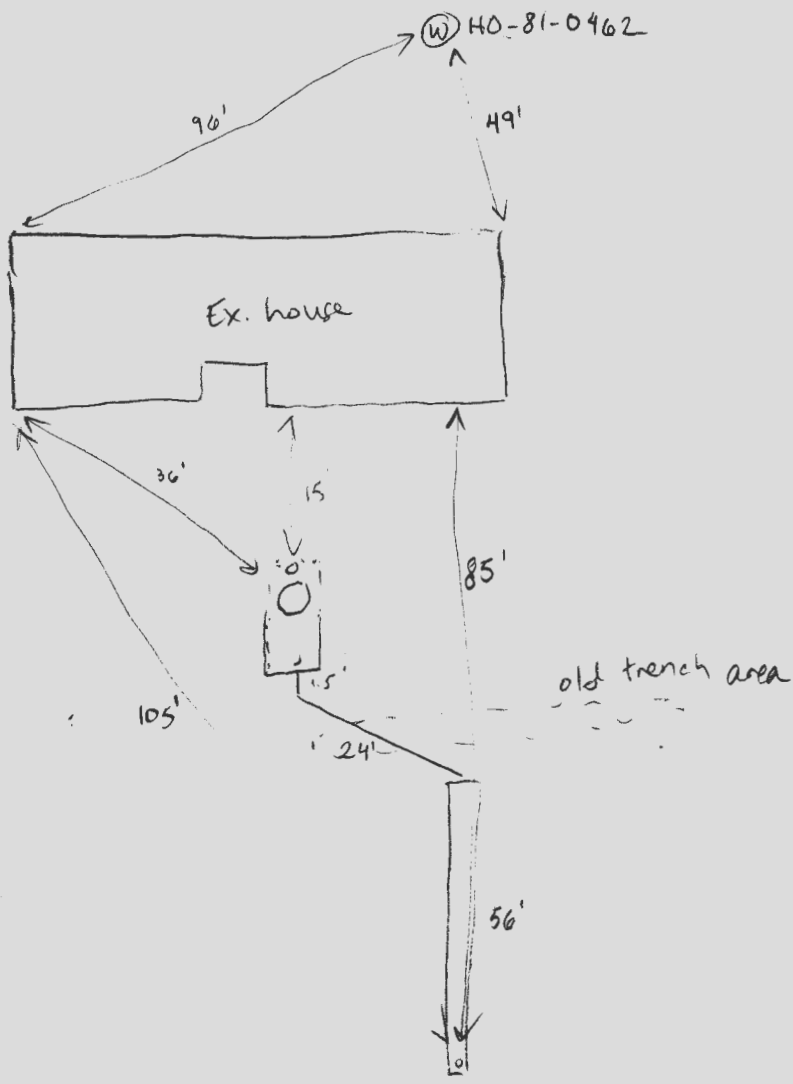

ROAD NAME

TRENCH/DRAINFIELD DATA

WIDTH	INLET	BOTTOM
3'	2.5'	8'
NUMBER OF TRENCHES <u>1</u>		
TOTAL LENGTH <u>56</u>		
ABSORPTION AREA <u>168 sq ft (sidewall)</u>		
DISTRIBUTION BOX LEVEL <u>N/A</u>		
DISTRIBUTION BOX BAFFLE <u>N/A</u>		
DISTRIBUTION BOX PORT <u>N/A</u>		

SEPTIC TANK DATA

SEPTIC TANK 1 LEVEL	
MANUFACTURER	<u>unknown</u>
CAPACITY	<u>Ex.</u> GAL
SEAM LOC	<u>midseam</u>
TANK LID DEPTH	<u>2.5'</u>
BAFFLES	<u>inlet + outlet (original)</u>
BAFFLE FILTER	<u>-</u>
MANHOLE LOC	<u>inlet</u>
6" PORT LOC	<u>inlet</u>
WATERTIGHT TEST	<u>-</u>
SLOTTED	<u>-</u>
DATE ON LID	<u>-</u>

PUMP/SEPTIC TANK LEVEL

MANUFACTURER	_____
CAPACITY	_____ GAL
SEAM LOC	_____
TANK LID DEPTH	_____
BAFFLES	_____
BAFFLE FILTER	_____
MANHOLE LOC	_____
6" PORT LOC	_____
WATERTIGHT TEST	_____
SLOTTED	_____
DATE ON LID	_____

PRE-CONSTRUCTION:

04/09/2021 COMPLETED PERC. LAID OUT 1 X 56' TRENCH. (P)

INSTALLATION: 5/25/21 1 X 56' trench constructed. Old trench abandoned. Riser added to inlet of tank. (S)

FINAL INSPECTOR

Austin Thomas

DATE OF APPROVAL

5/25/21