

Maura J. Rossman, M.D., Health Officer

RECEIPT DATE: 4/8/21 **ONSITE SEWAGE DISPOSAL SYSTEM** P 568846
 APPROVAL DATE: 5/6/21 *SD* **PERMIT:** **REPAIR** A _____
 PROPERTY ADDRESS: 13511 Mitchells Way
 SUBDIVISION: _____ LOT: _____ TAX ID: _____
 CONTRACTOR: Fogles Septic Clean Inc EMAIL: kim@foglesinc.com
 CONTRACTOR ADDRESS: 580 Obrecht Road, Sykesville, MD 21784 PHONE: 410-795-5670
 PROPERTY OWNER: Jeffrey Prophet EMAIL: _____
 OWNER ADDRESS: 13511 Mitchells Way, West Friendship, MD 21794 PHONE: 443-864-3015

SEPTIC TANK SIZE (GALLONS): 2000 (existing) PUMP CHAMBER CAPACITY (GALLONS): N/A PUMP SIZE: N/A
 NUMBER OF BEDROOMS: 4 HOUSE SQ. FT. 4,316 SF APPLICATION RATE: 1.2
 DISTRIBUTION SYSTEM: GRAVITY FED LOW PRESSURE DOSED

TRENCHES:	LINEAR FEET REQUIRED: <u>90</u>	INLET DEPTH: <u>2'</u>
	TRENCH WIDTH: <u>2'</u>	MAXIMUM BOTTOM DEPTH: <u>8'</u>
	MINIMUM SPACE BETWEEN TRENCHES: <u>10'</u>	EFFECTIVE AREA BEGINNING DEPTH: <u>4'</u>
LOCATION:	TO BE STAKED BY SANITARIAN DURING PRE-CONSTRUCTION INSPECTION.	
NOTES:	<i>Install 2x60' trenches below existing trenches to maximize area. Existing trenches to be abandoned (or kept w/ bull run valve if owner desires.)</i>	


ISSUED BY: Susan Thomas ISSUE DATE: 4/29/21 EXPIRATION DATE: 4/29/22

- NOTE: CONTRACTOR MUST SCHEDULE A PRE-CONSTRUCTION INSPECTION PRIOR TO BEGINNING ANY INSTALLATION**
- NOTE: CONTRACTOR MUST SCHEDULE AN INSPECTION AND GAIN APPROVAL OF ALL COMPONENTS PRIOR TO COVERING**
- NOTE: STONE MUST BE APPROVED BY HEALTH DEPARTMENT AND GRAVEL TICKET MUST BE AVAILABLE FOR REVIEW.**
- NOTE: WATERTIGHT SEPTIC TANKS REQUIRED**
- NOTE: ALL PARTS OF SEPTIC SYSTEM SHALL BE AT LEAST 100 FEET DOWNGRADIENT FROM ANY WATER WELL**
- NOTE: MANHOLE RISERS REQUIRED ON ALL SEPTIC TANKS AND PUMP CHAMBERS**
- NOTE: AN ELECTRICAL PERMIT IS REQUIRED FOR INSTALLATION OF ANY ELECTRICAL COMPONENTS OF THE SYSTEM**
 ELECTRICAL PERMIT ISSUED E _____
- NOTE: THE HCHD DOES NOT WARRANTY ANY SYSTEM AND CANNOT GUARANTEE THE PERFORMANCE OF THIS SYSTEM AS DESIGNED. BY ACCEPTING THIS PERMIT, THE OWNER AND/OR APPLICANT ACKNOWLEDGE THAT THE SPECIFICATIONS DETAILED IN THIS DESIGN ARE ONE POSSIBLE OPTION AND THAT THE HCHD WILL REVIEW OTHER PROPOSALS. YOU HAVE THE OPTION TO SEEK THE ADVICE OF A QUALIFIED DESIGN CONSULTANT OR PROFESSIONAL ENGINEER FOR FURTHER GUIDANCE.**
- NOTE: MDE RECOMMENDS SEPTIC TANKS, BAT, AND OTHER PRETREATMENT UNITS BE PUMPED AT A FREQUENCY ADEQUATE TO ENSURE THAT SOLIDS ARE NOT DISCHARGED TO THE DISPOSAL AREA**

NEITHER THE HOWARD COUNTY COUNCIL NOR THE HEALTH DEPARTMENT IS RESPONSIBLE FOR THE SUCCESSFUL OPERATION OF ANY SYSTEM.
PERMITTEE RESPONSIBLE FOR OBTAINING FINAL APPROVAL ON THIS PERMIT.
CALL 410-313-1771 TO SCHEDULE INSPECTIONS.

13511 Michells Way

NOT TO SCALE

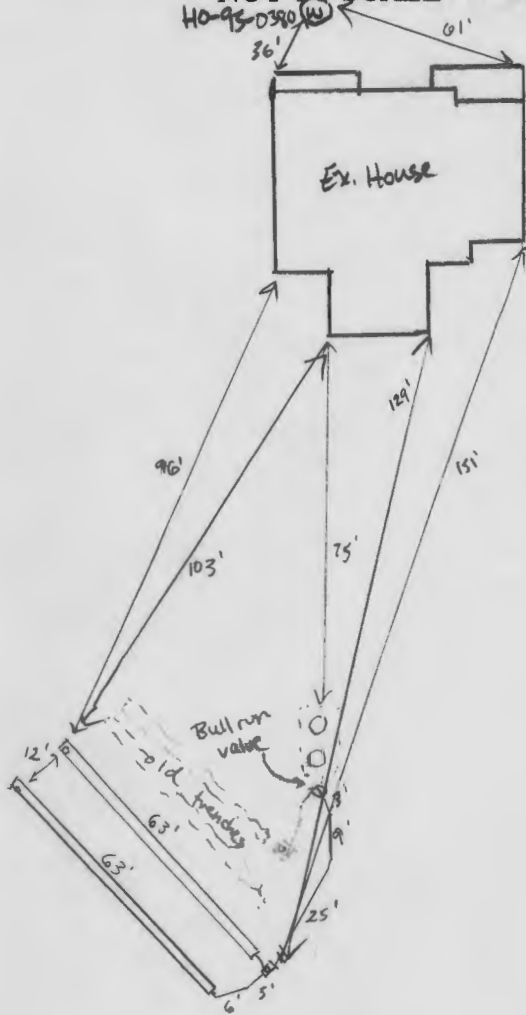

ROAD NAME

TRENCH/DRAINFIELD DATA

WIDTH	INLET	BOTTOM
2'	2'	8'
NUMBER OF TRENCHES		2
TOTAL LENGTH		126'
ABSORPTION AREA		378 sq ft + Sidewalk
DISTRIBUTION BOX LEVEL		yes
DISTRIBUTION BOX BAFFLE		yes
DISTRIBUTION BOX PORT		yes

SEPTIC TANK DATA

SEPTIC TANK 1 LEVEL	
MANUFACTURER	Babylon
CAPACITY	2000 GAL
SEAM LOC	top
TANK LID DEPTH	1.5'
BAFFLES	outlet ✓
BAFFLE FILTER	-
MANHOLE LOC	inlet + outlet
6" PORT LOC	-
WATERTIGHT TEST	-
SLOTTED	yes
DATE ON LID	-

PUMP/SEPTIC TANK LEVEL

MANUFACTURER	
CAPACITY	GAL
SEAM LOC	
TANK LID DEPTH	
BAFFLES	
BAFFLE FILTER	
MANHOLE LOC	
6" PORT LOC	
WATERTIGHT TEST	
SLOTTED	
DATE ON LID	

PRE-CONSTRUCTION:

Marked lot and 2x60' trenches on center. (ST)

INSTALLATION: 5/6/21 Installed 2x63' trenches and new d-box. Bull run valve used to keep old trenches and old d-box. New d-box leveled. (ST)

FINAL INSPECTOR

Sam Thomas

DATE OF APPROVAL

5/6/21



MITCHELLS WAY

MITCHELLS WAY

MITCHELLS WAY

146817

99

50

Bureau of Environmental Health

8830 Stamtortboulevard, Goldens, MD 22445
 Main: 410-313-2540 | Fax: 410-313-2548
 TDD: 410-313-2323 | Toll Free: 1-866-513-6300
 www.bhehealth.org
 Facsimile: www.bhehealth.org/hcphealth
 Twitter: @BPHHealth

Dr. Maria J. Roszman, M.D., Health Officer

INFORMATION FORM - SEPTIC SYSTEM REPAIR/UPGRADE

Has the septic tank been pumped within the last month? Yes No

Reason for Request: Routine System System relocation for proposed addition System upgrade for proposed addition Investigate incorrect zone Collapsed septic tank Collapsed drywell

Existing system design: Drywell Trench Mound Underway Other

Is discharge entering on the ground? Yes No

Biologics leading to the tank: Yes Explain: _____ No

Biologics leading to the field: Yes Explain: _____ No

Was a visual inspection of the septic line conducted? Yes No

Was a visual inspection of the septic tank and/or distribution fields conducted? Yes Explain observations: _____ No

Additional Comments: _____

Septic Contractor: Ecok's Sept. & Sewer Phone: 410.295.5670

Contractor's Address: 5801 Obryant Rd. Sykesville City: MD

Property Address: 13511 Mitchell's Way County: Harford

Subdivision: Clontarf Year Built: 2010

Owner's Name: Jerry Prophet Owner's Phone: 443.864.3015

Name of previous owners: _____

Existing buildings: _____

Proposed buildings: _____

Has this request been previously discussed with a Sanitarian? (Name): _____

Public Sewer available? _____

A Sanitarian will be in contact within three business days, depending upon the urgency of the situation, to coordinate the scheduling/transfer of the report or upgrade.

Plan to submit the report, sealed plan should be returned to clarify the nature of the problem.

Print out a copy of Real Property Data via Dept. of Taxation website.

Transfer necessary be ready, verify whether septic is technically "available" through the Bureau of Environmental Health.

It was established and the property is within the appropriate local, county, or state health department jurisdiction.

Escrow should be ready, the owner should justify the request in writing.

If both the contractor and the Sanitarian are not available to coordinate, the Sanitarian may recommend a transfer of jurisdiction to the County Health Department. The County should contact the Bureau of Environmental Health.

No permits to be issued and inspection to be scheduled without prior fee collection at the office unless an emergency situation exists.

The contractor is to notify owner of the emergency situation as soon as possible.