

**FOGLE'S SEPTIC CLEAN, INC.**  
 580 Obrecht Road • Sykesville • Maryland 21784  
 (410) 795-5670



# SEPTIC EVALUATION

<input type="checkbox"/> Buyer / <input type="checkbox"/> Seller	Date: Feb 19 Time: 9 AM	Occupied? <input type="checkbox"/> Yes / <input checked="" type="checkbox"/> No
Client: David Gibson	Ordered By: David Gibson	If vacant, how long? ?
Property Address: 3470 Daisy Rd Woodbmo 21797	Phone: 443 617 6534	Last pumped: Fogle's 9/17/08
	email: DGibson79@yc.how.com.	Property age: 1977
	Weather:	System age:
	Ground Conditions:	

Liquid level: <input type="checkbox"/> Above Normal / <input checked="" type="checkbox"/> Normal / <input type="checkbox"/> Below normal	Depth of tank: 18"
Maintenance Appears: <input type="checkbox"/> Good / <input checked="" type="checkbox"/> Fair / <input type="checkbox"/> Poor	Access to tank: 6" x 10"
Effluent Filter present? <input type="checkbox"/> Yes / <input checked="" type="checkbox"/> No	Pump system: <input type="checkbox"/> Yes / <input checked="" type="checkbox"/> No

Type of Tank	Tank Composition & Size	Type of Absorption System
<input checked="" type="checkbox"/> Septic Tank (1 tank) <input type="checkbox"/> Cesspool <input type="checkbox"/> Aeration System <input type="checkbox"/> Other:	<input type="checkbox"/> Metal <input checked="" type="checkbox"/> Concrete <input type="checkbox"/> Unknown Tank Size: 1000g Baffles intact? <input checked="" type="checkbox"/> Yes / <input type="checkbox"/> No	<input type="checkbox"/> Drainfield <input checked="" type="checkbox"/> Drywell <input type="checkbox"/> Sandmound <input type="checkbox"/> Other:

Inspected System Appears	Inspector's Comments	Sketch of System
<input checked="" type="checkbox"/> Functional <input type="checkbox"/> Marginal <input type="checkbox"/> Unsatisfactory	Septic tank is okay due to vacancy. System has good flow throughout. Drywell has approx 6' of liquid depth remaining.	
Inspector:		
Signature: K. Cassell		
Inspection Fee: 240 <sup>00</sup>		
Water Test: 200 <sup>00</sup>		
Amount Due:		
Date Paid:		
Check # CC		

**IMPORTANT:**

- This is a subjective and visual inspection only, based upon many unknown and unseen factors.
- The condition of the Sewage Disposal system is reported a of the above date.
- This report does not WARRANT nor GUARANTEE continued functional Sewage Disposal System operations.
- If house has been unoccupied, this report may not be accurate. Little or no use of the septic system could have allowed the problems to temporarily clear themselves.
- If a larger family is moving in than is presently occupying the house, the septic system may be subject to failure.
- If the general ground condition is wet, this report may not be accurate, as ground moisture may cover or hide actual septic effluent on the surface.
- In the above cases, it is strongly suggested that the septic system be re-certified in 3 to 6 months.
- If the system is rated below as marginal or unsatisfactory, it is suggested that the local health department be contacted to inspect and confirm the findings.

**Payment for this inspection signifies understanding and acceptance of above clauses.**

# COORDINATES

N°	NORTH	EAST
1	10642.810	4761.501
2	10945.122	4801.221
3	10607.068	5516.532
4	10492.849	5385.109
5	10377.596	5264.369
6	10414.831	5300.948

# CURVE DATA

NO.	RADIUS	LENGTH	Δ	TAN	CHORD BEARING
4-6	1790.00'	114.78'	03°40'26"	57.41'	S47°10'10"W - 114.76'
6-5	1790.00'	52.20'	01°40'15"	26.10'	S44°29'50"W - 52.20'
4-5	1790.00'	166.98'	05°20'41"	83.55'	S46°20'03"W - 166.92'


E4500  
N10250

NOTE: "REFUSE COLLECTION, SNOW REMOVAL, AND ROAD MAINTENANCE ARE PROVIDED TO THE JUNCTION OF THE PLUG OR PIPE STEM LOT DRIVEWAY."

NOTE: "MAINTENANCE OF ALL STORM DRAINS AND/OR DRAINAGE EASEMENTS SHOWN HEREON ARE THE RESPONSIBILITY OF THE PROPERTY OWNER, ITS SUCCESSORS AND ASSIGNS."

"MARION E. FROST PROPERTY"  
LOT 1  
PLAT BOOK 3465

"MARION E. FROST PROPERTY"  
LOT 3  
PLAT BOOK 3465

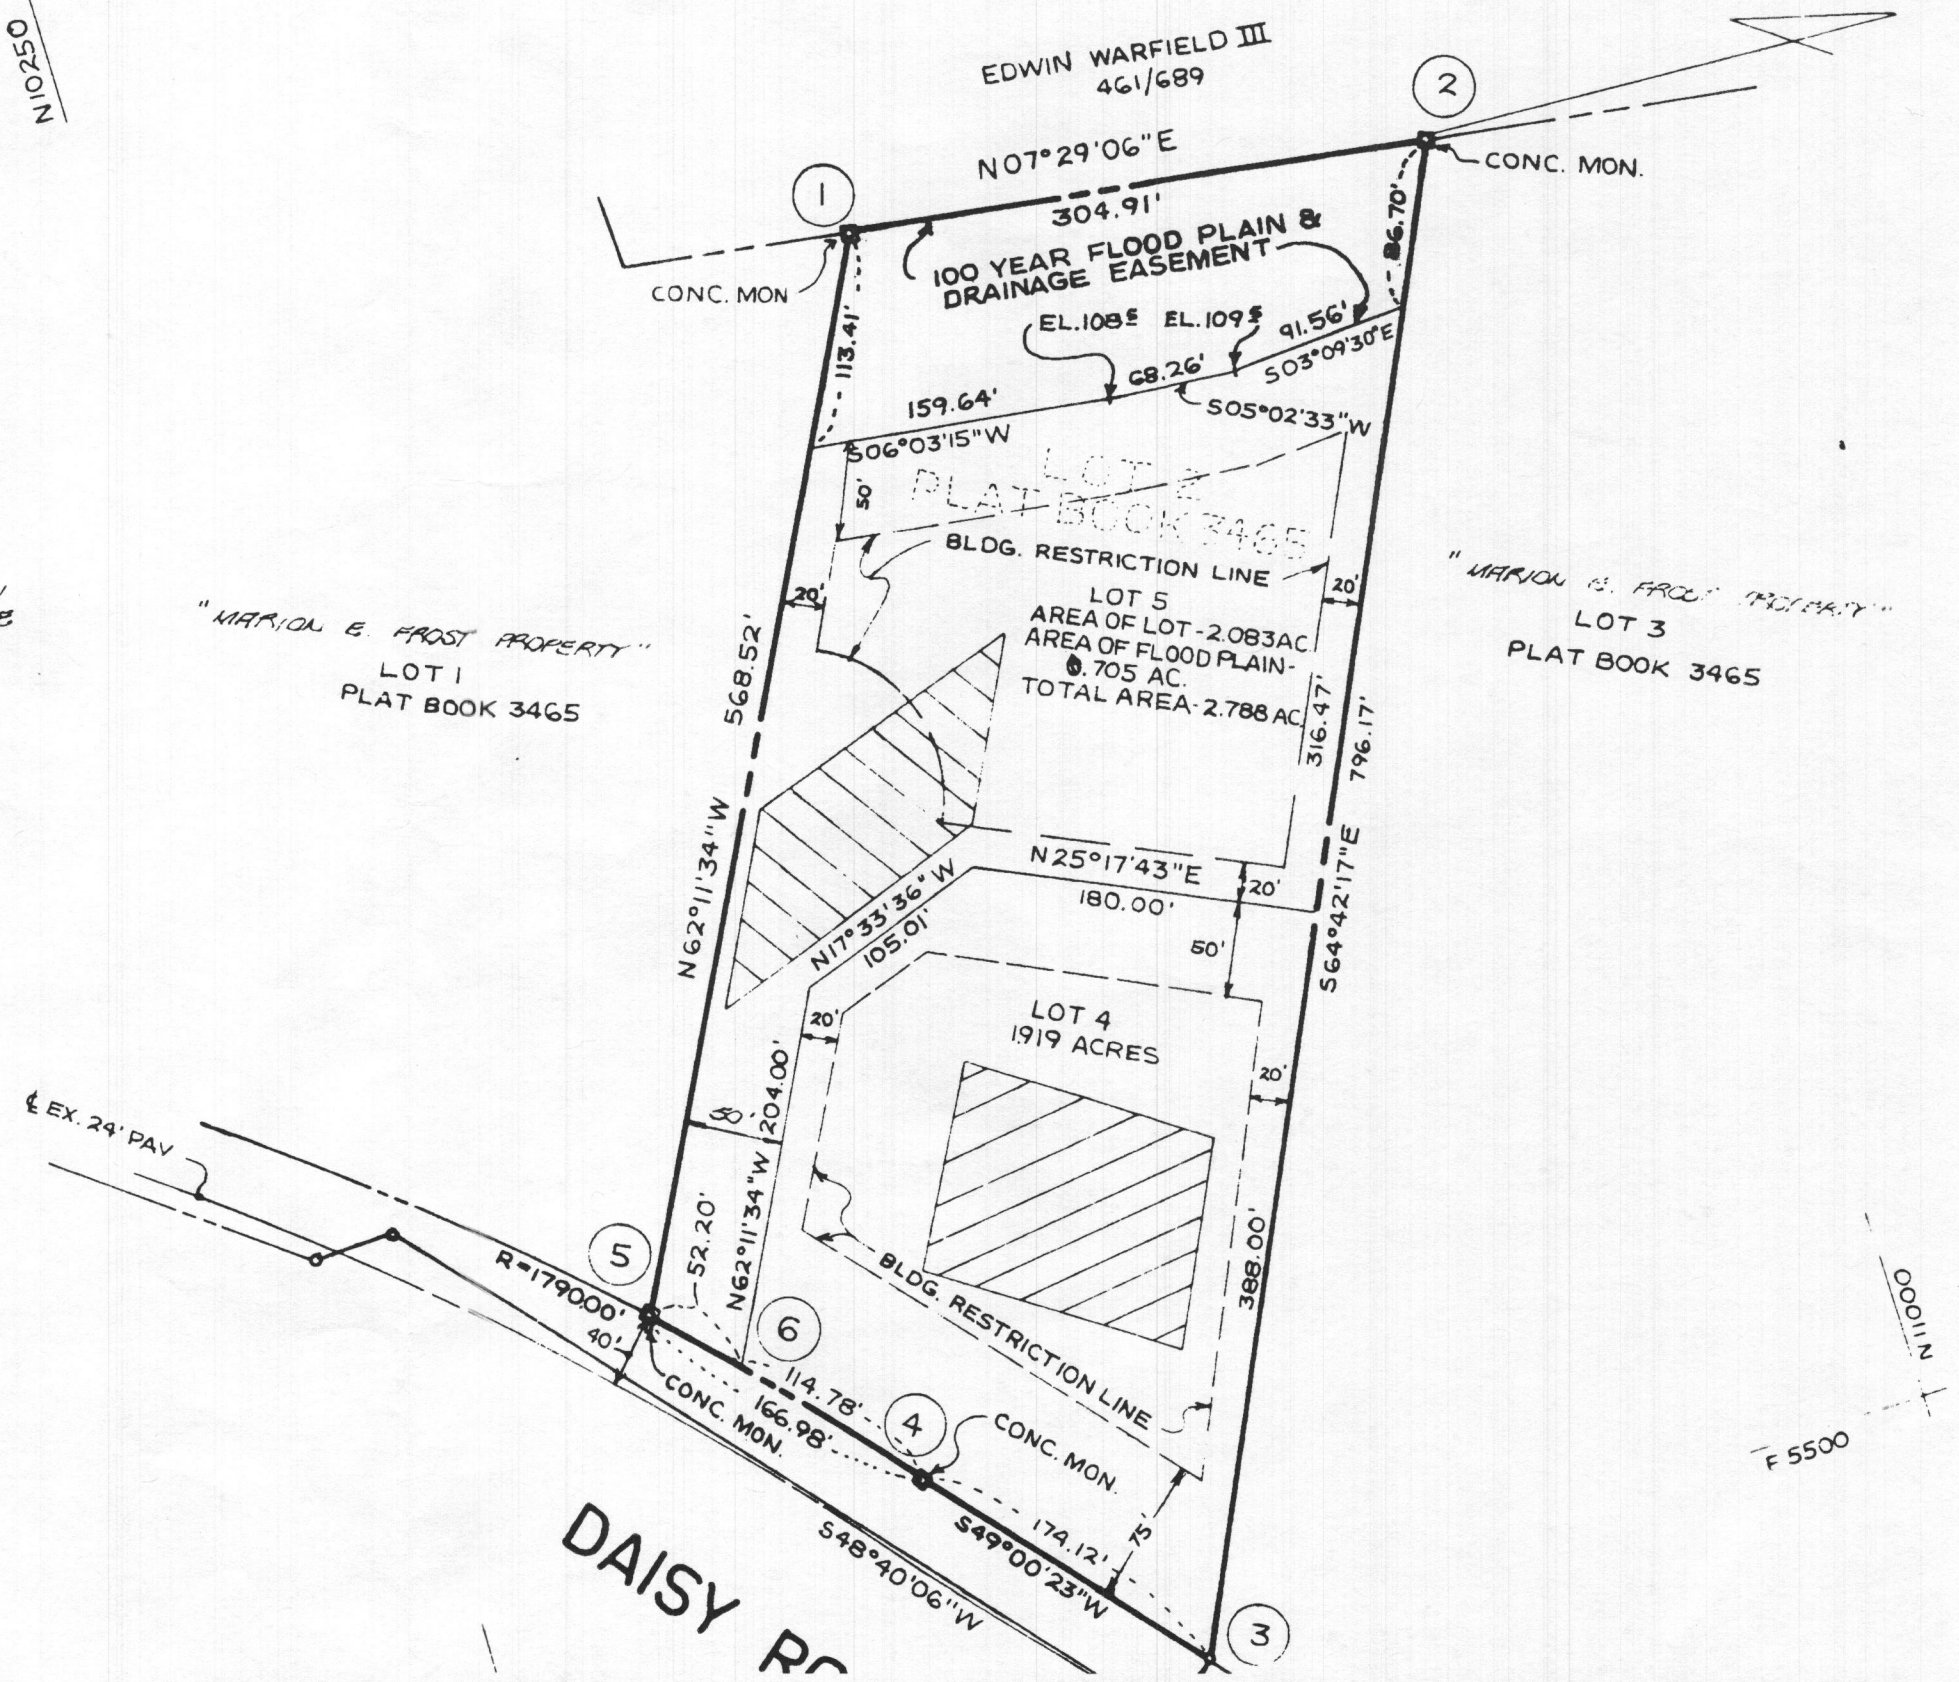

DAISY RD

1"=5500'