

Menu Save Reset Cancel Help

Record Detail * (This section is required.)

Permit Type	Permit Number	Opened Date
Building/Residential/Misc/Tanks	B20003716	10/27/2020
Description of Work		
SFD/ INSTALL (1) 500 GALLON UNDERGROUND PROPANE TANK		

check spelling

Address * (This section is required.)

Search Reset Clear Get Parcel & Owner

Approved 10/30/20
AIT

Street #	Street Name	Street Type	
1802	DAVIS BRANCH	RD	
Unit Type	Unit #	X Coordinate	Y Coordinate
--Select--		-76.87363	39.3189
City	State	Zip Code	Primary
WOODSTOCK	MD	21163	Yes

Parcel * (This section is required.)

Search Reset Clear Get Address & Owner

GIS ID *	Parcel	Parcel Area	Land Value	Improved Value	Exemption Value	Plan Area
926365	225,287	1.19	104400	104400	0	RURAL
Legal Description						
LOT 9 1.095 A[]1802 DAVIS BRANCH ROAD[]MYRTUE PROPERTY INCL RSB						

check spelling

Block	Lot	Census Tract	Council Dist	Inspection Dist	Supervisor Dist	Map #	DAP Zone
	9	603000	5	6			
Plan Area	State Tax Id		Subdivision Name				
	1403352412		Myrtue Property				
Section	Area		Tax Map				
			10				
Grid	Zoning District		ADC Map				
10-24	RC-DEO		4695-A9				
SDP No.	Final Plan No.		WP File No.				
	F-06-104						
Record Plat No.	WS Contract No.		FDP No.		Primary		
19961-1996					Yes		
Owner Occupied	Year Built		Historic District				
<input type="radio"/> Yes <input checked="" type="radio"/> No			<input checked="" type="radio"/> Yes <input type="radio"/> No				
Historic District Registry No.	Stat Area		Flood Plain				
	3-02A		<input type="radio"/> Yes <input checked="" type="radio"/> No				
Building No							

Owner * (This section is required.)

Search Reset Clear

Name *

Chandrasekher Kondur

Address Line 1
1802 Davis Branch Road

Address Line 2

Address Line 3

Mail City Mail State Mail Zip Code
Woodstock MD 21163

Phone Primary
646-919-7999 Yes

E-mail
kondur.chandra@gmail.com

Cell Number Fax Number

Professionals (This section is not required.)

Search Reset Clear

License # * Business Name
20100072302 SUBURBAN PROPANE LP.

License Type * First Name Middle Name Last Name
Propane Gs RANDALL SCOTT HIERONIMUS

Primary Address Line 1
No 240 ROUTE 10 WEST

Address Line 2
ROUTE 10 WEST

City State ZIP Code
WHIPPANY NJ 07981-0000

Phone 1 Phone 2 Fax
4108331400 4108618435

E-mail
RHIERONIMUS@SUBURBANPROPANE.COM

Applicant (This section is not required.)

Search As Owner As Lic. Prof As Contact

Type * First Name MI Last Name
Applicant RANDALL SCOTT HIERONIMUS

Relationship Full Name
--Select--

Primary Organization Name
Yes SUBURBAN PROPANE LP.

Street Address
240 ROUTE 10 WEST

Address Line 2
ROUTE 10 WEST

City State Zip Code
WHIPPANY NJ 07981-0000

Phone Cell Fax
4108331400 4108618435

E-mail *
RHIERONIMUS@SUBURBANPROPANE.COM

Addtl Info

Est Construction Cost *	Housing Units *	Number of Buildings *	Public Owned
10000	0	0	No
Construction Type			
-Select-			

TANK INFORMATION


RESIDENTIAL TANK INFORMATION

Capital Project-No Fee *	Capital Project Number	Fee Exempt *	Roadside Tree Project Permit *	Roadside Tree Permit #
<input type="radio"/> Yes <input checked="" type="radio"/> No		<input type="radio"/> Yes <input checked="" type="radio"/> No	<input type="radio"/> Yes <input checked="" type="radio"/> No	
Existing Use	Number of Tanks Installed *	Number of Tanks Removed *		
SFD	1	0		
Water Supply	Sewage Disposal	Expiration Date	Relocate Existing Tank *	
Private	Private	4/27/2021	0	

PAYMENT INFORMATION

Check 1	Payee 1	Check 2	Payee 2	SAP Doc No	SAP Entered

Submit Cancel

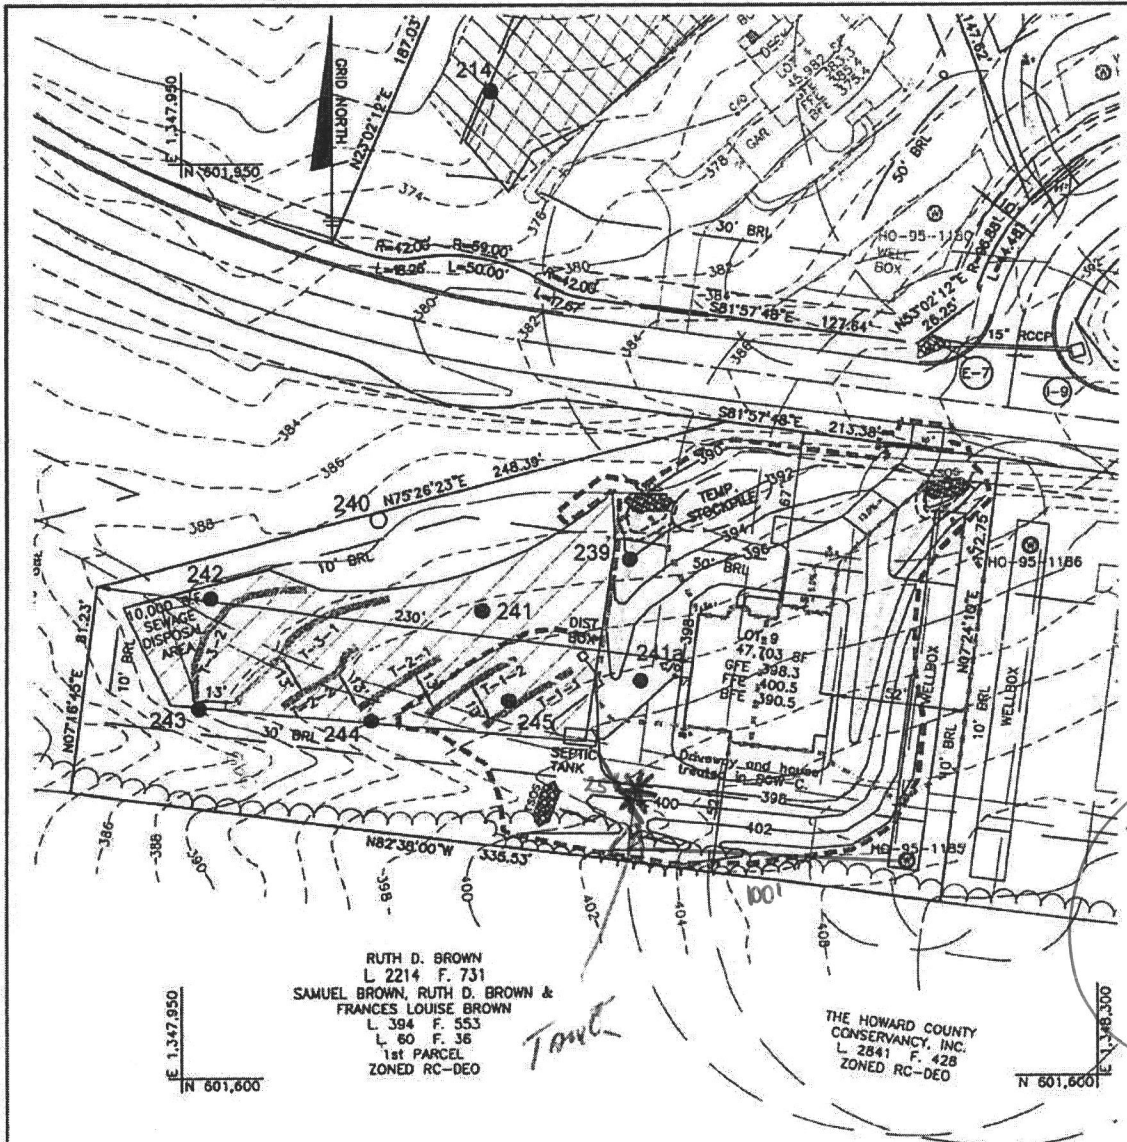

LEGEN

- PRO 400
- EXIS 398
- EXIS 400
- EXIS 398
- PROF SEW
- EXIS SEW
- PROF
- EXIS
- Mac
- SOILS
- PERC 1
- PERC 2

NOTE: LOT 9
PUMP REQ'D

Approved for
LP tank
B 20003716
Att 10/30/20

OWNER/BUILDER:

KEYSTONE CUSTOM I
 227 GRANITE RI
 SUITE 10C
 LANCASTER, PA
 717-464-91

BENCHMARK


ENGINEERS & LAND SURVEYORS
 ENGINEERING,
 8450 BALTIMORE NATIONAL PIKE
 ELLICOTT CITY, MARYLAND
 (P) 410-485-8105 A (F) 410-

WWW.BEL-CVLENGINEERING

PLAN VIEW

1" = 50'

NOTE: THE STORMWATER MANAGEMENT FOR LOT 9 IS PROVIDED IN SGW-C AND WAS PREPARED AND APPROVED UNDER THE F-06-104 STORMWATER MANAGEMENT PLAN.

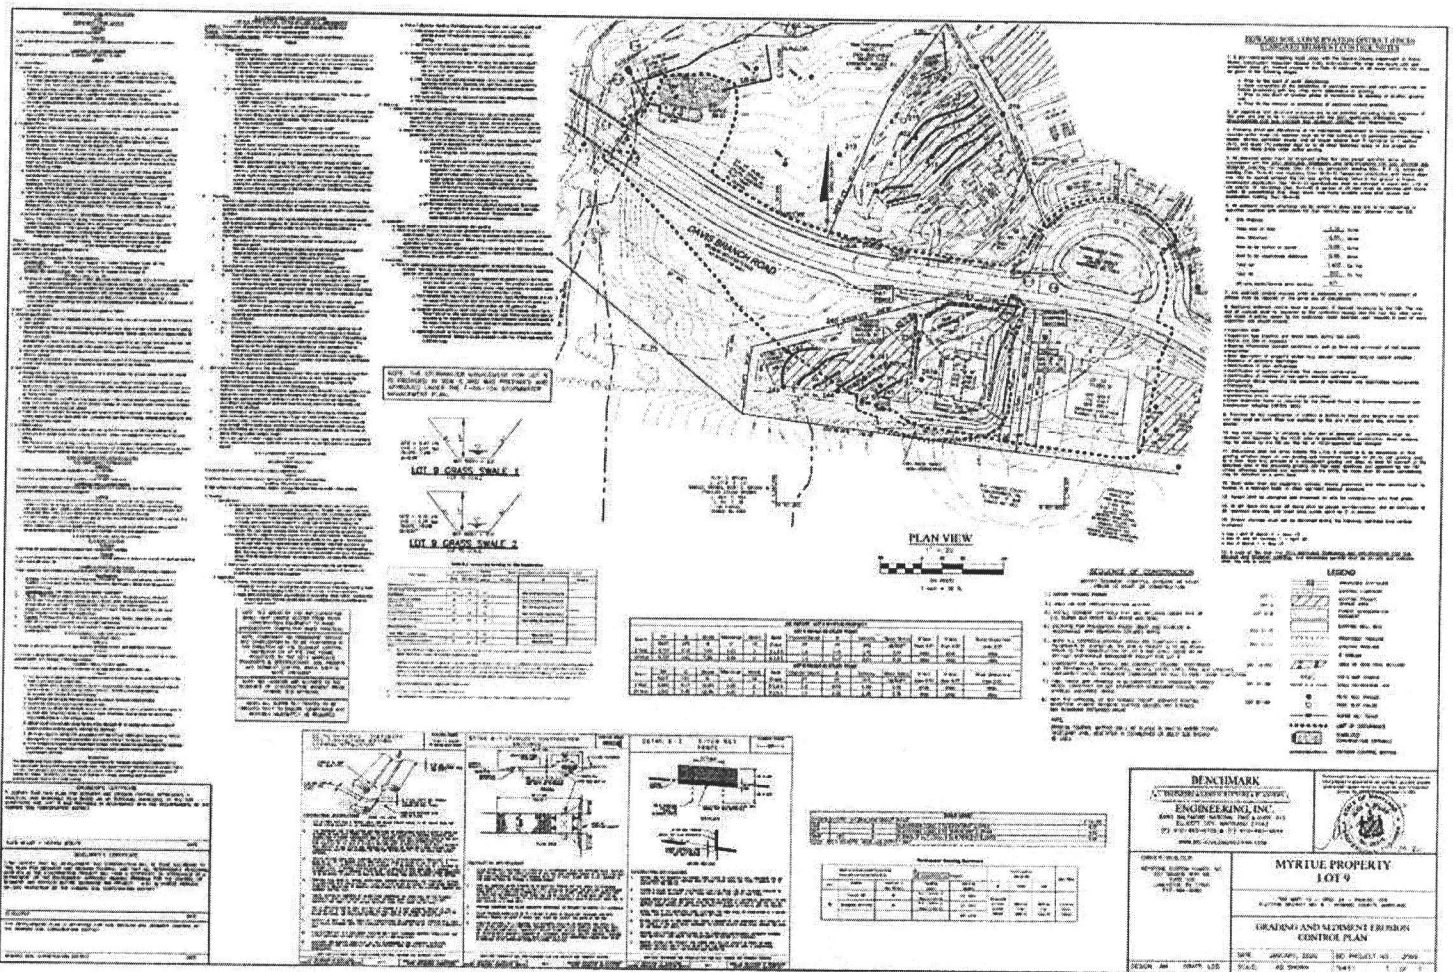


NOTES:

1. All elevations are in feet above mean sea level.
2. The proposed grading shall be in accordance with the attached grading schedule.
3. The proposed drainage system shall be in accordance with the attached drainage schedule.
4. The proposed catch basins shall be in accordance with the attached catch basin schedule.
5. The proposed paving shall be in accordance with the attached paving schedule.
6. The proposed landscaping shall be in accordance with the attached landscaping schedule.
7. The proposed utility lines shall be in accordance with the attached utility schedule.
8. The proposed site work shall be in accordance with the attached site work schedule.
9. The proposed construction shall be in accordance with the attached construction schedule.
10. The proposed maintenance shall be in accordance with the attached maintenance schedule.

GRADING SCHEDULE:

Station	Proposed Elevation	Existing Elevation	Grade
1+00	100.00	100.00	0.00%
2+00	100.00	100.00	0.00%
3+00	100.00	100.00	0.00%
4+00	100.00	100.00	0.00%
5+00	100.00	100.00	0.00%
6+00	100.00	100.00	0.00%
7+00	100.00	100.00	0.00%
8+00	100.00	100.00	0.00%
9+00	100.00	100.00	0.00%
10+00	100.00	100.00	0.00%

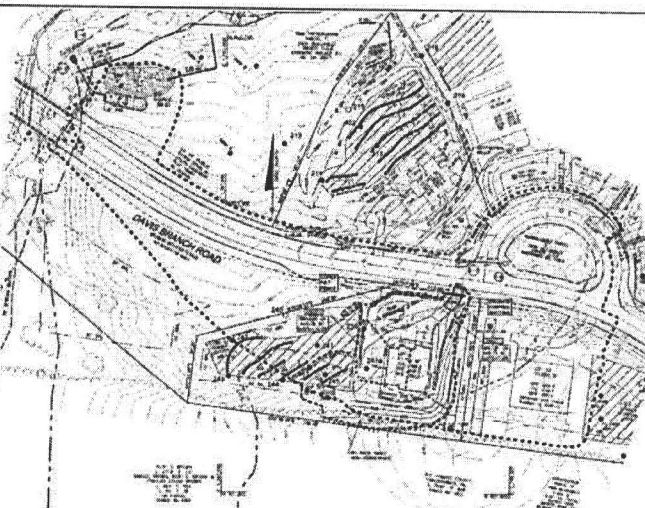

REVISIONS:


No.	Description
1	Initial design
2	Revised grading and drainage
3	Final design

LEGEND:

- Proposed Grading
- Existing Grading
- Proposed Drainage
- Existing Drainage
- Proposed Catch Basins
- Existing Catch Basins
- Proposed Paving
- Existing Paving
- Proposed Landscaping
- Existing Landscaping
- Proposed Utility Lines
- Existing Utility Lines
- Proposed Site Work
- Existing Site Work
- Proposed Construction
- Existing Construction
- Proposed Maintenance
- Existing Maintenance

PROPOSED DRAINAGE SCHEDULE:

Station	Proposed Elevation	Existing Elevation	Grade
1+00	100.00	100.00	0.00%
2+00	100.00	100.00	0.00%
3+00	100.00	100.00	0.00%
4+00	100.00	100.00	0.00%
5+00	100.00	100.00	0.00%
6+00	100.00	100.00	0.00%
7+00	100.00	100.00	0.00%
8+00	100.00	100.00	0.00%
9+00	100.00	100.00	0.00%
10+00	100.00	100.00	0.00%

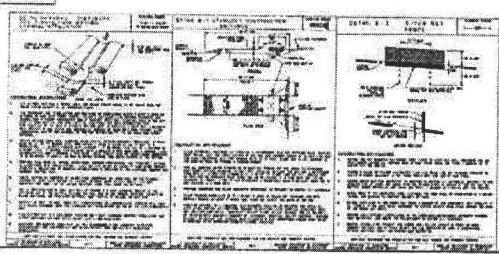

PROPOSED PAVING SCHEDULE:

Station	Proposed Paving	Existing Paving
1+00	Asphalt	Asphalt
2+00	Asphalt	Asphalt
3+00	Asphalt	Asphalt
4+00	Asphalt	Asphalt
5+00	Asphalt	Asphalt
6+00	Asphalt	Asphalt
7+00	Asphalt	Asphalt
8+00	Asphalt	Asphalt
9+00	Asphalt	Asphalt
10+00	Asphalt	Asphalt

BENCHMARK ENGINEERING, INC.

1000 N. W. 10th Ave., Suite 100
 Fort Lauderdale, FL 33304
 Phone: (954) 571-1111
 Fax: (954) 571-1112
 www.benchmarkeng.com

MYRTLE PROPERTY LOT 9

GRADING AND DRAINAGE CONTROL PLAN

DATE: JANUARY, 2006
 SCALE: AS SHOWN
 SHEET NO. 1 OF 2
 DESIGNER: [Signature]