

1
A-111b
ALT. KITCHEN 2
SCALE: 1/8" = 1'-0"
WEL346A111

File No: WEL346A111.dwg



lessard
DESIGN

8521 Leesburg Pike
Suite 706 | Vienna, VA 22182
P: 571.530.1800 | F: 571.830.1801
www.lessarddesign.com

SMA & STRUCTURE:

Professional Certification:
I hereby certify that these documents were prepared or approved by me and that I am a duly licensed professional architect under the State of Virginia. License No.: 22046 Expiration Date: 12/31/2014

Client:
The Williamsburg Group
2425 Upper Forest
Suite 200
Farmingdale, NY 11735
413-627-8880

CONSULTANTS:
STRUCTURAL
KSU ENGINEERING
400 SOUTH STREET
TIMEBURG, PA 15083
412-844-2221


Single Family Homes
Howard County, MD
The Williamsburg Group
GEORGETOWN II

FLOOR PLANS

NO.	DESCRIPTION	DATE
5	ISSUE FOR PERMIT	04/22/15
4	FIELD REVISIONS	04/24/15
3	CLIENT REVISIONS	04/24/15
2	CLIENT REVISIONS	04/13/15
1	CLIENT REVISIONS	04/13/15
	ISSUE FOR PERMIT	04/09/15
NO.	DESCRIPTION	DATE


PROJECT NO: WEL346A111
 FILE NAME: WEL346A111.dwg
 DRAWN BY:
 CHECKED BY:
 PLOT DATE:

A-111b

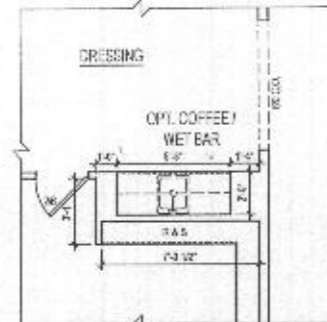


*Second Floor
4 bedrooms*


3 ALT. DRESSING w/ OPT. COFFEE/ WET BAR
SCALE: 1/4" = 1'-0"
WLS04412

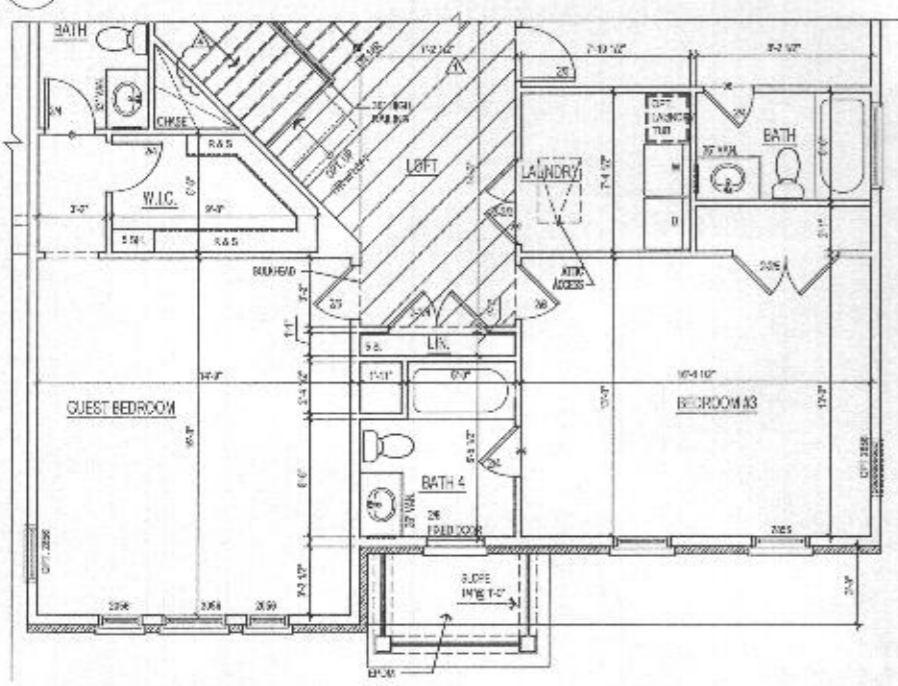

7a ALT. SECOND FLOOR PLAN
SCALE: 1/4" = 1'-0"
ELEVATION 4
WLS04412

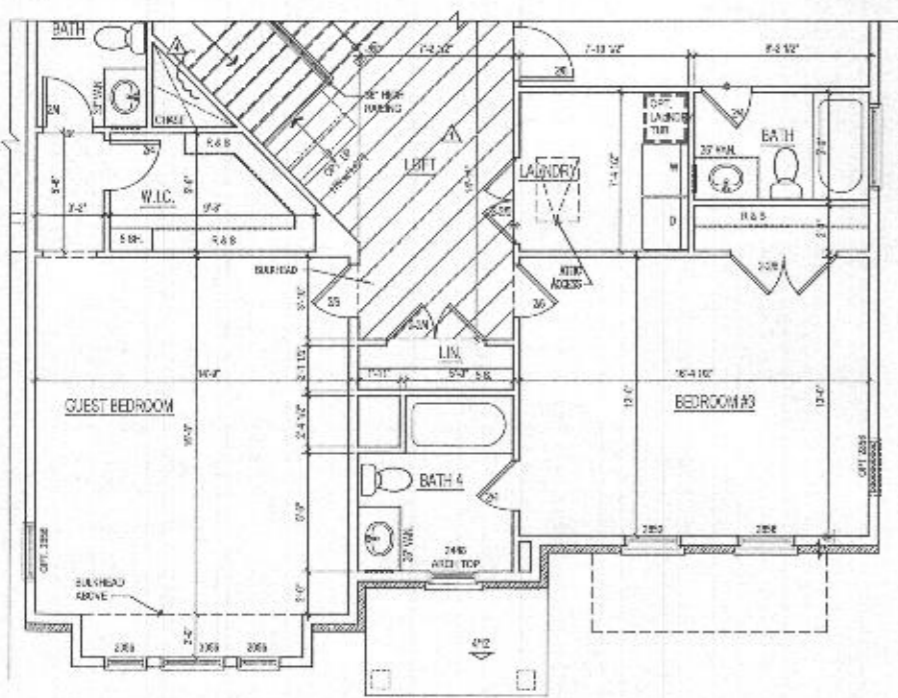

2 ALT. SECOND FLOOR PLAN
SCALE: 1/4" = 1'-0"
ELEVATION 4
WLS04412

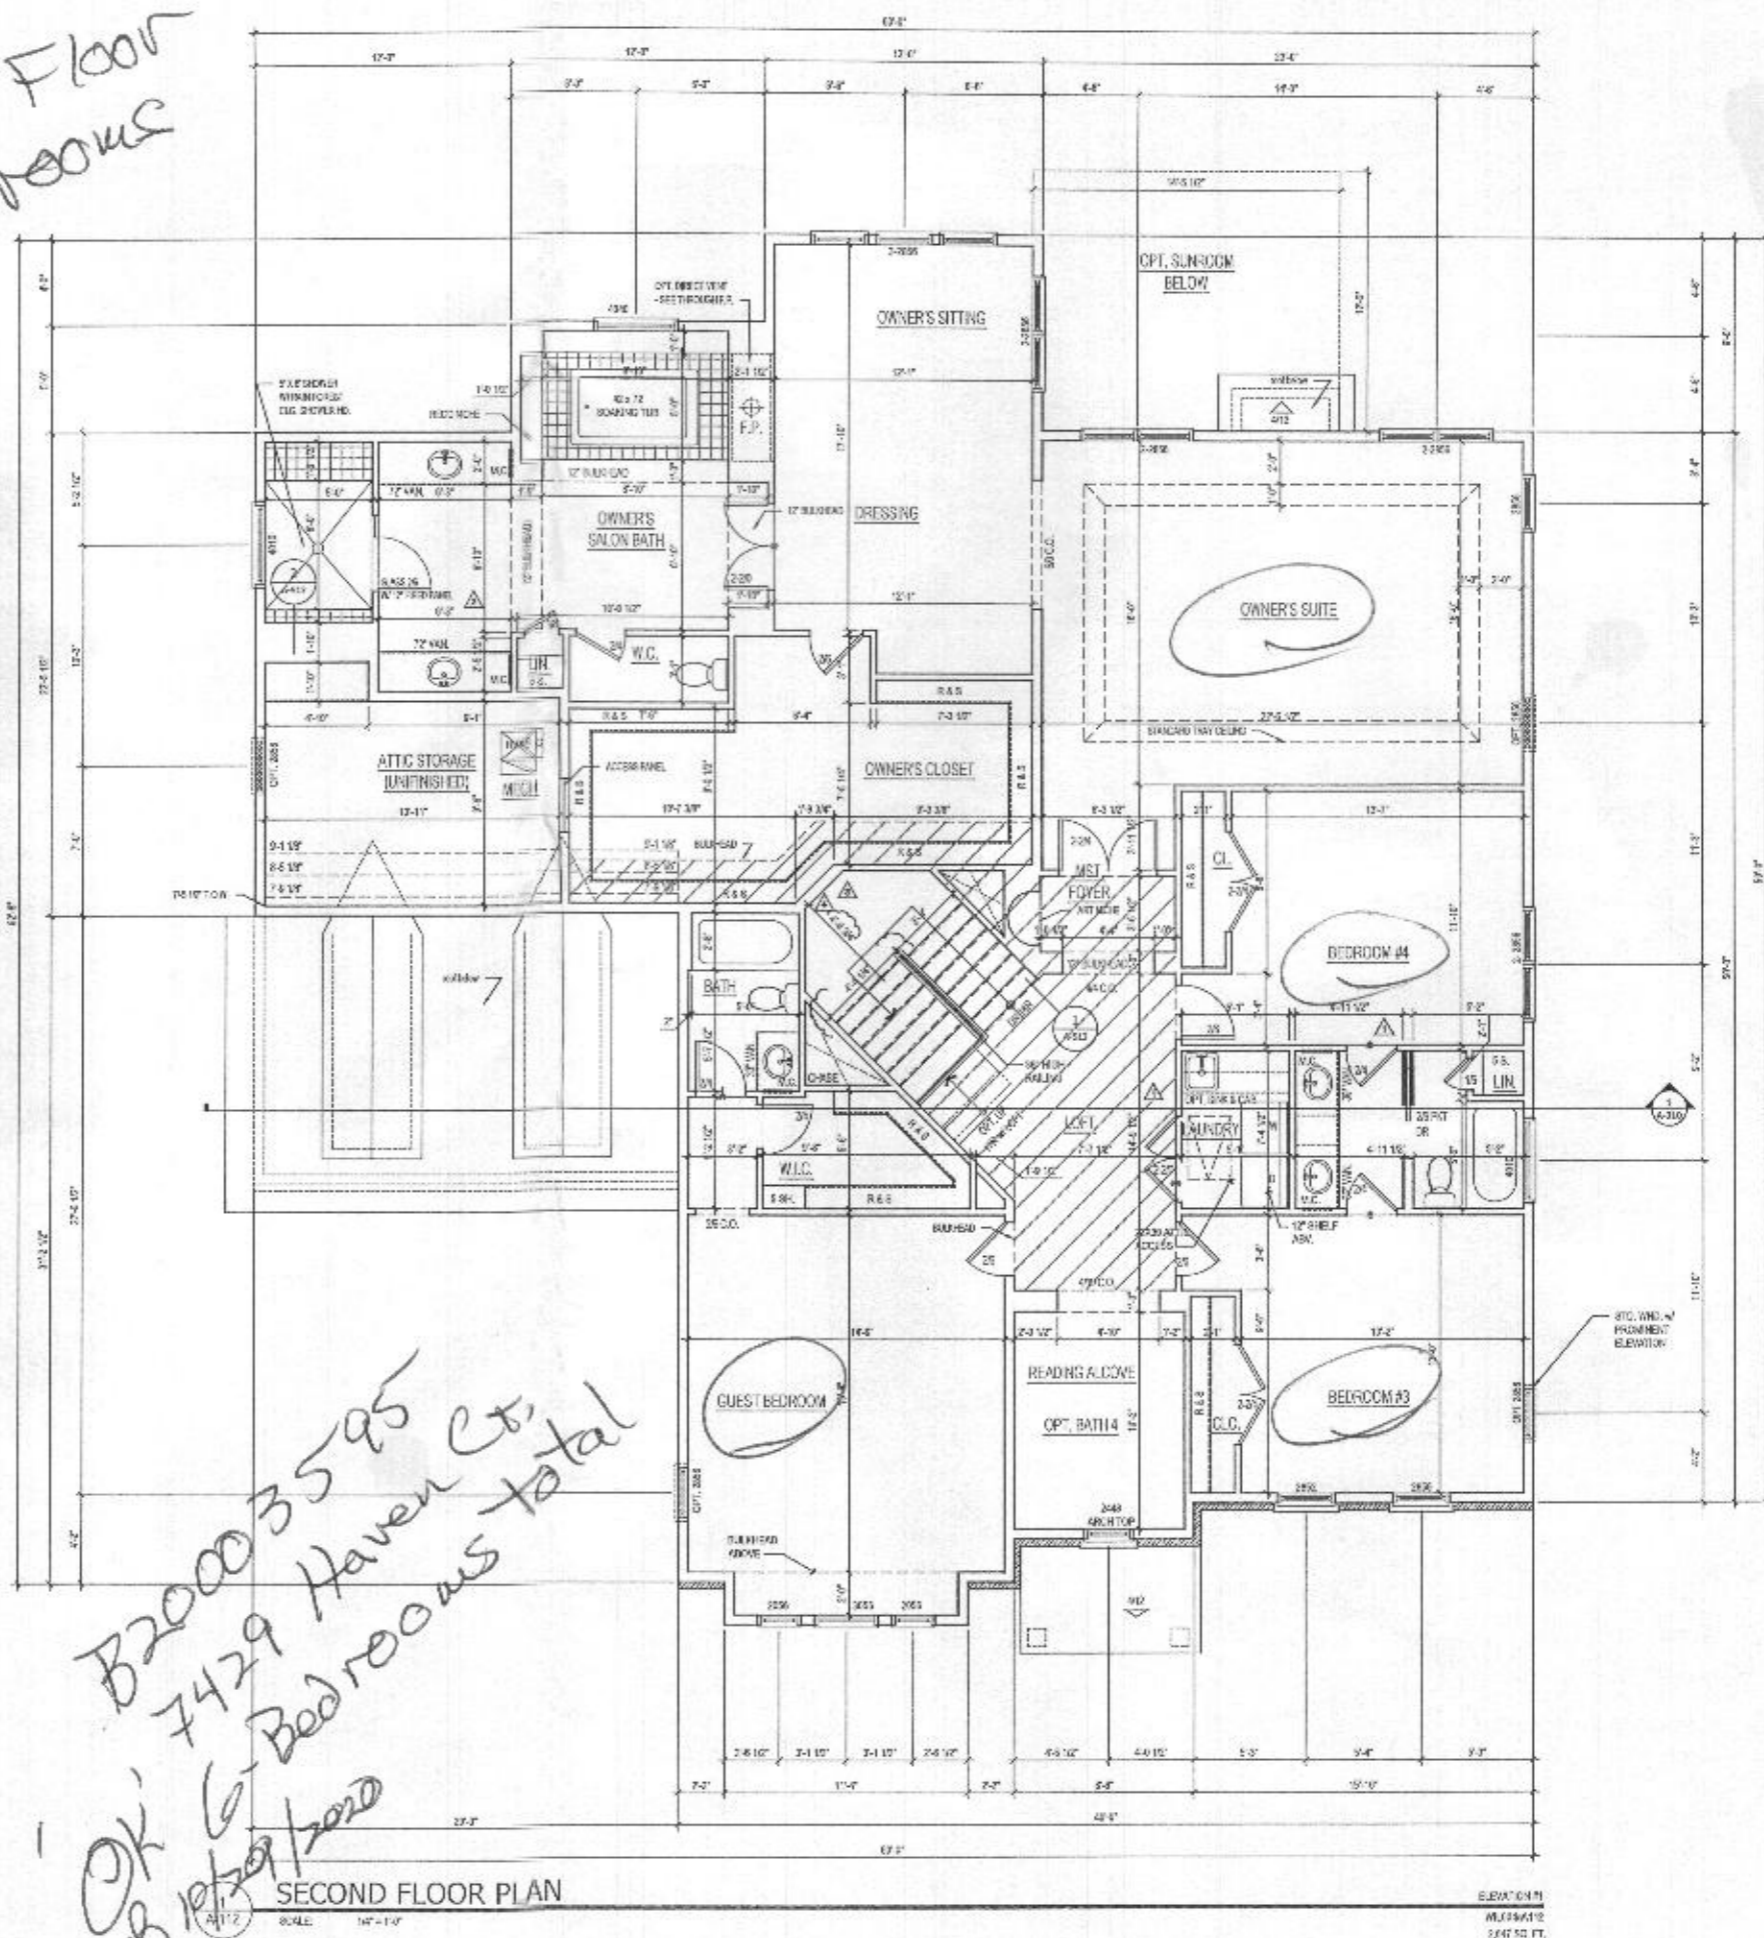

*B20003595
7429 Haven Ct.
6-Bedrooms total
OK
RFB 10/29/2020*

SECOND FLOOR PLAN
SCALE: 1/4" = 1'-0"
ELEVATION 4
WLS04412

ARCH: 001

lessard
DESIGN

8521 Leesburg Pike
Suite 700 | Vienna, VA 22182
P: 713.30.1803 | F: 571.830.1801
www.lessarddesign.com

DATE: 05/20/2020

Professional Certification:
I hereby certify that these documents were prepared or approved by me and that I am a duly Licensed professional architect under the State of Maryland. License No.: 2246
Expiration date: 03/31/2022

OWNER:
The Williamsburg Group
2405 Legends Park Rd.
Arlington, VA 22204
434-507-6886

CONSULTANTS:
STRUCTURAL: KSE ENGINEERING
616 PARK STREET
ROANOKE, VA 24072
P: 754-441-2221


Single Family Homes
Howard County, MD
The Williamsburg Group
GEORGETOWN II
FLOOR PLANS

3	CLIENT COMMENTS	02/24/20
4	CLIENT COMMENTS	03/12/20
5	ISSUE POLARITY	04/22/20
6	CLIENT REVISIONS	05/25/20
7	CLIENT REVISIONS	06/10/20
8	CLIENT REVISIONS	06/23/20
9	ISSUE POLARITY	07/01/20
10	ISSUE POLARITY	07/01/20


PROJECT No: WLS04412
FILE NAME: WLS04412
DESIGNER: WLS04412
CHECKED BY:
PLOT DATE:

A-112

2000 3595
7429 Haven Ct.

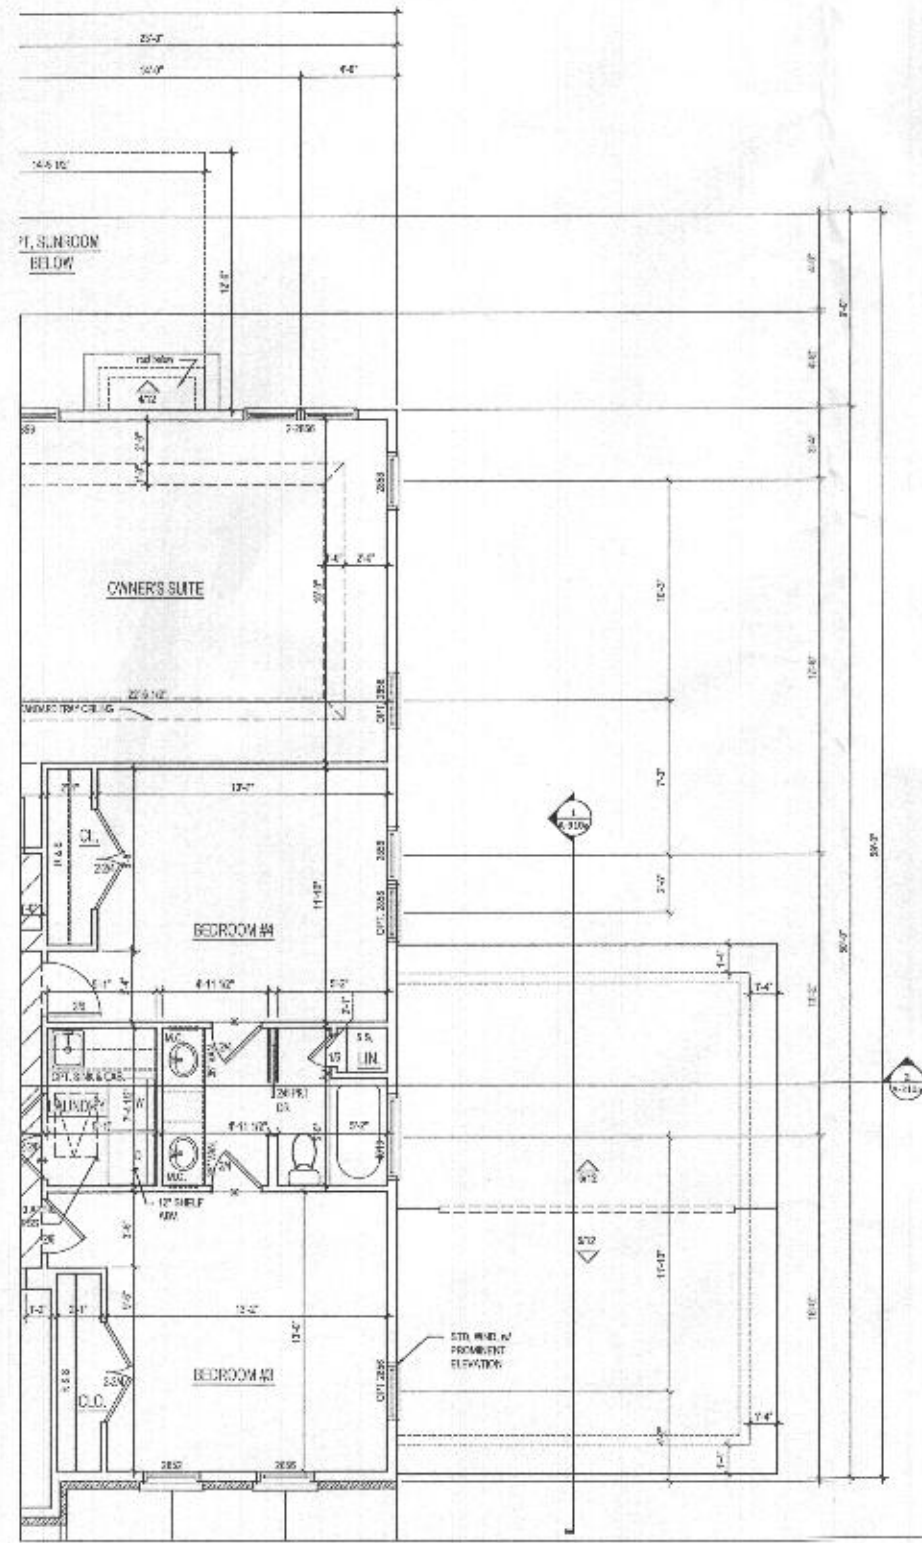

3 SECOND FLOOR PLAN W/ OPT. CONSERVATORY
A-112a SCALE: 1/4" = 1'-0" W.12.04.12

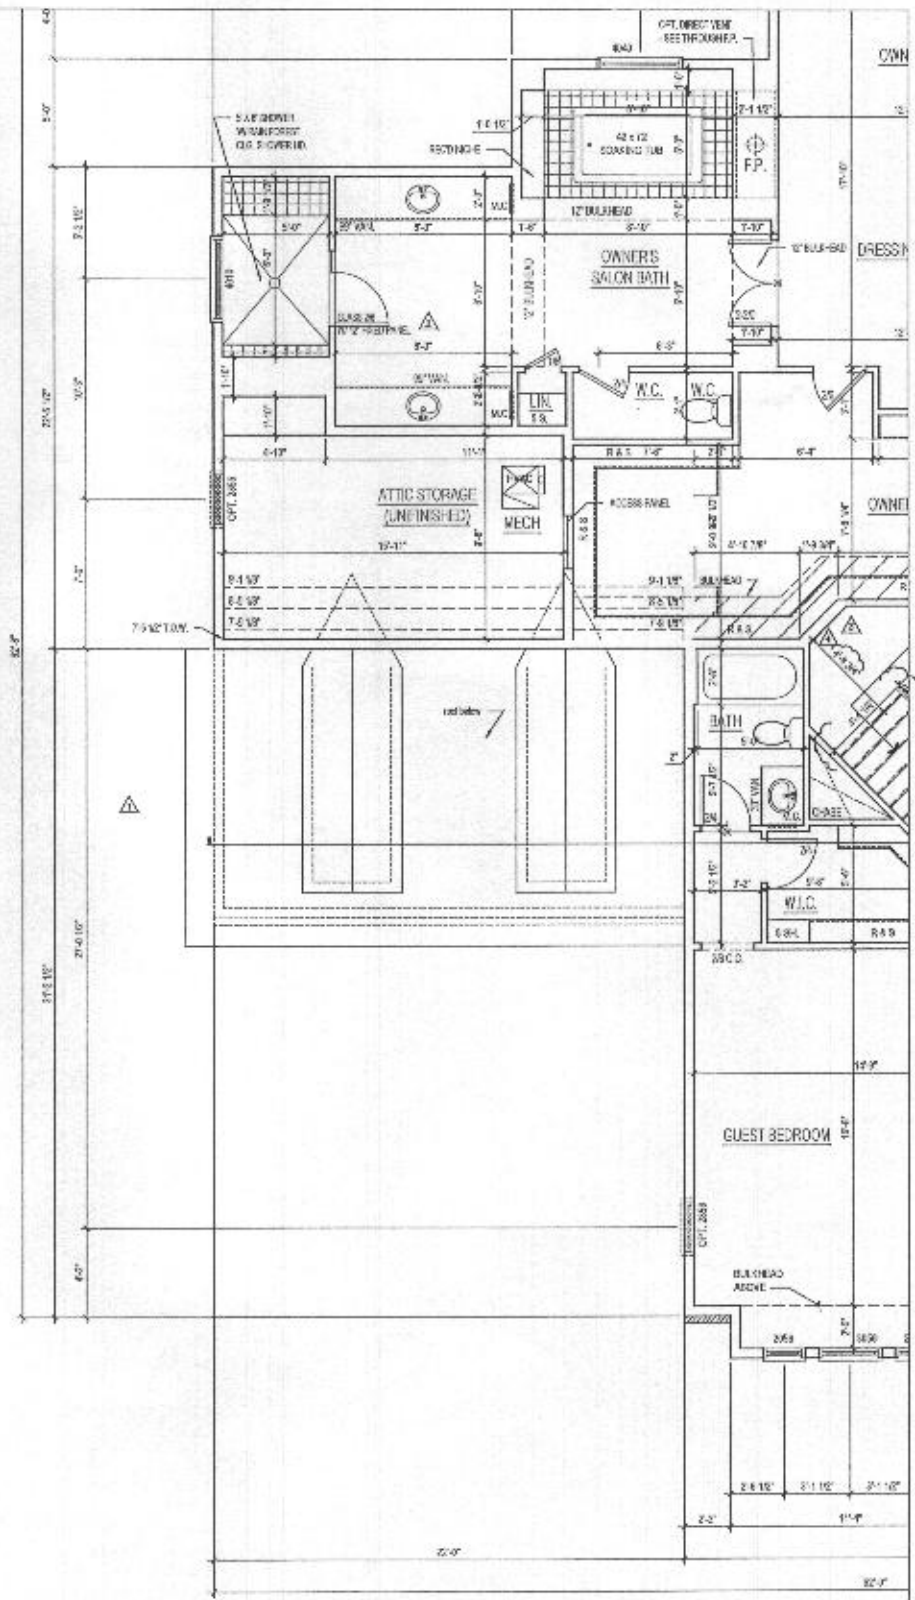

5 SECOND FLOOR PLAN W/ 3-CAR GARAGE OPT.
A-112a SCALE: 1/4" = 1'-0" W.12.04.12



lessard
DESIGN
8571 Leesburg Pike
Suite 700 | Vienna, VA 22182
P: 571.830.1800 | F: 571.830.1801
www.lessarddesign.com

Professional Certification:
I hereby certify that these documents
were prepared or supervised by me and
that I am a duly licensed professional
engineer in the State of Maryland.
License No.: 10299
Expiration Date: 10/30/2019
OWNER:
The Williamsburg Group
5800 Regatta Park Dr.
Chantilly, VA 20151
410-461-0000

CONSULTANT:
STRUCTURAL
KSE ENGINEERING
907 MAIN STREET
ROCKVILLE, VA 20154
703-590-2271


Single Family Homes
Howard County, MD
The Williamsburg Group
GEORGETOWN II
FLOOR PLANS

5	CLIENT COMMENTS	07/20/12
4	CLIENT COMMENTS	06/16/12
	REVISION FOR PERMIT	06/22/12
3	CLIENT REVISIONS	10/24/11
2	CLIENT REVISIONS	09/12/11
1	CLIENT REVISIONS	06/15/11
	ISSUE FOR PERMIT	05/24/11
00	ISSUE FOR PERMIT	DATE


PROJECT No: W.12.04
FILE NAME: W.12.04.12
DATE: 07/20/12
CHECKED BY:
PLOT NO. 1:

A-112a


5	CLIENT COMMENTS	09/22/09
1	CLIENT COMMENTS	06/12/10
1	DESIGN MEETINGS	06/22/10
1	CLIENT COMMENTS	12/24/10
2	CLIENT COMMENTS	08/24/11
1	CLIENT COMMENTS	02/24/12
1	ISSUE RESOLUTION	02/24/12
NO	ISSUE/REVISION	DATE
PROJECT NO.	091095	
FILE NAME:	W1306A112.dwg	
DRAWN BY:		
CHECKED BY:		
PLT DATE:		

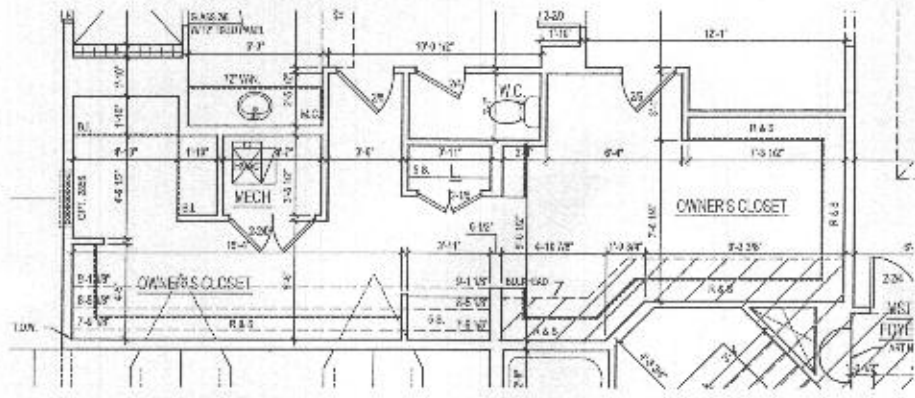


3 W/ OPT. OWNER'S CLOSET
 A-112b SCALE: 1/4" = 1'-0" W1306A112

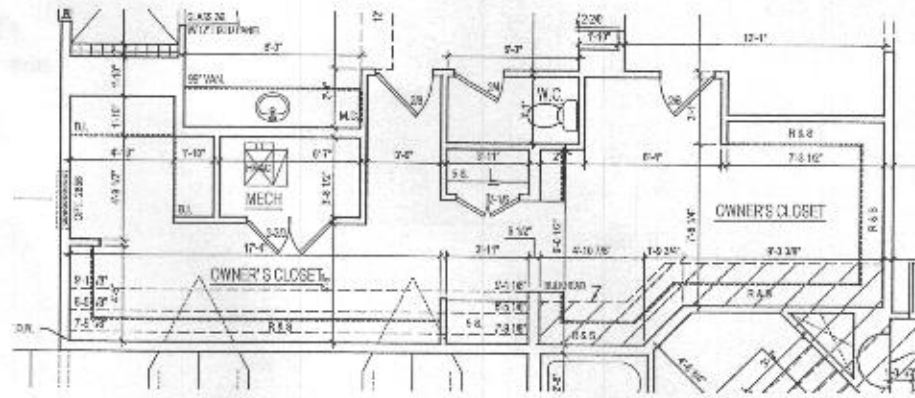

1 W/ OPT. OWNER'S CLOSET W/ 3 CAR GARAGE OPT.
 A-112b SCALE: 1/4" = 1'-0" W1306A112

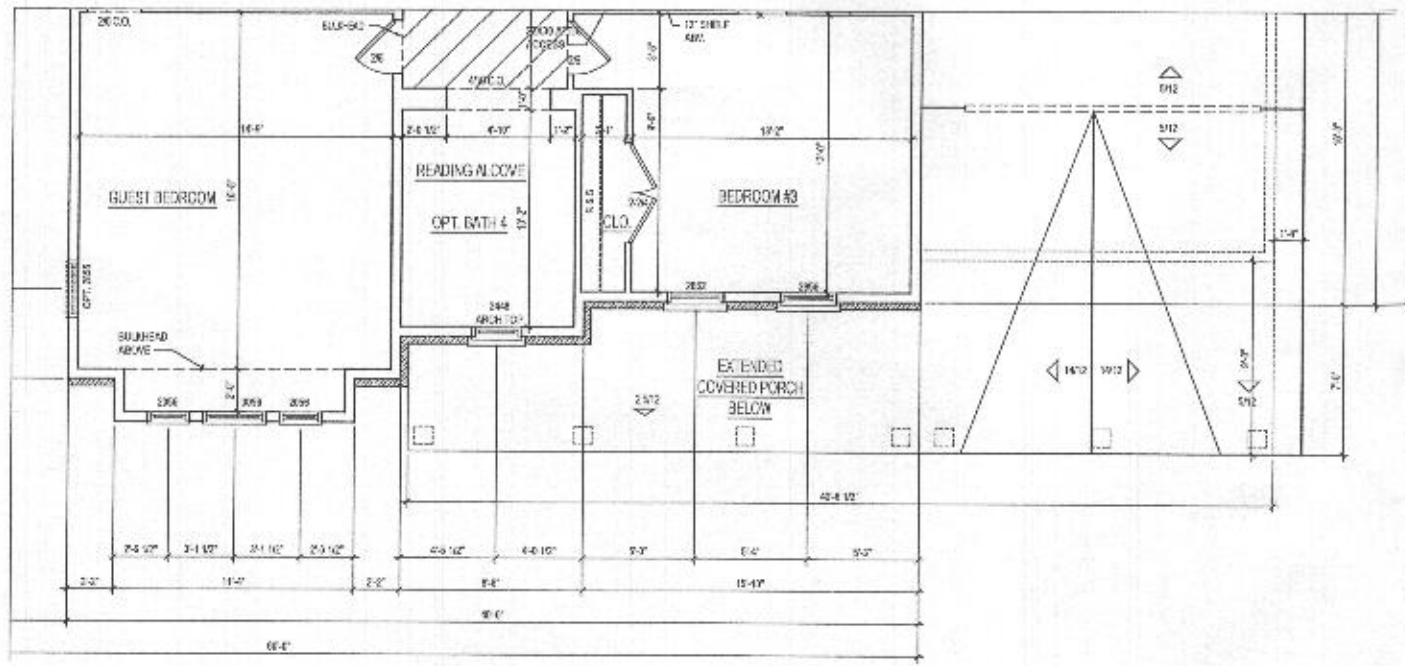

4 SECOND FLOOR PLAN W/ OPT. CONSERVATORY w/ OPT EXTENDED PORCH
 A-112b SCALE: 1/4" = 1'-0" W1306A112

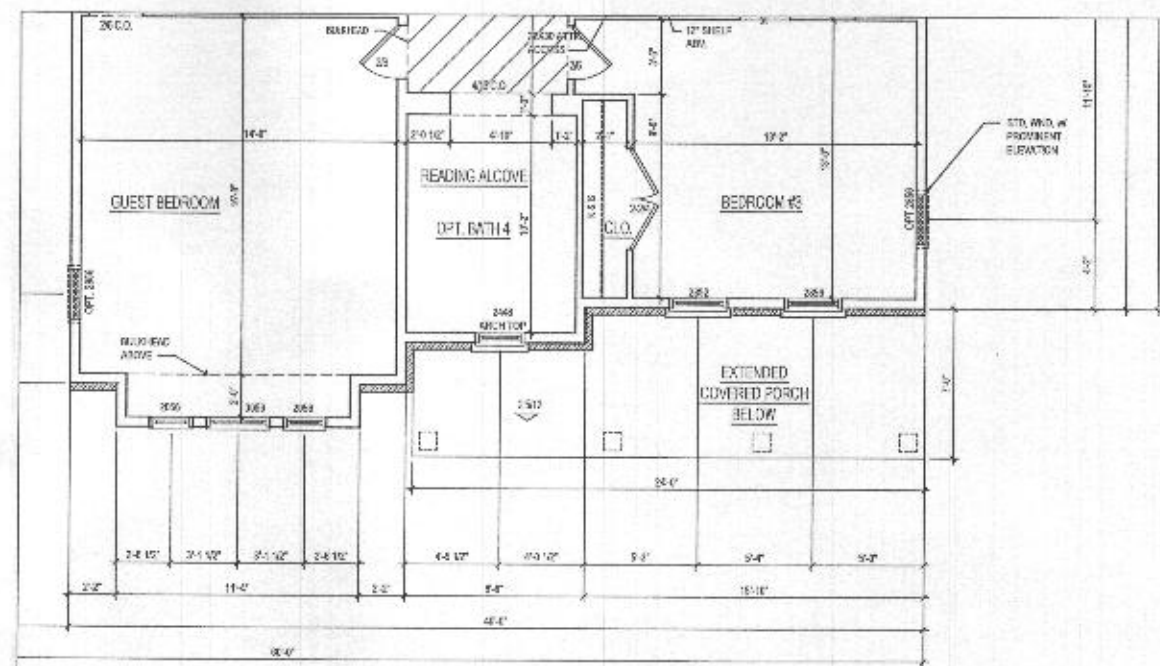


2 SECOND FLOOR PLAN w/ OPT EXTENDED PORCH
 A-112b SCALE: 1/4" = 1'-0" W1306A112

B20003595
 74129 Haven Ct

A-112b



1b
A-210
SCALE: 1/4" = 1'-0"
FRONT ELEVATION - 1A w/ OPT EXTENDED PORCH
W110646210

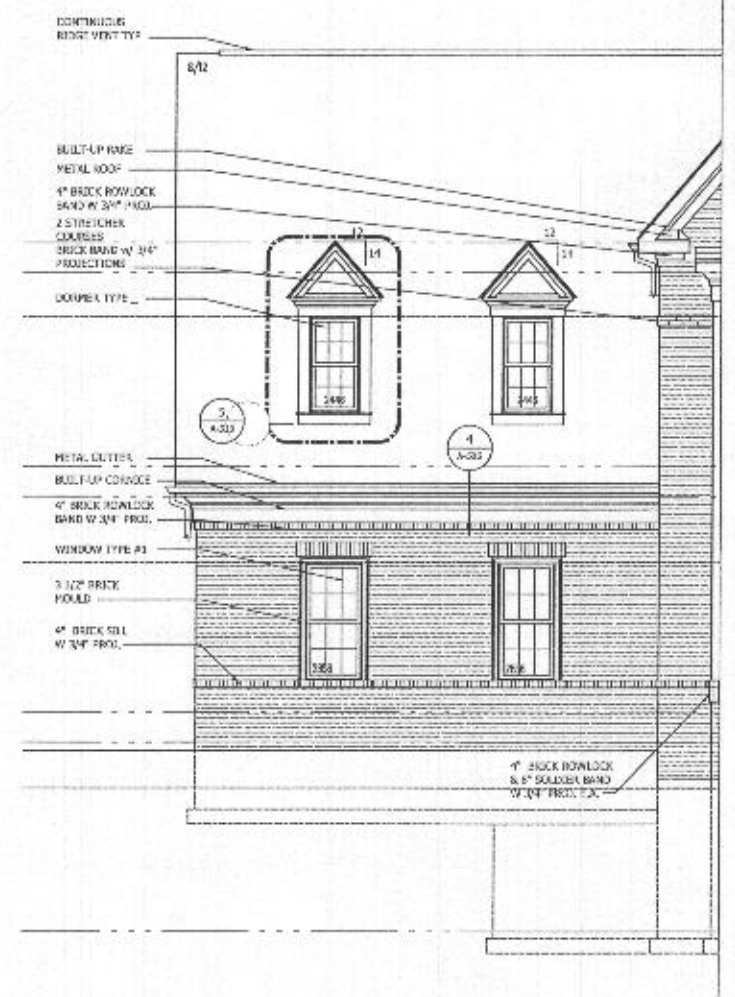

1a
A-210
SCALE: 1/4" = 1'-0"
FRONT ELEVATION - 1A W/ 3 CAR GARAGE OPT.
W110646210



1
A-210
SCALE: 1/4" = 1'-0"
FRONT ELEVATION - 1A
W110646210

lessard DESIGN
8521 Leesburg Pike
Suite 700 | Vienna, VA 22182
P: 571.830.1800 | F: 571.830.1801
www.lessarddesign.com

Professional Certification:
I hereby certify that these documents were prepared or prepared by me and that I am a duly licensed professional and that under the State of Maryland laws, License No. 15476, Expiration Date: 12/31/2024

OWNER:
The Williamsburg Group
4645 Sully Road, Suite 200
Arlington, VA 22204

CONSULTANTS:
STRUCTURAL:
KSE ENGINEERING
125 MAIN STREET
FRODOCKVILLE, VA 22039
P: 202-992-2271

Single Family Homes
Howard County, MD
The Williamsburg Group
GEORGETOWN II
ELEVATIONS

6	CLIENT COMMENTS	02/26/21
4	CLIENT COMMENTS	04/22/21
	REVISION FOR PERMIT	04/22/21
1	CLIENT REVISIONS	04/22/21
2	CLIENT REVISIONS	04/22/21
1	CLIENT REVISIONS	04/22/21
	ISSUE FOR PERMIT	04/22/21
001	3646 REVISION	04/22/21

PROJECT No: W110646210
FILE NAME: W110646210.dwg
DRAWN BY:
CHECKED BY:
DATE: 04/22/21

A-210

