

6/18/85
1 PM related? WPL - ~~7/17/85~~ 7/17/85
6-18-85
Approved
SABE

PERMIT

P. 35712
A. 22373

SEWAGE DISPOSAL SYSTEM
MARYLAND STATE DEPARTMENT OF HEALTH

HOWARD COUNTY
BUREAU OF ENVIRONMENTAL HEALTH
992-2330

ELLCOTT CITY
DISTRICT _____
DATE 6-5-85

INDEXED

Paul Schissler - South Carroll Backhoe Service

IS PERMITTED TO INSTALL ALTER _____

ADDRESS 4410 Salem Bottom Rd, Westminster, MD 21157 PHONE 875-4197

SUBDIVISION The Heritage II ROAD PIONEER CIRCLE LOT 26

PROPERTY OWNER Henry Knott Builders, Inc.

ADDRESS _____

IF GARBAGE GRINDER IS USED INCREASE SEPTIC TANK CAPACITY BY 50% AND ABSORPTION AREA BY 22%.

GARBAGE GRINDER? YES _____ NO

SEPTIC TANK CAPACITY 1000 GALLONS NUMBER OF BEDROOMS 3 200

B.P. SFD
#63042

TRENCH (ES) - Trench to be 2 ft. wide. Inlet 4 ft. below original grade. Bottom maximum depth 10 ft. below original grade. Effective area begins at 4 ft below original grade. 6 ft. of stone below distribution pipe. NOTE. (1) No trench to exceed 100 feet in length. (2) If more than one trench used, a distribution box is required. (3) Trenches to be installed on level ground. (4) Call for inspection of trench before gravel is installed. (5) Provide 6"-8" diameter cleanout and cap to grade or above on septic tank and drywell. Start the first trench 40 ft. from the left lot line and 140 ft. from the front lot line. Run trench(s) along level ground toward right side of lot.

PLANS APPROVED BY Craig Williams DATE 6-5-85

COVER NO WORK UNTIL INSPECTED AND APPROVED.

NEITHER THE HOWARD COUNTY COUNCIL NOR THE HEALTH DEPARTMENT IS RESPONSIBLE FOR THE SUCCESSFUL OPERATION OF ANY SYSTEM.

NOTE: IF TRENCH IS USED CALL FOR INSPECTION BEFORE AND AFTER PLACING GRAVEL IN TRENCH.

NOTE: NO DRY WELL SHALL EXCEED 15 FOOT IN DIAMETER. NO ABSORPTION TRENCH TO EXCEED 100 FEET IN LENGTH.

NOTE: ALL PIPE FROM HOUSE TO SEPTIC TANK MUST BE CAST IRON OR SCHEDULE 40 PVC OR ABS.

PERMIT VOID AFTER THREE YEARS.


NOTE: INSTALL STAND PIPE ON SEPTIC TANK AND DRY WELL. STAND PIPES MUST BE 6 INCHES IN DIAMETER. CAST IRON, CONCRETE OR TERRA COTTA, OR PVC OR ABS ACCEPTED. IF TOP OF SEPTIC TANK IS DEEPER THAN 3 FEET MANHOLE TO GRADE REQUIRED.

"INSTALLER IS RESPONSIBLE FOR OBTAINING FINAL APPROVAL ON THIS PERMIT

CALL 992-2330 FOR INSPECTION OF SEPTIC SYSTEMS.

EH - 2-1082

A22373

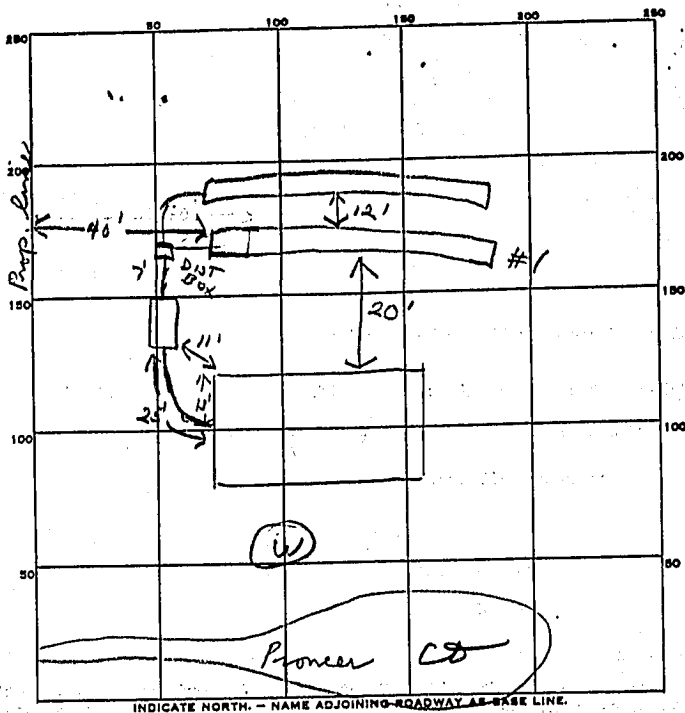

PERMIT CARD _____

SEPTIC TANK, LEVEL ✓ 1000 gal CLEANOUTS ✓ 5T

DISTRIBUTION BOX, LEVEL _____

TILE FIELD, DEPTH 10 FT. TRENCH WIDTH 2 FT.

GRAVEL DEPTH 6 6 IN. TOTAL LENGTH 140 FT.

NUMBER OF TRENCHES 2 TOTAL BOTTOM AREA 840 ~~sq~~

SEEPAGE PITS, INSIDE DIAMETER _____ FT. DEPTH BELOW INLET _____ FT.

ABSORBENT AREA 840 SQ. FT.

REMARKS 6/17/85 OK to add stone in #1 trench

6/17/85 OK to add stone in #2 trench *JJ*

6-18-85 OK TO DO ALL WORK

DATE SYSTEM APPROVED 6-18-85

INSPECTOR S Abel

22373

May 8, 1986

Mr. Roy Chrest
14205 Pioneer Circle
Glenelg, Maryland 21737

Dear Mr. Chrest:

The water sample recently submitted for testing was free of coliform and fecal coliform bacteria at the time of sampling and is bacteriologically safe for drinking.

FINAL CERTIFICATE OF POTABILITY

This certifies that all sampling requirements of COMAR 10.17.13 "Well Regulations" have been met for the water supply system installed under permit(s) HO-81-0886.

March 17, 1986
Date of Final Sampling

March 21, 1986
Date of Acceptance

Craig Williams, P.E.
Craig Williams, Director
Water and Sewerage Program

CW/JS:JR

Date Well Approved: 3/06/85
Date Public Approved: 6/18/85
Water Sample Dates: 11/14/85
3/17/86