

PERMIT NUMBER: B

20005914

DATE ACCEPTED:



RESIDENTIAL BUILDING PERMIT APPLICATION

HOWARD COUNTY DEPARTMENT OF INSPECTIONS, LICENSES, AND PERMITS

3430 COURT HOUSE DRIVE, ELLICOTT CITY, MD 21043 - PHONE: (410) 313-2455 OPTION #4

www.howardcountymd.gov

BUILDING SITE ADDRESS REQUIRED

Street Address: 11809 Collic Ct, City: Fulton, State: MD, Zip Code: 20759, Subdivision/Village/Complex Name: 2001, SDP/WP/BA #: , Lot: 6, Tax Map: 0041, Parcel: 0078, Grading Permit #:

DESCRIPTION OF WORK REQUIRED

Existing Use: , Proposed Use: 16x24 Pavilion, Estimated Cost: \$ 5,000.00, Trade Work to Be Completed (Separate Permits Required): [] Mechanical (HVACR) [] Electrical [] Plumbing [] None, installing 16x24 covered structure on existing pad approx. SAT 384

PROPERTY OWNER INFORMATION REQUIRED

Owner(s) Name(s) (As it appears on tax records): Alexander Abawi, Primary Residence: [X] Yes [] No, Owner's Street Address: 11809 Collic Ct, City: Fulton, State: MD, Zip Code: 20759, Phone: 531 205 9160, Email: alex-abawi@gmail.com

APPLICANT NAME REQUIRED - INDIVIDUAL WHO SIGNS THIS APPLICATION

Business Name: Homeowner, Contact Name: , Street Address: , City: [same as above], State: , Zip Code: , Phone: , Email:

CONTRACTOR INFORMATION REQUIRED

Business Name: , Licensee's Name: Homeowner, License #: , Street Address: , City: , State: , Zip Code: , Phone: , Email:

ARCHITECT/ENGINEER INFORMATION INDIVIDUAL WHO SIGNED PLANS, IF APPLICABLE

Business Name: , Name: , Street Address: n/a, City: , State: , Zip Code: , Phone: , Email:

BUILDING CHARACTERISTICS REQUIRED

Primary Structure: [] SF Dwelling [] SF Townhouse [] SF Duplex [] Mobile Home [] Multi-Family Dwelling (MF*) Condo: [] Yes [X] No, Utilities: [X] Electric [X] Gas, Water Supply: [] Public [X] Private (Well), Sewage Disposal: [] Public [X] Private (Septic), Heating System: [] Electric [X] Natural Gas [] Propane [] Other, Roadside Tree Project: [] No [] Yes: #, Sprinkler System: [] NFPA 13 [] NFPA 13R [X] NFPA 13D [] None, Fire Alarm System: [] Yes [X] No [] Voice Evac

ADDITIONAL RESIDENTIAL INFORMATION (PLEASE SELECT/COMPLETE ALL THAT APPLY)

Model Name & Options: # of Bedrooms (SF): 5, # of efficiency units (MF*): , # of 1 BR (MF*): 5, # of 2 BR (MF*): , # of 3 BR (MF*): , # Rooms: 5, # Full Baths: , # Half Baths: , # Fireplaces: , Garage/Carport Info: [] Attached Garage [] Detached Garage [] Integral Garage [] Carport [] None, Basement/Foundation Info: [] Slab on Grade [] Post & Pier [] Unfinished Basement [X] Finished Basement: [] Full or [] Partial, 1st Fl Width: , 1st Fl Depth: , 2nd Fl Width: , 2nd Fl Depth: , Bsmt Width: , Bsmt Depth: , Energy Method: [] Prescriptive [] Performance [] UA Alternative [] ERI, Gross Area: sq ft, Occupiable Area: sq

AGREEMENT / DISCALIMER REQUIRED

THE UNDERSIGNED HEREBY CERTIFIES AND AGREES AS FOLLOWS: (1) THAT HE/SHE IS AUTHORIZED TO MAKE THIS APPLICATION; (2) THAT THE INFORMATION IS CORRECT; (3) THAT HE/SHE WILL COMPLY WITH ALL REGULATIONS OF HOWARD COUNTY WHICH ARE APPLICABLE THERETO; (4) THAT HE/SHE WILL PERFORM NO WORK ON THE ABOVE REFERENCED PROPERTY NOT SPECIFICALLY DESCRIBED IN THIS APPLICATION; (5) THAT HE/SHE GRANTS COUNTY OFFICIALS THE RIGHT TO ENTER ONTO THIS PROPERTY FOR THE PURPOSE OF INSPECTING THE WORK PERMITTED AND POSTING NOTICES.

APPLICANT'S ORIGINAL SIGNATURE: [Signature], DATE SIGNED: 3/17/20

FOR OFFICE USE ONLY


CHECKS PAYABLE TO: DIRECTOR OF FINANCE OF HOWARD COUNTY

AGENCIES REQUIRED/APPROVALS:

[] PR [] DPZ [] DED [X] Health [] SHA [] CID

SUBMITTAL FEES: , PAYMENT: CD # 103, ACCEPTED BY: [Signature]

THIS PLAT IS OF BENEFIT TO A CONSUMER ONLY INsofar AS IT IS REQUIRED BY THE LENDER OR TITLE INSURANCE COMPANY OR IT'S AGENT IN CONNECTION WITH CONTEMPLATED TRANSFER, FINANCING OR REFINANCING. THIS PLAT IS NOT TO BE RELIED UPON FOR THE ESTABLISHMENT OR LOCATION OF FENCES, GARAGES, BUILDINGS OR FUTURE IMPROVEMENTS. THIS PLAT DOES NOT PROVIDE THE ACCURATE IDENTIFICATION OF PROPERTY BOUNDARY LINES, BUT SUCH IDENTIFICATION MAY NOT BE REQUIRED FOR THE TRANSFER OF TITLE OR SECURING FINANCING OR REFINANCING. THIS PLAT CONTAINS A TOLERANCE OF ACCURACY OF 0.2' MORE OR LESS.

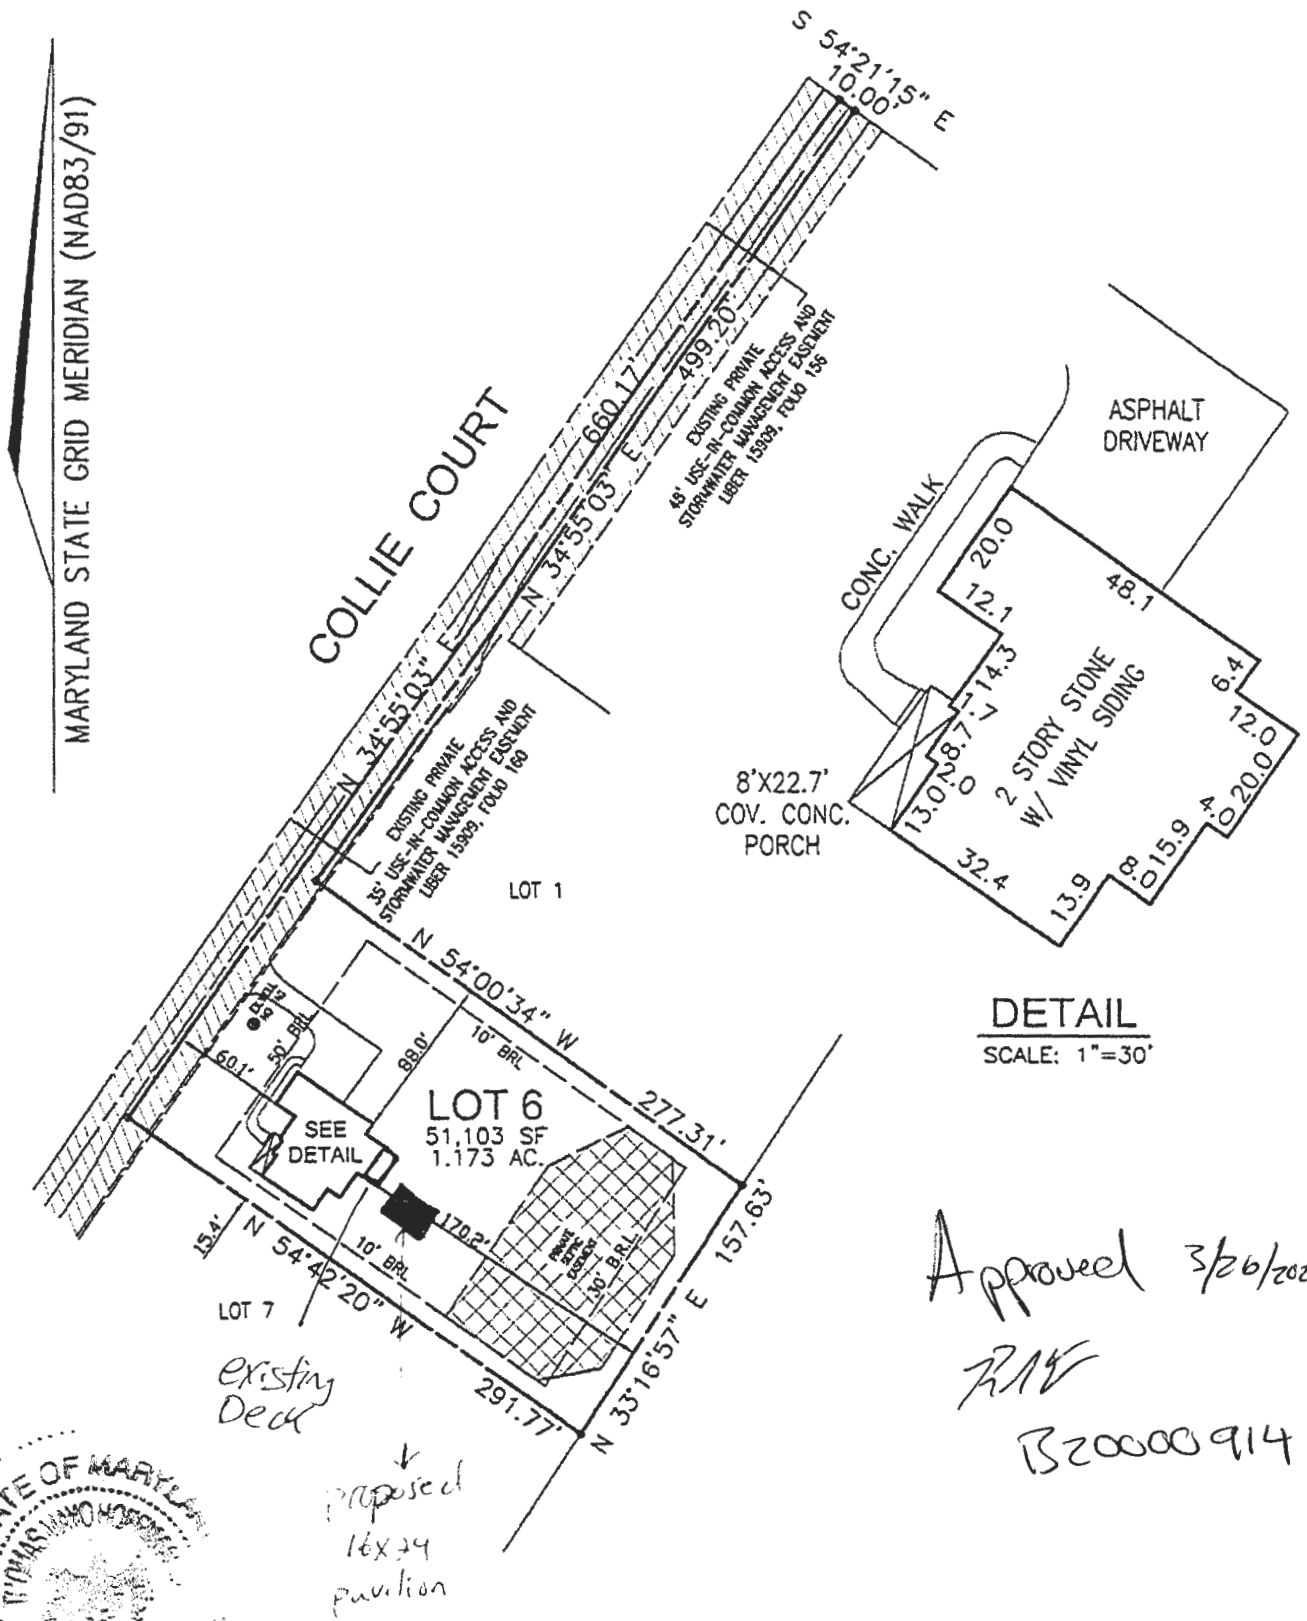

DETAIL
SCALE: 1"=30'

Approved 3/26/2020
RHV
B20000914



I HEREBY CERTIFY TO THE BEST OF MY KNOWLEDGE, INFORMATION AND BELIEF THAT THE IMPROVEMENTS ARE LOCATED AS SHOWN AND THERE ARE NO ENCROACHMENTS EXCEPT AS SHOWN.
Thomas M. Hoffman Jr.
1.09.17
THOMAS M. HOFFMAN JR., PROPERTY LINE SURVEYOR #267 DATE

PROFESSIONAL CERTIFICATION: I HEREBY CERTIFY THAT THESE DOCUMENTS WERE PREPARED BY ME OR UNDER MY RESPONSIBLE CHARGE, AND THAT I AM A DULY LICENSED PROPERTY LINE SURVEYOR UNDER THE LAWS OF THE STATE OF MARYLAND, LICENSE NO. 267, EXPIRATION DATE JULY 28, 2018.

SCALE 1" = 100'	DATE 01/05/2017	ROBERT H. VOGEL ENGINEERING, INC. ENGINEERS - SURVEYORS - PLANNERS 8407 MAIN STREET ELLCOTT CITY, MARYLAND 21043 TEL: 410-461-7666 FAX: 410-461-8961	FINAL LOCATION DRAWING 11809 COLLIE COURT LOT 6 FULTON MANOR VALLEY PLAT NO. 23140 FIFTH ELECTION DISTRICT HOWARD COUNTY, MARYLAND
DRAWN BY B.D.A.	CHECKED BY T.M.H.		
PLAT NUMBER 23139-23141	JOB NUMBER 14-24.00		